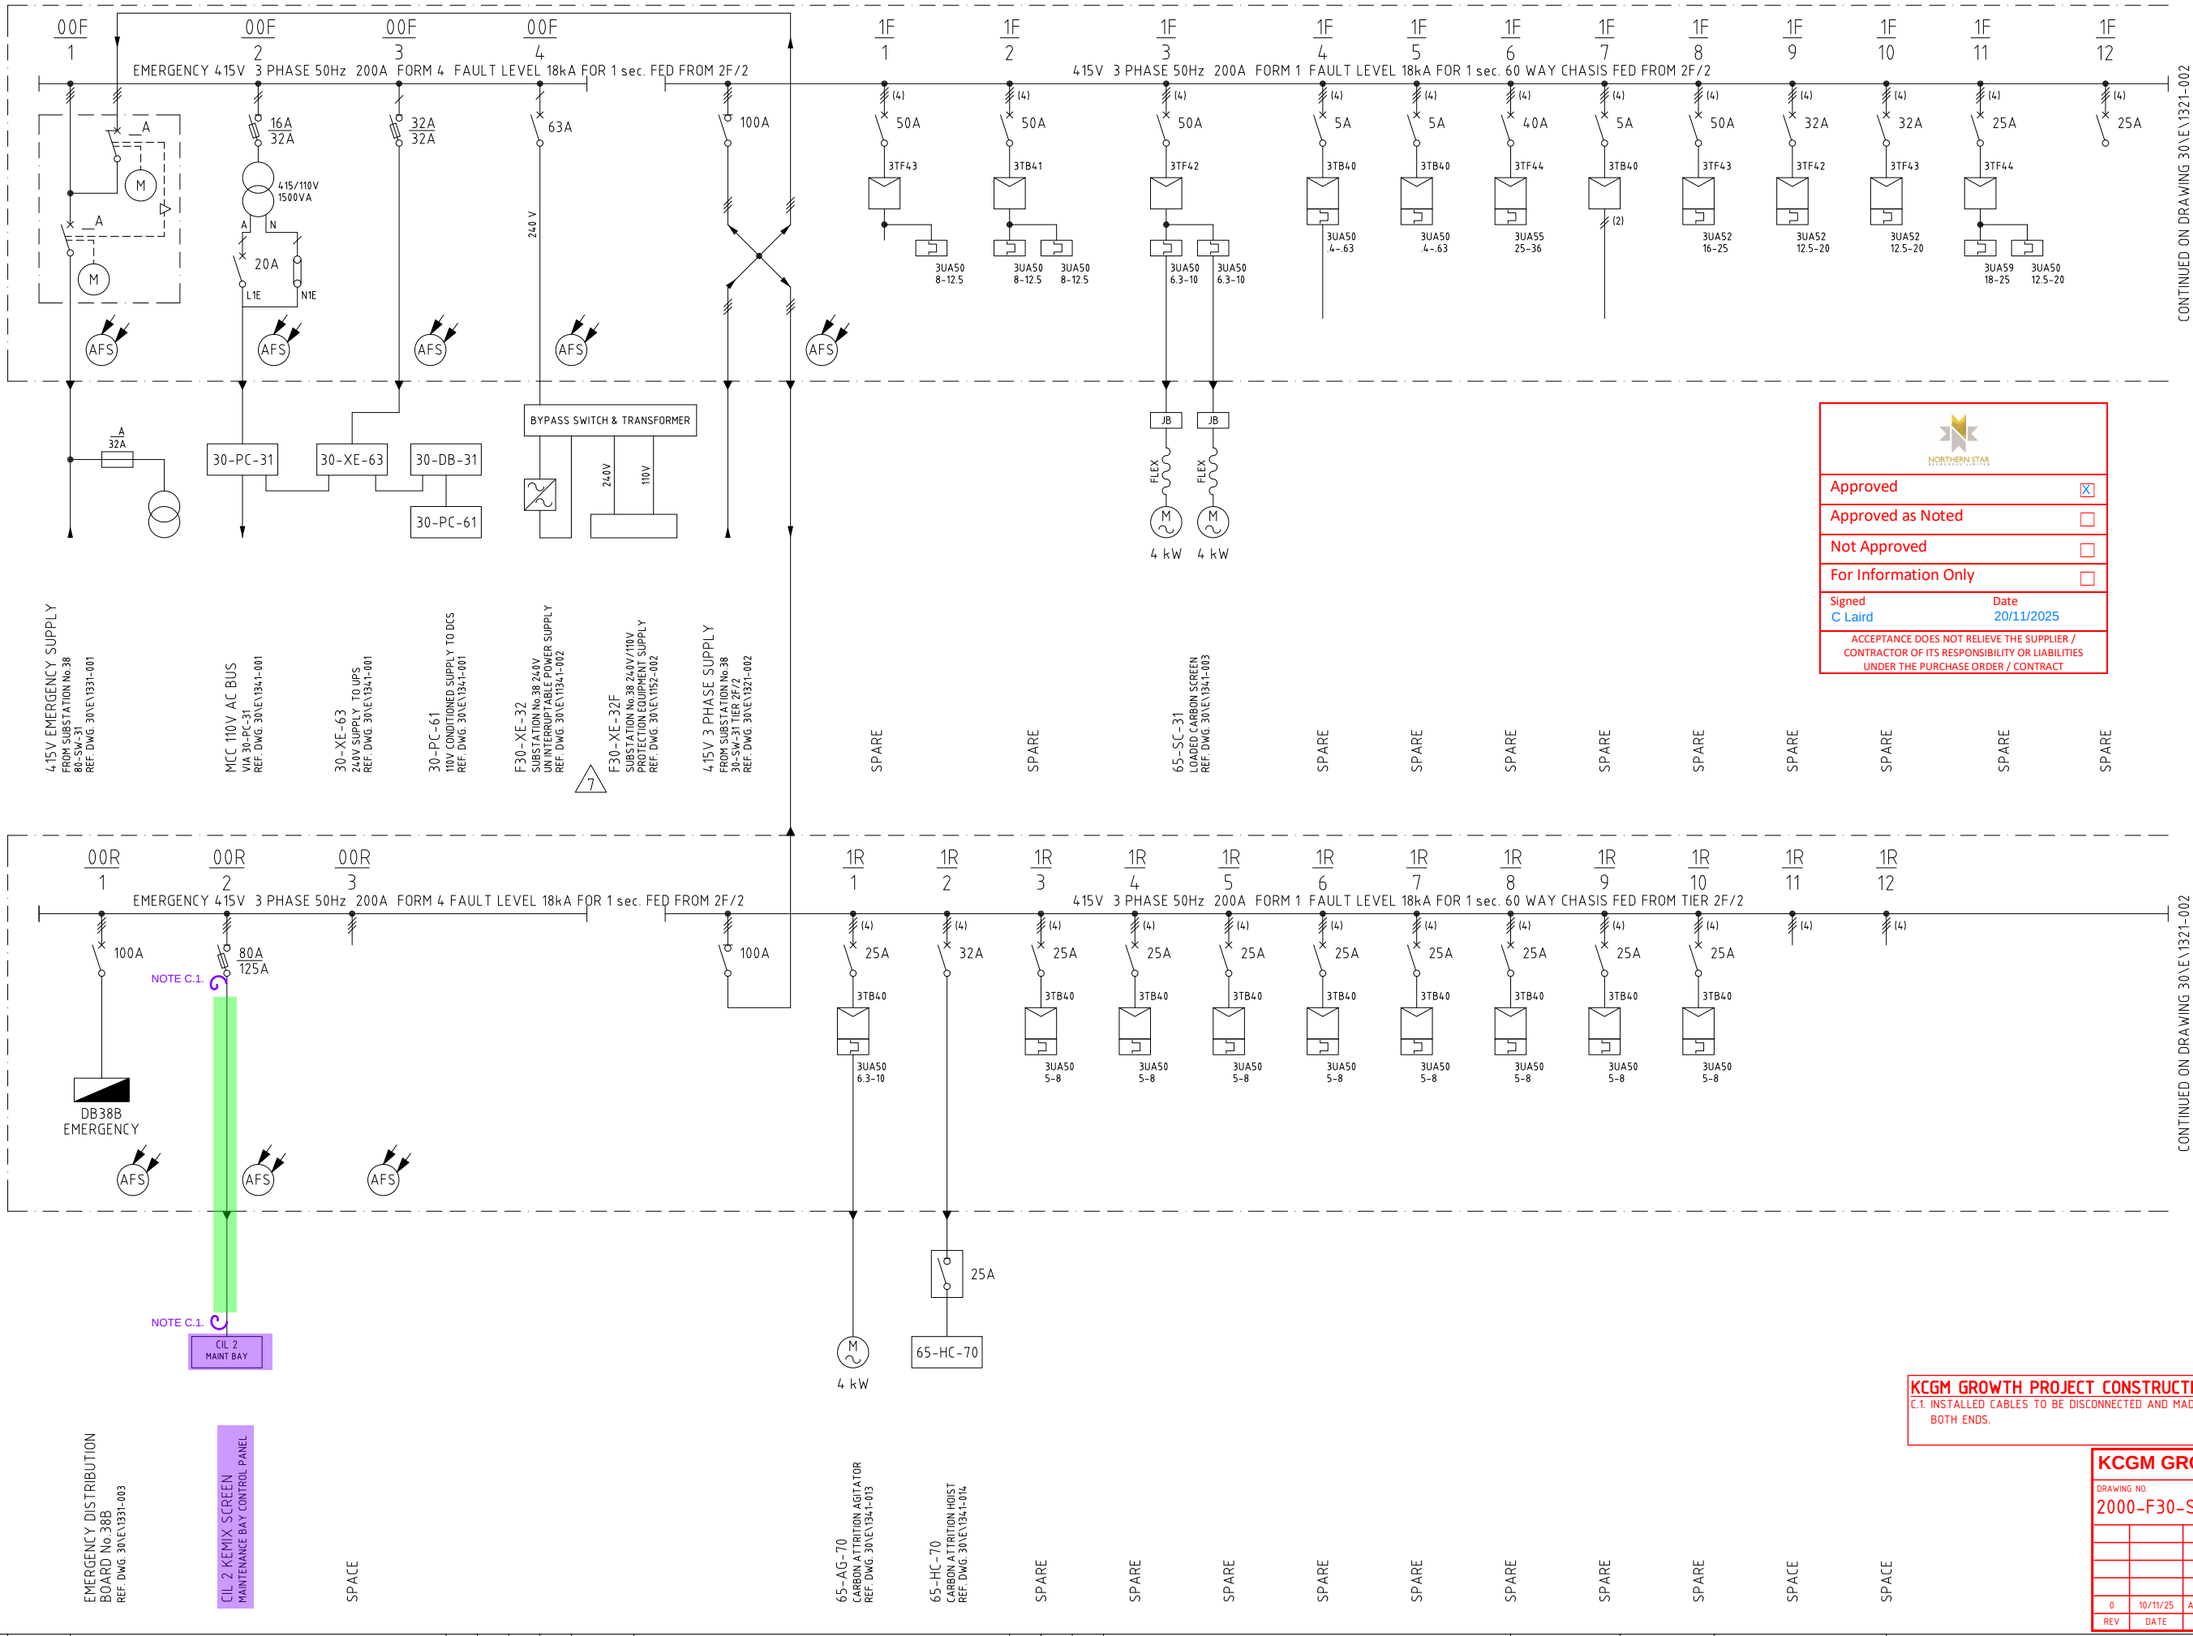



Approved	X
Approved as Noted	
Not Approved	
For Information Only	
Signed: C Laird	Date: 20/11/2025

ACCEPTANCE DOES NOT RELIEVE THE SUPPLIER / CONTRACTOR OF ITS RESPONSIBILITY OR LIABILITIES UNDER THE PURCHASE ORDER / CONTRACT

LEGEND

LOCATION

SUB STATION 38
30-SW-31

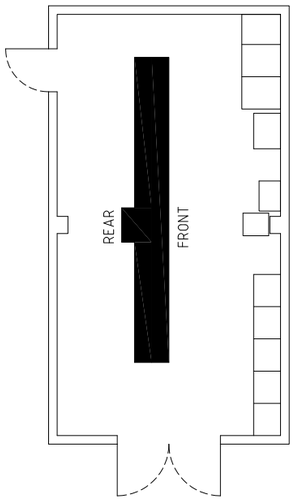

NOTES

1. WHERE DRIVES & FEEDERS REQUIRE 2 OFF CIRCUIT BREAKER AUXILLARIES THEN AN ADDITIONAL POLE SPACE IS REQUIRED.
   No. OF POLES USED SHOWN IN BRACKETS.
2. ALL AFS (ARC FLASH SENSORS) ARE CONNECTED TO THE ARC FLASH RELAY VIA I/O UNITS

LEGEND
- EXISTING
- NON-EXISTENT
- STAGE 1 - NEW
- STAGE 1 - REMOVE
- STAGE 1 - DECOMMISSIONED (OTHERS)
- STAGE 2 - NEW
- STAGE 2 - REMOVE
- STAGE 2 - DECOMMISSIONED (OTHERS)

KCGM GROWTH PROJECT CONSTRUCTION NOTES

C.1. INSTALLED CABLES TO BE DISCONNECTED AND MADE SAFE AT BOTH ENDS.

KCGM GROWTH PROJECT

DRAWING NO.
2000-F30-SLD-EL-10202

REV	DATE	DESCRIPTION	CHECK	TECH APP
0	10/11/25	APPROVED FOR CONSTRUCTION		DM

MK	DATE	REVISION	BY	CKD	APP
8	11/05/20	ISSUED FOR CONSTRUCTION	[redacted]	AA	[redacted]
7B	12/03/20	UPDATED WITH UPS	JJ	DS	[redacted]
7A	27/03/20	NEW UPS INSTALLED AT 00F/4	[redacted]	AA	
6A	21/08/19	2019 S.L.D. UPDATE PROJECT "AS BUILT"- FIELD REVIEW	BH	RH	EB
5	17/07/18	ARC FLASH SENSORS INSTALLED	[redacted]	JMR	[redacted]
4	13/08/03	1R/2 CB ALTERED TO 32A			
3	30/06/03	APPROVED FOR CONSTRUCTION - PROJECT 155/04861	[redacted]	DBG	[redacted]
2	20/05/03	ISSUED FOR TENDER - PROJECT No.155-04861	[redacted]	LD	
1	01/09/01	ASBUILD MODIFICATIONS ADDED	[redacted]	AB	[redacted]

REFERENCE DRAWINGS | DWG NO. | PROJ. FILE #.

SCALE	NTS	
DRAWN	[redacted]	01/09/01
DESIGNED	KCGM	01/09/01
CHECKED	KCGM	01/09/01
APPROVED	KCGM	01/09/01
PROJ.APP	KCGM	01/09/01

FIMISTON PLANT
LEACH ADSORPTION & THICKENING
SUBSTATION No. 38 MCC 30-SW-31
SINGLE LINE DIAGRAM

SIZE	DRAWING NUMBER	REV
A1	30\E\1321-001	8

KALGOORLIE CONSOLIDATED GOLD MINES PTY. LTD. ABN 009 377 619 003