
CONTINUED FROM DWG. 34\E\0041-009

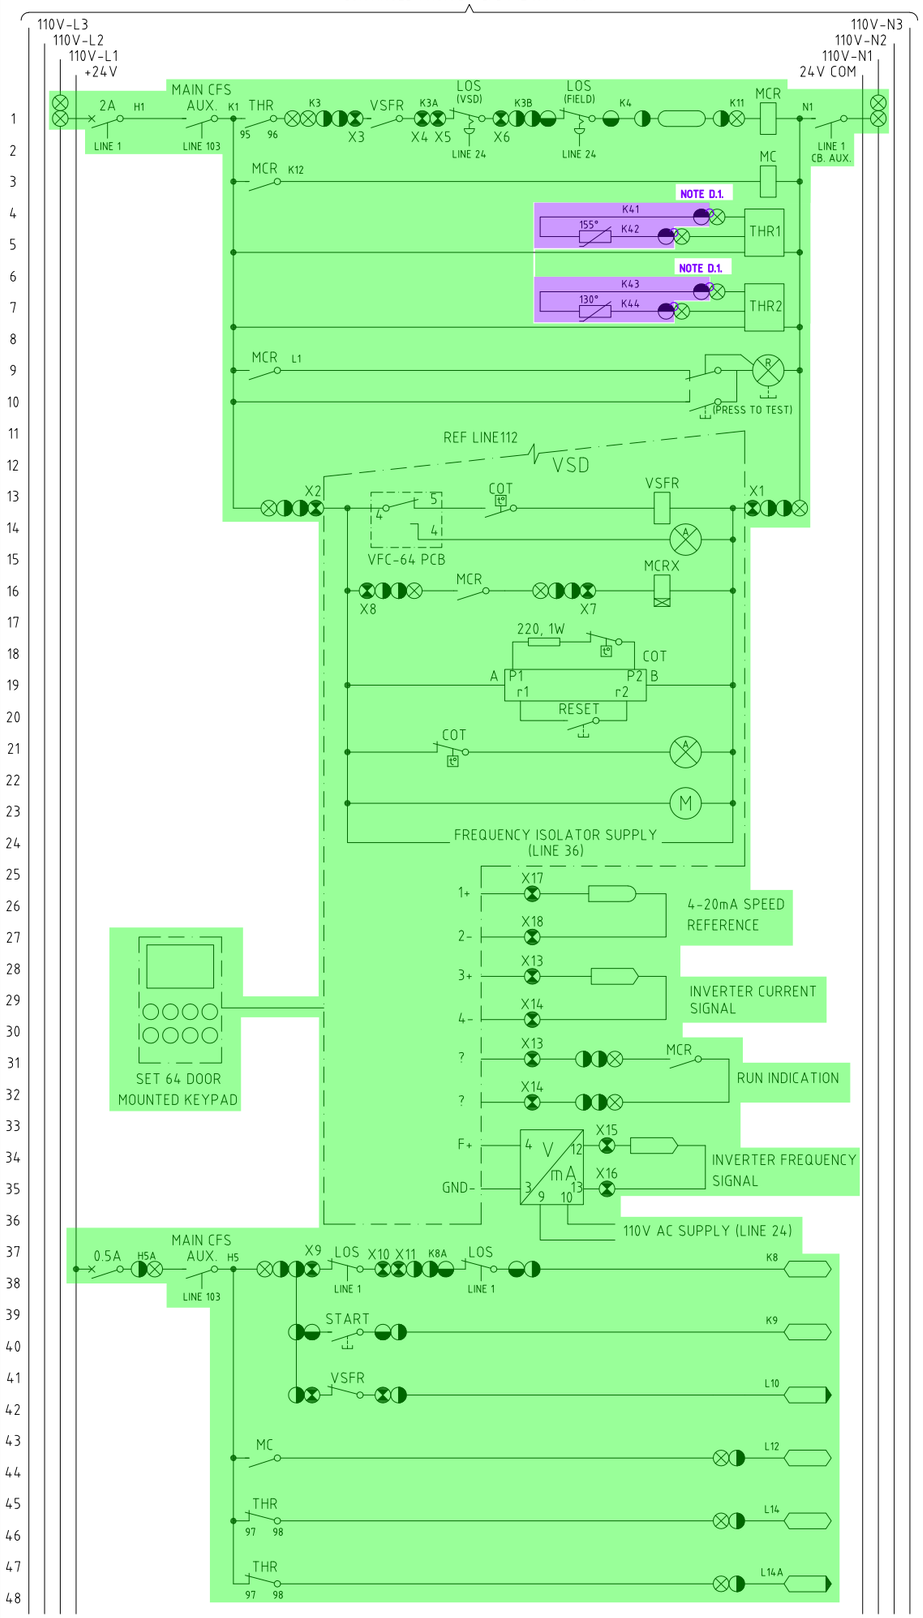


MAIN CONTACTOR RELAY
3, 5, 10, 46, 48

MAIN CONTACTOR
30, 100, 101, 102

THERMISTOR RELAY 1
THERMISTOR RELAY 2
NOTE: NOT FITTED TO ALL DRIVES

RUN INDICATION

VSD FAULT RELAY

CONTROLLER FAULT

START TIME DELAY RELAY

CUBICLE OVER TEMPERATURE ALARM RELAY

CUBICLE OVER TEMPERATURE

CUBICLE FANS

STOP INPUT

START INPUT

FAULT INPUT


RUN INPUT

THERMISTOR FAULT INPUT


NOTE: NOT FITTED TO ALL DRIVES

THERMISTOR ALARM INPUT

## POWER LAYOUT

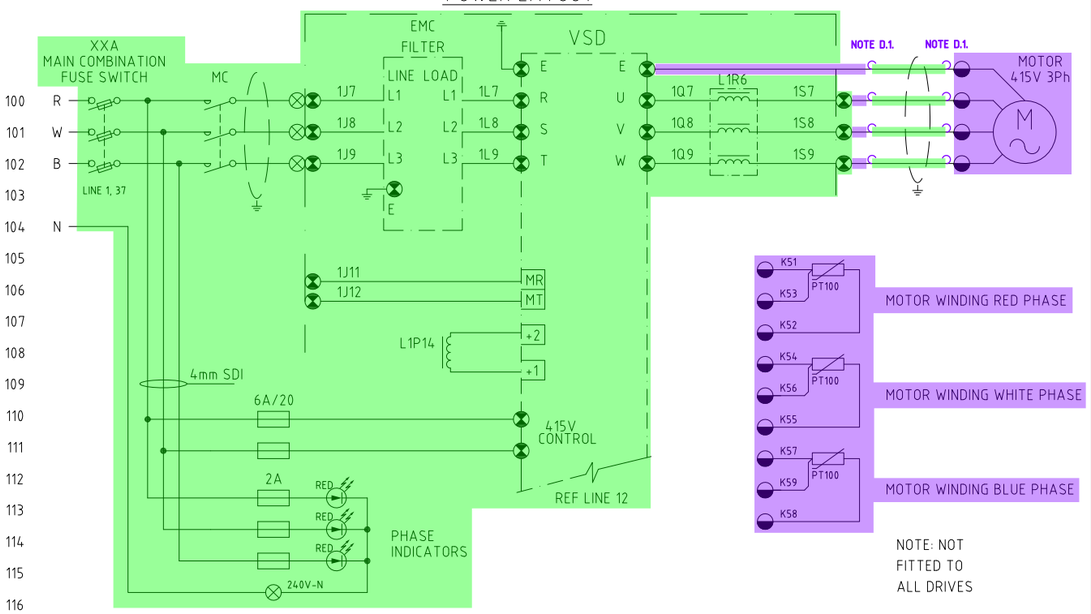


NOTE: NOT FITTED TO ALL DRIVES

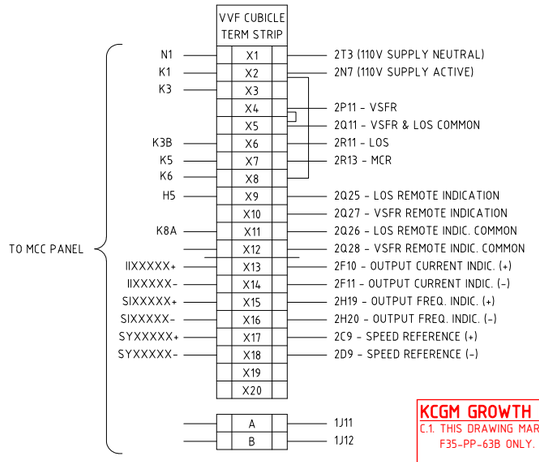


LEGEND

- EXISTING
- NON-EXISTENT
- STAGE 1 - NEW
- STAGE 1 - REMOVE
- STAGE 1 - DECOMMISSIONED (OTHERS)
- STAGE 2 - NEW
- STAGE 2 - REMOVE
- STAGE 2 - DECOMMISSIONED (OTHERS)

**KCGM GROWTH PROJECT**

DRAWING NO. 2000-F34-SCM-EL-10005

| REV | DATE | DESCRIPTION | CHECK | TECH APP |
|---|---|---|---|---|
| 0 | 25/07/25 | APPROVED FOR CONSTRUCTION | RF | MB/DM |

| EQUIPMENT NUMBER | DESCRIPTION | MODULE NUMBER | FERRULE PREFIX | 24V C.B No. | START OUTPUT | STOP INPUT | RUN INPUT | START INPUT |
|---|---|---|---|---|---|---|---|---|
| F34-PP-01 | UFG MILL FEED PUMP | 3F/4 | PP01 | R3/3 | %Z013202 | %Z013106 | %Z013107 | %Z013105 |
| F34-PP-02 | UFG CLASSIFICATION CYCLONE FEED PUMP | 1F/5 | PP02 | R3/2 | %Z013206 | %Z013115 | %Z013116 | %Z013114 |
| F35-PP-61A | CONCENTRATE THICKENER UNDERFLOW PUMP A | 2F/4 | PP61A | R7/3 | %Z033211 | %Z033302 | %Z033303 | %Z033301 |
| | | | | | | | | |
| F35-PP-63A | DESLIME CYCLONE FEED PUMP A | 2F/5 | PP63A | R7/5 | %Z033215 | %Z033315 | %Z033316 | %Z033314 |
| F35-PP-63B | DESLIME CYCLONE FEED PUMP B | 3F/5 | PP63B | R7/6 | %Z043202 | %Z043106 | %Z043107 | %Z043105 |
| F35-PP-65 | UFG PLANT FEED PUMP | 1F/4 | PP62 | R7/2 | %Z033205 | %Z033307 | %Z033308 | %Z033306 |

| EQUIPMENT NUMBER | FAULT INPUT | THERMISTOR FAULT INPUT | THERMISTOR ALARM INPUT | REMOTE SPEED INPUT | SPEED INPUT LOOP No. | REMOTE CURRENT INPUT | CURRENT INPUT LOOP No. | REMOTE SPEED OUTPUT | SPEED OUTPUT LOOP No. | |
|---|---|---|---|---|---|---|---|---|---|---|
| F34-PP-01 | %Z013108 | %Z013109 | | %Z011107 | SI34107 | %Z011108 | IT34106 | %Z01110 | SY34107 | |
| F34-PP-02 | %013117 | %Z013118 | %Z013119 | %Z012103 | SI34157 | %Z012104 | IT34156 | %Z012102 | SY34157 | |
| F35-PP-61A | %Z033304 | %Z033305 | | %Z032110 | SI35307A | %Z032111 | IT35310 | %Z032109 | SY35307A | |
| | | | | | | | | | | |
| F35-PP-63A | %033317 | %Z033318 | %Z033319 | %Z035102 | SI35767 | %Z035103 | IT35678 | %Z035101 | SY35767 | |
| F35-PP-63B | %Z043108 | %Z043109 | %Z043110 | %Z041102 | SI35787 | %Z041103 | IT35788 | %Z041101 | SY35787 | |
| F35-PP-65 | %Z033309 | | | %Z032104 | SI35737 | %Z032105 | IT35736 | %Z032103 | SY35737 | |

**KCGM GROWTH PROJECT CONSTRUCTION NOTES**

C.1. THIS DRAWING MARKUP IS APPLICABLE TO F35-PP-63A AND F35-PP-63B ONLY.

## LEGEND

TERMINALS

- MOTOR CONTROL CENTRE (MCC)
- FIELD
- PROCESS CONTROL CUBICLE
- LINE CONDITIONER
- SOFT STARTER TERMINAL
- VARIABLE SPEED DRIVE
- DISTRIBUTION BOARD
- HV MOTOR CONTROL CENTRE
- MISC. ELECTRICAL DEVICE REFER NOTES FOR SPECIFIC DESC.

DIGITAL FUNCTIONS

- DCS INPUT
- DCS INPUT WITH ALARM FUNCTION
- DCS OUTPUT

ANALOGUE FUNCTION

- 4-20mA INPUT
- 4-20mA OUTPUT

ANCILLARY EQUIPMENT

- CIRCUIT BREAKER
- COMBINATION FUSE SWITCH
- ISOLATOR
- PUSH BUTTON
- LOS (LOCK OFF STOP)
- PULL WIRE SWITCH
- NORMALLY CLOSED CONTACT
- LIMIT SWITCH
- CONTACTOR CONTACT
- NORMALLY OPEN CONTACT
- TIMER CONTACT
- FUNCTION CONTACT
  - P - PRESSURE
  - T - TEMPERATURE
  - F - FLOW
  - L - FLOAT
- SIREN
- HORN
- RELAY
- LINK
- THERMISTOR
- INDICATION LAMP R - RED, G - GREEN, A - AMBER

VOLTAGES ON CONTROL BUS

- +24V - 24V DC DCS SUPPLY BUS
- 110V-L1 - 110V AC MCC CONTROL BUS
- 110V-L2 - 110V AC CONDITIONED BUS
- 110V-L3 - 110V AC NON CONDITIONED BUS

## NOTES

**KCGM GROWTH PROJECT DEMOLITION NOTES**

D.1. VSD OUTGOING FIELD CABLES TO BE DISCONNECTED AND MADE SAFE AT BOTH ENDS.

| MK | DATE | REVISION | BY | CKD | APP |
|---|---|---|---|---|---|
| 5 | 25/09/19 | F35PP61B REMOVED NOW FOUND AT 34\E\0041-18 | [redacted] | BH | [redacted] |
| 4 | 20/02/15 | 19FS01 NEW VSD INSTALL & MOVED TO DWG 34\E\0041-013 | [redacted] | CJ | [redacted] |
| 3 | 13-5-04 | PUMP F35PP64 DETAILS REMOVED | [redacted] | DB | |

| MK | DATE | REVISION | BY | CKD | APP |
|---|---|---|---|---|---|
| 2 | 1-8-03 | DETAILS FOR ALL VSD'S IN SUB 10 TRANSFERRED TO SINGLE DRAWING | BJ | DB | |
| 1 | 24/04/02 | "AS BUILT" | [redacted] | IGC | |
| 0 | 15/10//01 | ISSUED FOR CONSTRUCTION | [redacted] | EM | |
| C | 02/10/01 | ISSUED FOR CLIENT APPROVAL | [redacted] | E.M | |
| B | 11/09/01 | APPROVED FOR TENDER PURPOSES ONLY | [redacted] | E.M | |
| B | 21/08/01 | PRELIMINARY DRAWING ONLY | [redacted] | E.M | |

REFERENCE DRAWINGS

DWG NO.

| | | |
|---|---|---|
| SCALE | NTS | |
| DRAWN | [redacted] | 21/08/01 |
| DESIGNED | [redacted] | 21/08/01 |
| CHECKED | [redacted] | |
| APPROVED | | |
| PROJ.APP | | |
| PROJ. FILE #. | | |

FIMISTON PLANT
ULTRA FINE GRINDING
SUBSTATION No. 10 415V. MCC 34-SW-02
CONTROL SCHEMATIC DIAGRAM

| SIZE | DRAWING NUMBER | REV. |
|---|---|---|
| A1 | 34\E\0041-010 | 5 |

KALGOORLIE CONSOLIDATED GOLD MINES PTY. LTD. ABN 009 377 619 003