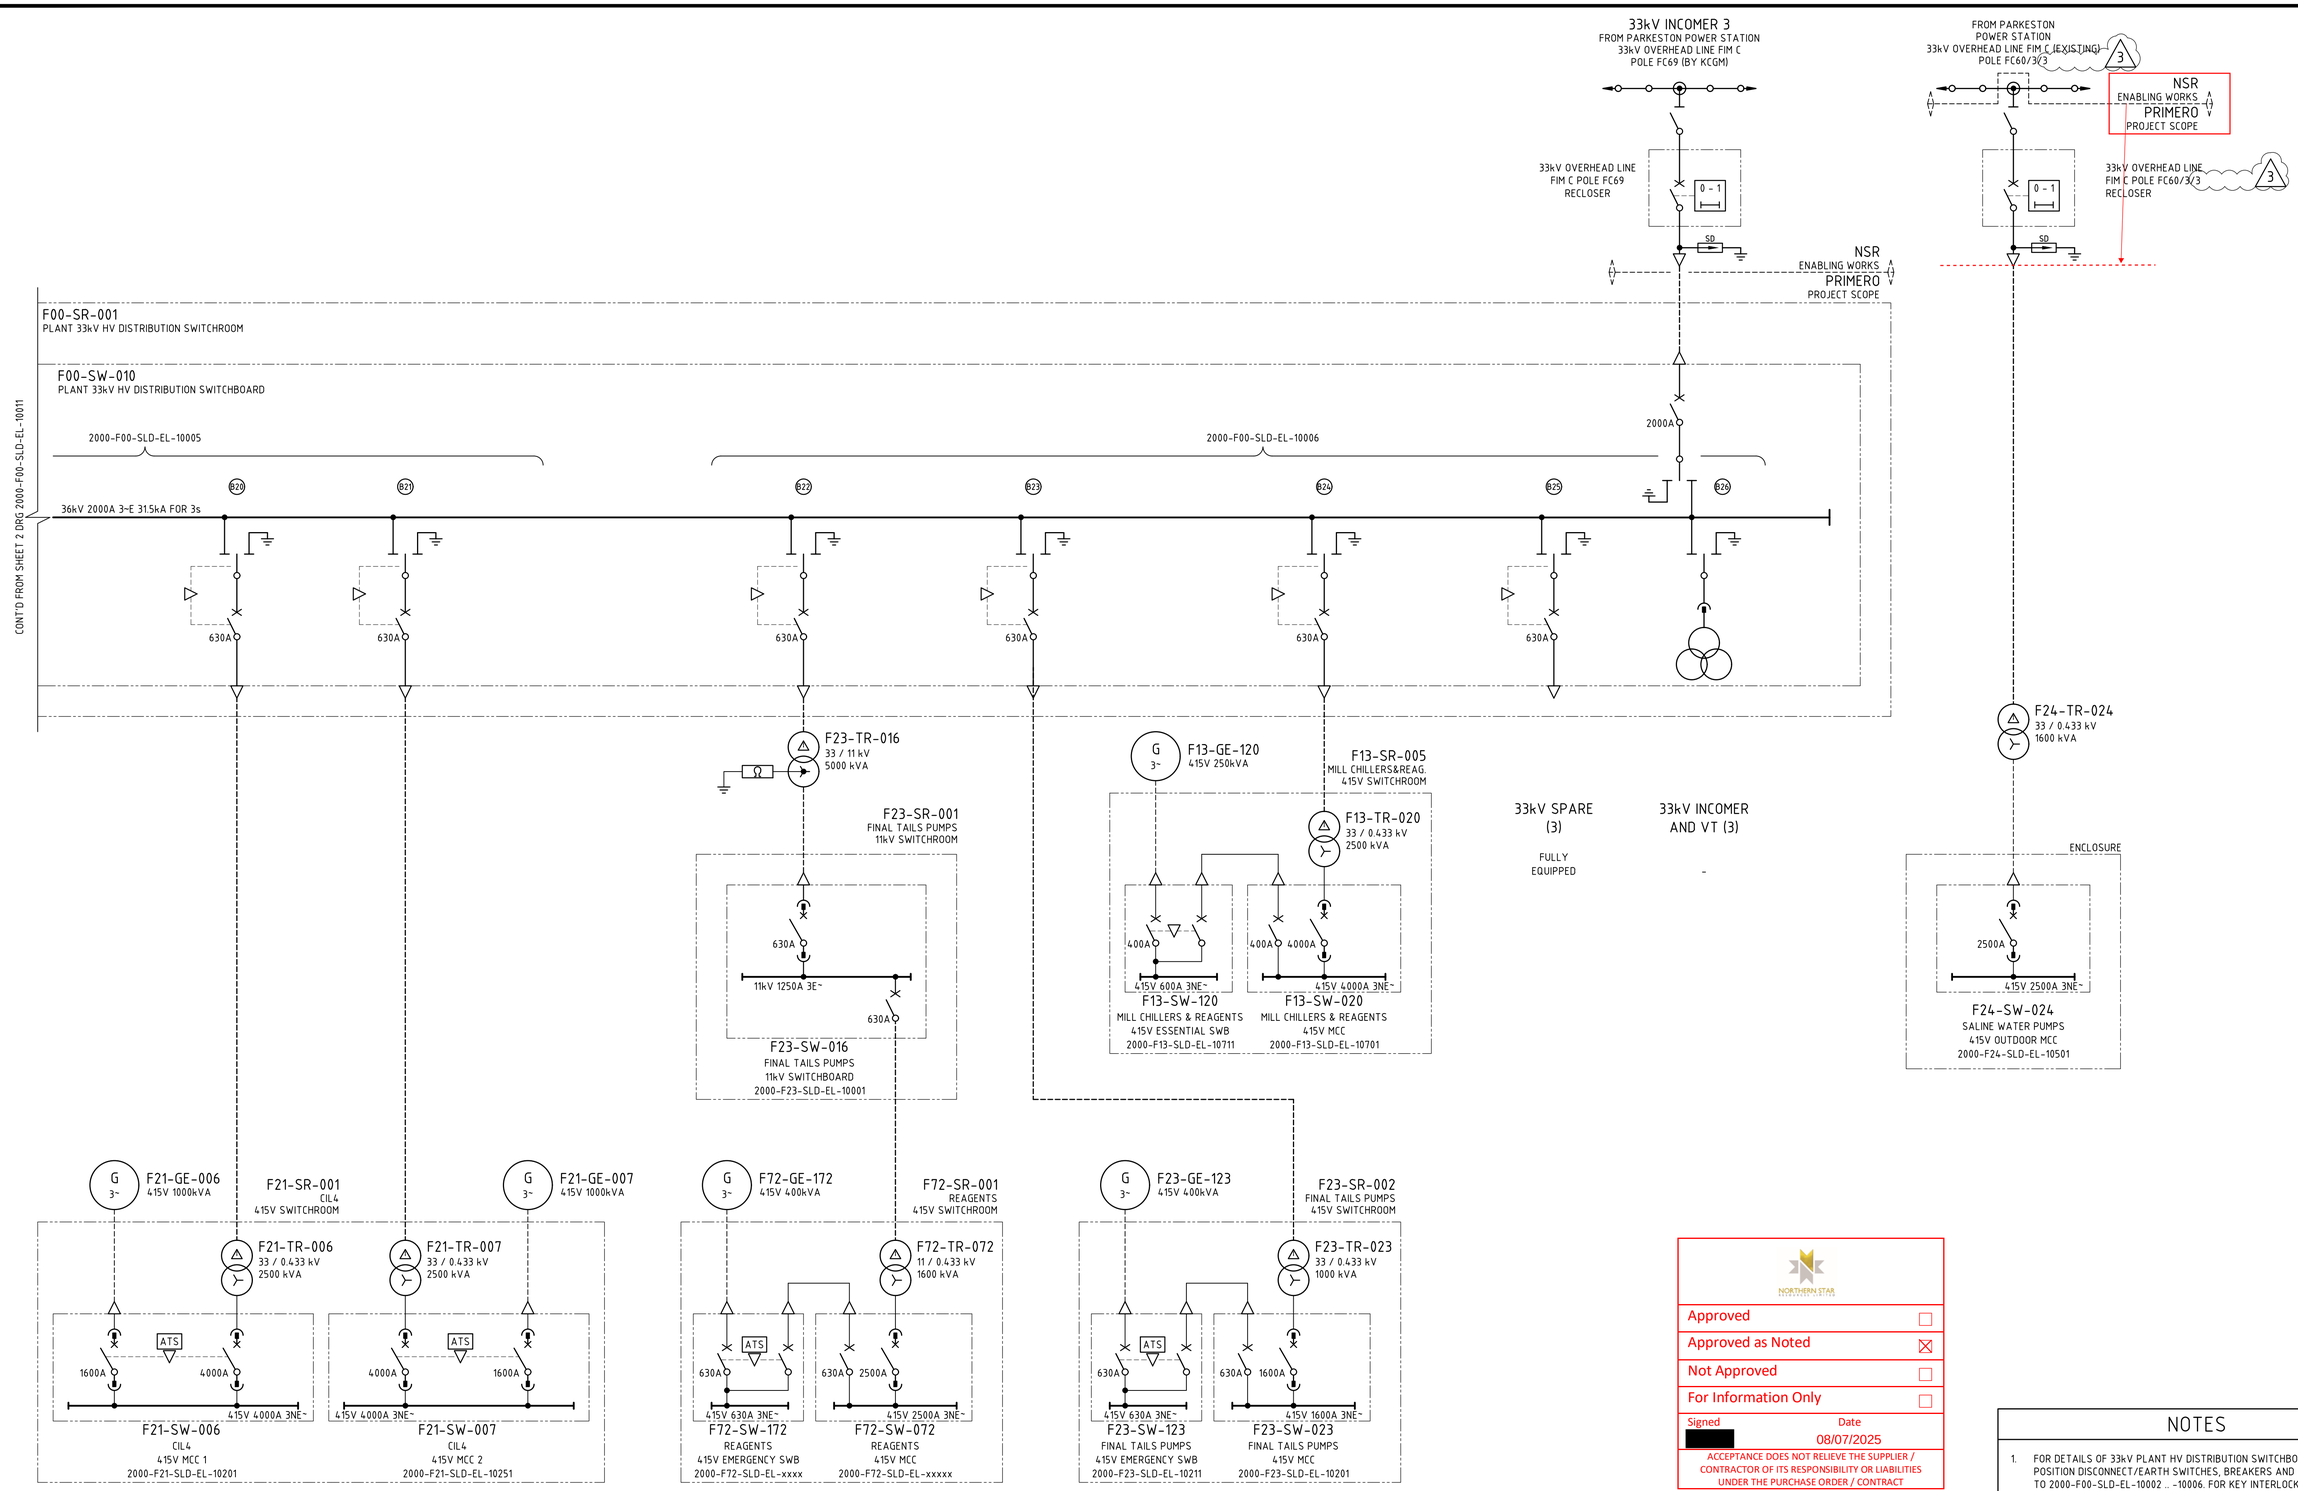



| | |
|---|---|
| Approved | ☐ |
| Approved as Noted | ☒ |
| Not Approved | ☐ |
| For Information Only | ☐ |
| Signed [redacted] | Date 08/07/2025 |

ACCEPTANCE DOES NOT RELIEVE THE SUPPLIER / CONTRACTOR OF ITS RESPONSIBILITY OR LIABILITIES UNDER THE PURCHASE ORDER / CONTRACT

## NOTES

1. FOR DETAILS OF 33kV PLANT HV DISTRIBUTION SWITCHBOARD THREE POSITION DISCONNECT/EARTH SWITCHES, BREAKERS AND BUS TIES REFER TO 2000-F00-SLD-EL-10002 .. -10006. FOR KEY INTERLOCKING, REFER TO KEY INTERLOCKING DIAGRAMS 2000-F00-SLD-EL-10051 .. -10055

| DRG No. | REFERENCES |
|---|---|
| 2000-F00-BLK-IC-10001 | OVERALL SITEWIDE FIBRE OPTIC COMMUNICATIONS BLOCK DIAGRAM |
| 2000-F00-SLD-EL-10006 | F00-SW-010 PLANT 33kV DISTRIBUTION SWITCHBOARD SINGLE LINE DIAGRAM SHEET 5 |
| 2000-F00-SLD-EL-10005 | F00-SW-010 PLANT 33kV DISTRIBUTION SWITCHBOARD SINGLE LINE DIAGRAM SHEET 4 |
| 2000-F00-SLD-EL-10004 | F00-SW-010 PLANT 33kV DISTRIBUTION SWITCHBOARD SINGLE LINE DIAGRAM SHEET 3 |
| 2000-F00-SLD-EL-10003 | F00-SW-010 PLANT 33kV DISTRIBUTION SWITCHBOARD SINGLE LINE DIAGRAM SHEET 2 |
| 2000-F00-SLD-EL-10002 | F00-SW-010 PLANT 33kV DISTRIBUTION SWITCHBOARD SINGLE LINE DIAGRAM SHEET 1 |
| 2000-F00-SLD-EL-10001 | OVERALL SITEWIDE 33kV DISTRIBUTION SINGLE LINE DIAGRAM SHEET 1 |
| 2000-F00-STD-EL-10001 | GENERAL NOTES AND STANDARD DRAWINGS INDEX |

| REV | DATE | DESCRIPTION | DRAW | CHECK | DESIGN | TECH APP | PROJ APP |
|---|---|---|---|---|---|---|---|
| 3 | 22JUL25 | 33kV OVERHEAD LINE POLE NUMBERS REVISED | AD | GD | KT | MB | DM |
| 2 | 30MAY25 | FAT REDLINES INCORPORATED | SC | AD | JL | MB | DM |
| 1 | 05NOV24 | F23-SR-001 REVISED & ADDED F72-SR-001 REAGENTS 415V SWBD | WS | CB | JL | MB | DM |
| 0 | 26SEP24 | APPROVED FOR CONSTRUCTION | KW | CB | KT | MB | DM |

NORTHERN STAR RESOURCES LIMITED

PRIMERO
primero.com.au | DESIGN | CONSTRUCT | OPERATE

PRIMERO PROJECT NUMBER: 23517

INFORMATION AND REPRESENTATIONS ON THIS DRAWING ARE THE INTELLECTUAL PROPERTY OF PRIMERO UNLESS SPECIFICALLY IDENTIFIED OTHERWISE. ALL RIGHTS INCLUDING USE RESERVED

PROJECT: NORTHERN STAR RESOURCES LTD
KCGM GROWTH PROJECT

TITLE: GENERAL FIMISTON SITE
OVERALL SITEWIDE 33kV DISTRIBUTION
SINGLE LINE DIAGRAM SHEET 3

| SHEET | SCALE | DRG No. | REVISION |
|---|---|---|---|
| A1 | NONE | 2000-F00-SLD-EL-10012 | 3 |

O:\CAD PROJECTS\235 NORTHERN STAR RESOURCES LTD\23517 KCGM GROWTH PROJECT\03 DELIVERABLES\EL\F00 - GENERAL FIMISTON SITE\2000-F00-SLD-EL-10012.DWG 22JUL25 12:17PM ANTONY.DECAPRIO