



F12-DB-301
PRIMARY CRUSHING
AREA 1
L&SP DISTRIBUTION BOARD
250 A

2000-F12-TLD-EL-10201

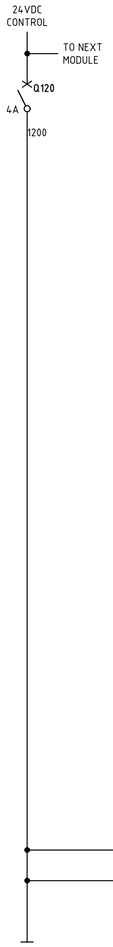

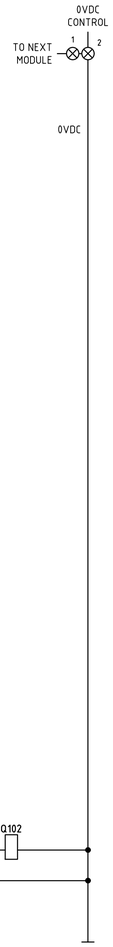


CABLE ZONE
24VDC TERMINALS

24VDC
LOOPED POWER
NEXT MODULE
PREV MODULE

Q120	4A	2530
1		2540
2		2540
3		
4		
5		
6		
7		
8	⏚	EARTH

NOTE 2

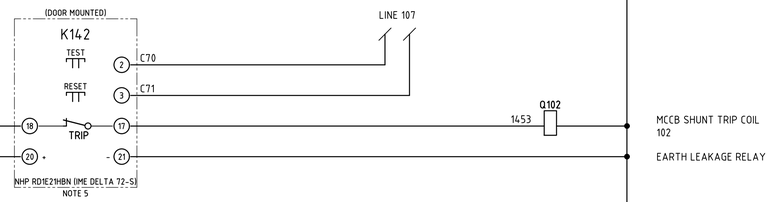

MCCB SHUNT TRIP COIL
102

EARTH LEAKAGE RELAY


NOTES

1. TERMINALS ON TERMINAL STRIPS ABOVE 50VAC SHALL HAVE A SEPARATE PERSPEX SHROUD AND SHALL BE LABELLED "DANGER xxxVAC".
2. WIRE NUMBER FERRULES ON TERMINAL STRIP SHALL BE PREFIXED WITH EQUIPMENT NUMBER e.g. F12DB301-1200, UNLESS OTHERWISE NOTED.
3. EACH WIRE SHALL BE IDENTIFIED AT BOTH ENDS WITH FERRULES.
4. NHP TDGH2
   IN:90A IΔN MIN:0.03A TOROID TO SUIT CABLE DIAMETER.
5. EARTH LEAKAGE RELAY (ELV) USER INTERFACE TO BE MOUNTED ON MCC MODULE DOOR. RELAY ENERGISED (NORMALLY CLOSED CONTACT OPEN) IN NORMAL OPERATION.

LEGEND

- 00/01/00 — DCS DIGITAL INPUT
- 00/02/00 — DCS DIGITAL OUTPUT
- ⊗ — MCC TERMINAL
- ◕ — VSD TERMINAL
- ◒ — FIELD TERMINAL
- ◑ — DCS OR I/O TERMINAL
- ◧ — MARSHALLING TERMINAL
- ⊗ x — DEVICE TERMINAL
- ⊗ cc — INDICATION LAMP, cc = COLOUR

TERMINATION LEGEND

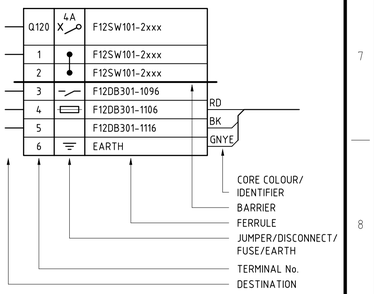

DRG No.	REFERENCES
2000-F12-SLD-EL-10211	F12-SW-101 415V ESSENTIAL SWITCHBOARD SINGLE LINE DIAGRAM
2000-F00-STD-EL-10001	GENERAL NOTES AND STANDARD DRAWINGS INDEX

REV	DATE	DESCRIPTION	DRAW	CHECK	DESIGN	TECH APP	PROJ APP
2	24AUG26	KCGM GROWTH PROJECT - SP1 AS-BUILT			JE	JE	
1	17JUL25	FAT REDLINES INCORPORATED					
0	17SEP24	APPROVED FOR CONSTRUCTION					

NORTHERN STAR RESOURCES LIMITED

PRIMERO
primero.com.au | DESIGN | CONSTRUCT | OPERATE

PRIMERO PROJECT NUMBER: 23517

INFORMATION AND REPRESENTATIONS ON THIS DRAWING ARE THE INTELLECTUAL PROPERTY OF PRIMERO UNLESS SPECIFICALLY IDENTIFIED OTHERWISE. ALL RIGHTS INCLUDING USE RESERVED

PROJECT: NORTHERN STAR RESOURCES LTD
KCGM GROWTH PROJECT

TITLE: PRIMARY CRUSHING - F12-SW-101
F12-DB-301 PRIMARY CRUSHING AREA 1 L&SP DB
SCHEMATIC AND TERMINATION DIAGRAM

SHEET	SCALE	DRG No.	REVISION
A1	NONE	2000-F12-SCM-EL-10207	2

O:\CAD PROJECTS\235 NORTHERN STAR RESOURCES LTD\23517 KCGM GROWTH PROJECT\03 DELIVERABLES\ELV\F12 - PRIMARY CRUSHING\2000-F12-SCM-EL-10207.DWG 24AUG26 11:08PM GRENVILLE.DEASY