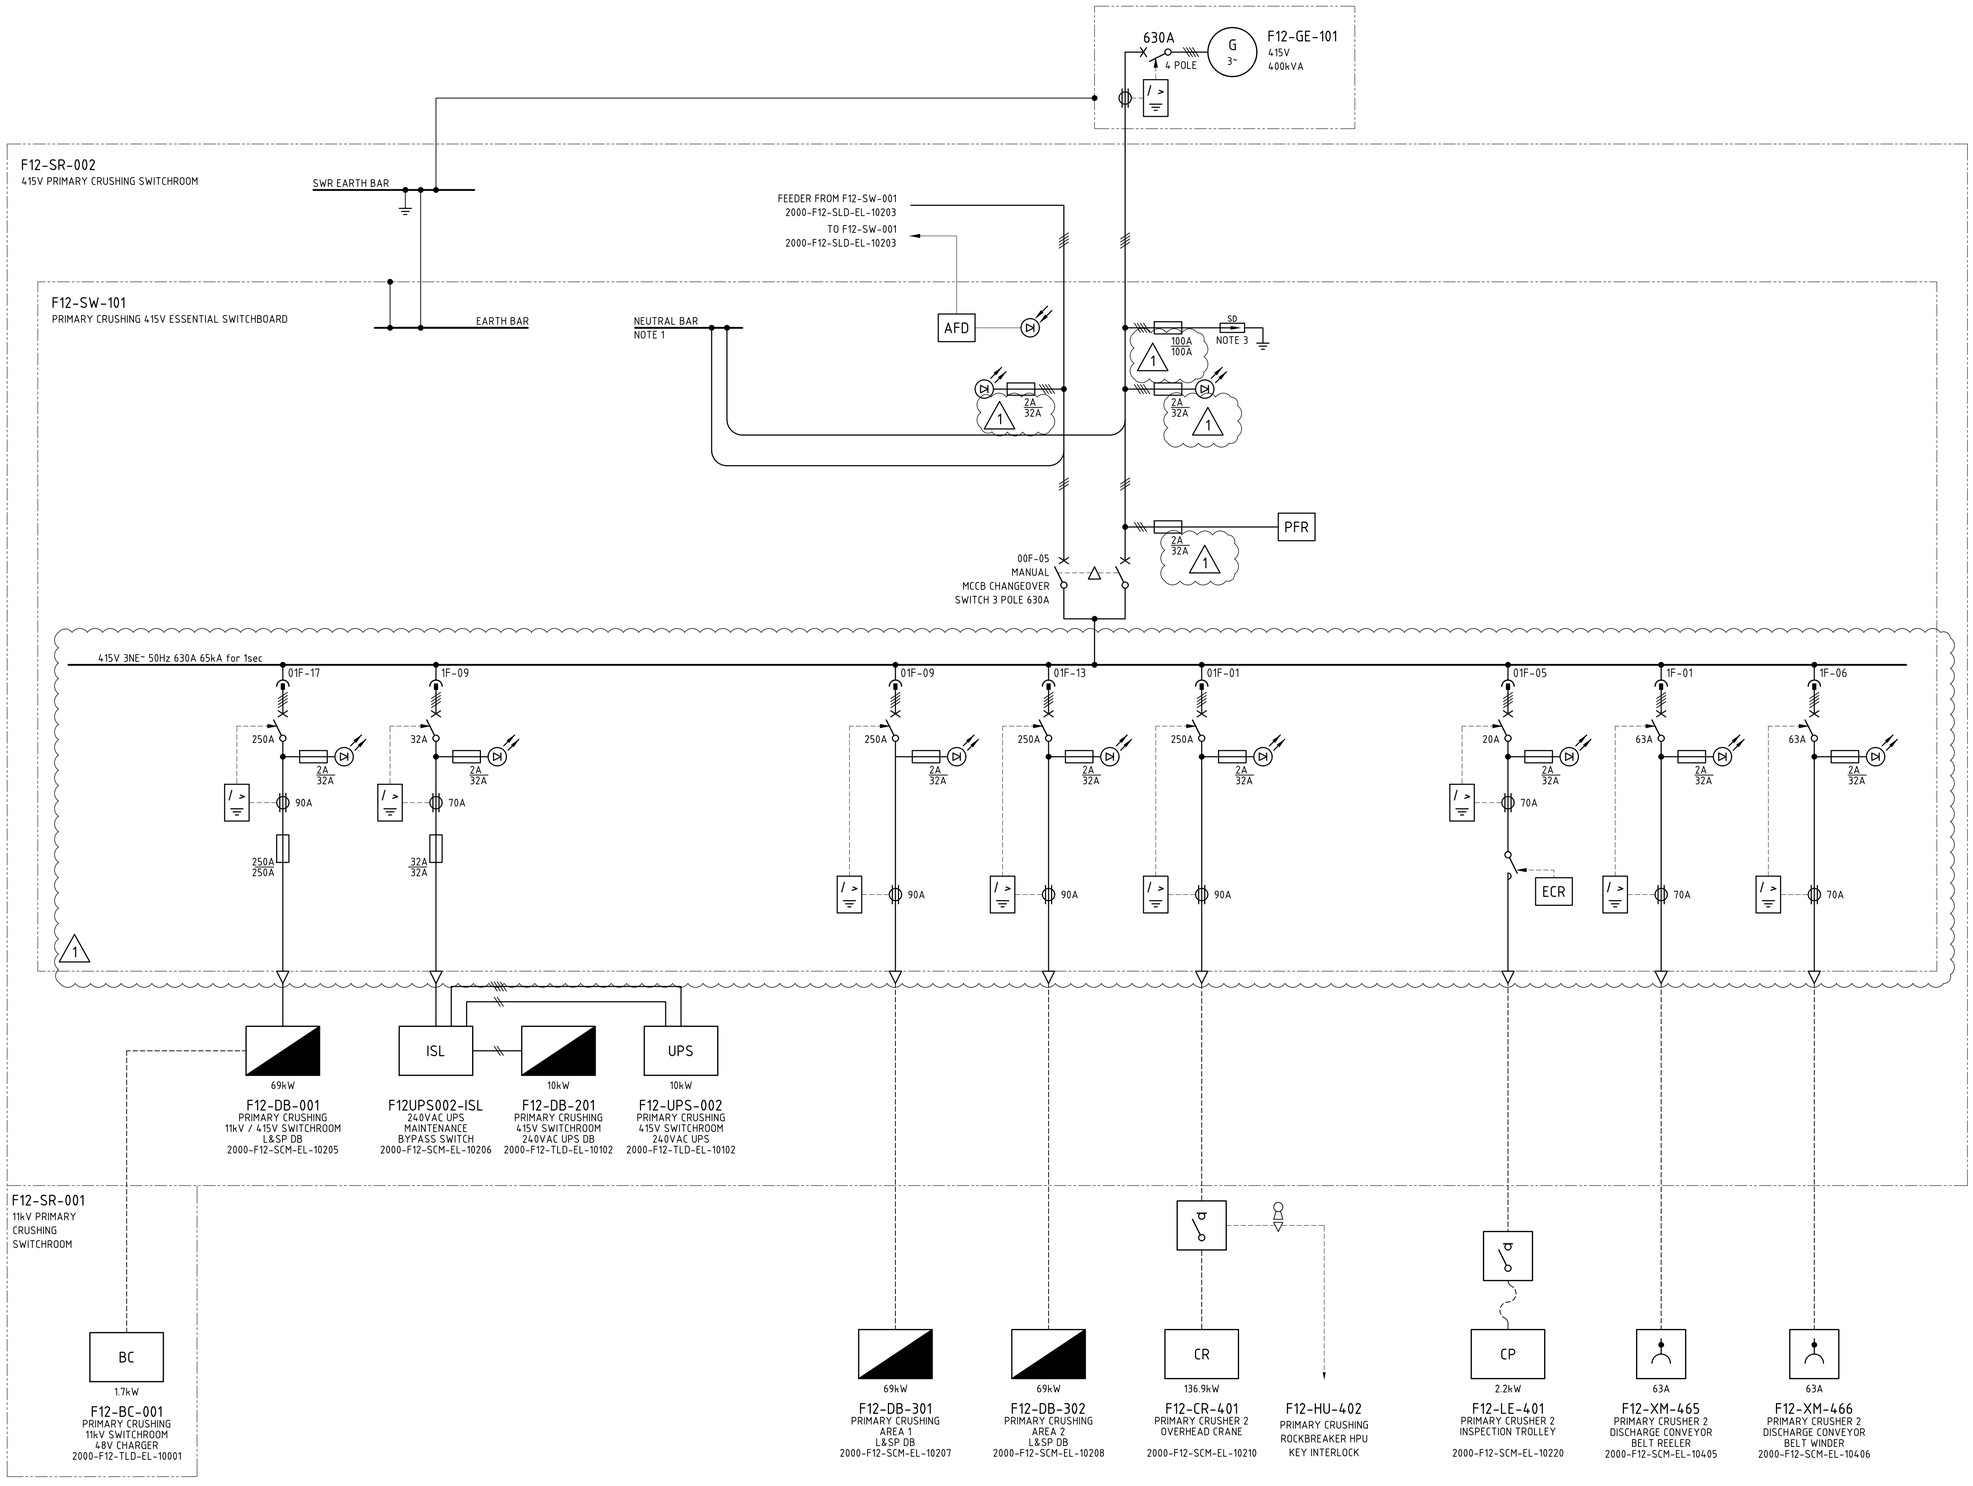


NOTES

1. EARTH-NEUTRAL LINK INSTALLED IN UPSTREAM F12-SW-001 INCOMER TIER. SIGNAGE SHALL BE PLACED ON F12-SW-101 SWITCHBOARD AND ON GENERATOR READING "M.E.N. LINK LOCATED IN F12-SW-001 INCOMER TIER"
2. SWITCHBOARD SHALL BE EXTENSIBLE AND BE PROVIDED WITH THE FACILITY TO EXTEND THE MAIN BUSBAR AND APPEND ADDITIONAL TIERS AT ONE END WITHOUT MAJOR STRUCTURAL DISASSEMBLY.
3. SURGE DIVERTERS SHALL PROVIDE FEEDBACK TO DCS VIA VOLT-FREE CONTACTS. SURGE DIVERTER FUSES SHALL BE SIZED BY VENDOR TO SUIT DUTY.
4. MINIATURE CIRCUIT BREAKERS SHALL BE SIZED AND RATED TO SUIT ACB AND INCOMER REQUIREMENTS.
5. CIRCUIT BREAKER TO BE SUBSTITUTED FOR FUSED-SWITCH WHERE REQUIRED BY EQUIPMENT MANUFACTURERS GUIDELINES.

LEGEND

- PFR — PHASE FAILURE RELAY
- / > — EARTH LEAKAGE RELAY
- xxxA / xxxA — ST TRIP SET POINT / CB SIZE
- AFD — ARC FLASH DETECTION
- ECR — EARTH CONTINUITY RELAY
- 63A 3 PHASE SOCKET OUTLET
- KEY-OPERATED INTERLOCK

NORTHERN STAR RESOURCES LIMITED

Approved	X
Approved as Noted	
Not Approved	
For Information Only	

Signed [redacted] Date 04/09/2025

ACCEPTANCE DOES NOT RELIEVE THE SUPPLIER / CONTRACTOR OF ITS RESPONSIBILITY OR LIABILITIES UNDER THE PURCHASE ORDER / CONTRACT

DRG No.	REFERENCES
2000-F12-SCM-EL-10203	F12-SW-001 415V MCC ARC FLASH SYSTEM SCHEMATIC DIAGRAM
2000-F12-SCM-EL-10202	F12-SW-001 415V MCC 24VDC DISTRIBUTION SCHEMATIC DIAGRAM
2000-F12-SCM-EL-10233	F12-SW-101 415V ESSENTIAL SWITCHBOARD INCOMER SCHEMATIC DIAGRAM
2000-F12-DRG-EL-10001	F12-SR-002 415V SWITCHROOM ELECTRICAL EQUIPMENT LAYOUT
2000-F12-BLK-IC-10001	F12-SR-002 415V SWITCHROOM AND REMOTE I/O COMMUNICATIONS BLOCK DIAGRAM
2000-F12-SLD-EL-10201	F12-SW-001 415V MCC SINGLE LINE DIAGRAM SHEET 1
2000-F00-SLD-EL-10002	F00-SW-010 33kV SWITCHBOARD SINGLE LINE DIAGRAM SHEET 1 OF 5
2000-F00-STD-EL-10001	GENERAL NOTES AND STANDARD DRAWINGS INDEX

REV	DATE	DESCRIPTION	DRAW	CHECK	DESIGN	TECH APP	PROJ APP
1	18JUL25	FAT REDLINES INCORPORATED	PP SC	[redacted]	[redacted]	JH	[redacted]
0	29AUG24	APPROVED FOR CONSTRUCTION	[redacted]	[redacted]	[redacted]	[redacted]	[redacted]

NORTHERN STAR RESOURCES LIMITED

PRIMERO
primero.com.au | DESIGN | CONSTRUCT | OPERATE

PRIMERO PROJECT NUMBER: 23517

INFORMATION AND REPRESENTATIONS ON THIS DRAWING ARE THE INTELLECTUAL PROPERTY OF PRIMERO UNLESS SPECIFICALLY IDENTIFIED OTHERWISE. ALL RIGHTS INCLUDING USE RESERVED

PROJECT: NORTHERN STAR RESOURCES LTD
KCGM GROWTH PROJECT

TITLE: PRIMARY CRUSHING
F12-SW-101 415V ESSENTIAL SWITCHBOARD
SINGLE LINE DIAGRAM

SHEET	SCALE	DRG No.	REVISION
A1	NONE	2000-F12-SLD-EL-10211	1

O:\CAD PROJECTS\235 NORTHERN STAR RESOURCES LTD\23517 KCGM GROWTH PROJECT\03 DELIVERABLES\EL\F12 - PRIMARY CRUSHING\2000-F12-SLD-EL-10211.DWG 13AUG25 11:52AM HOTSEAT04