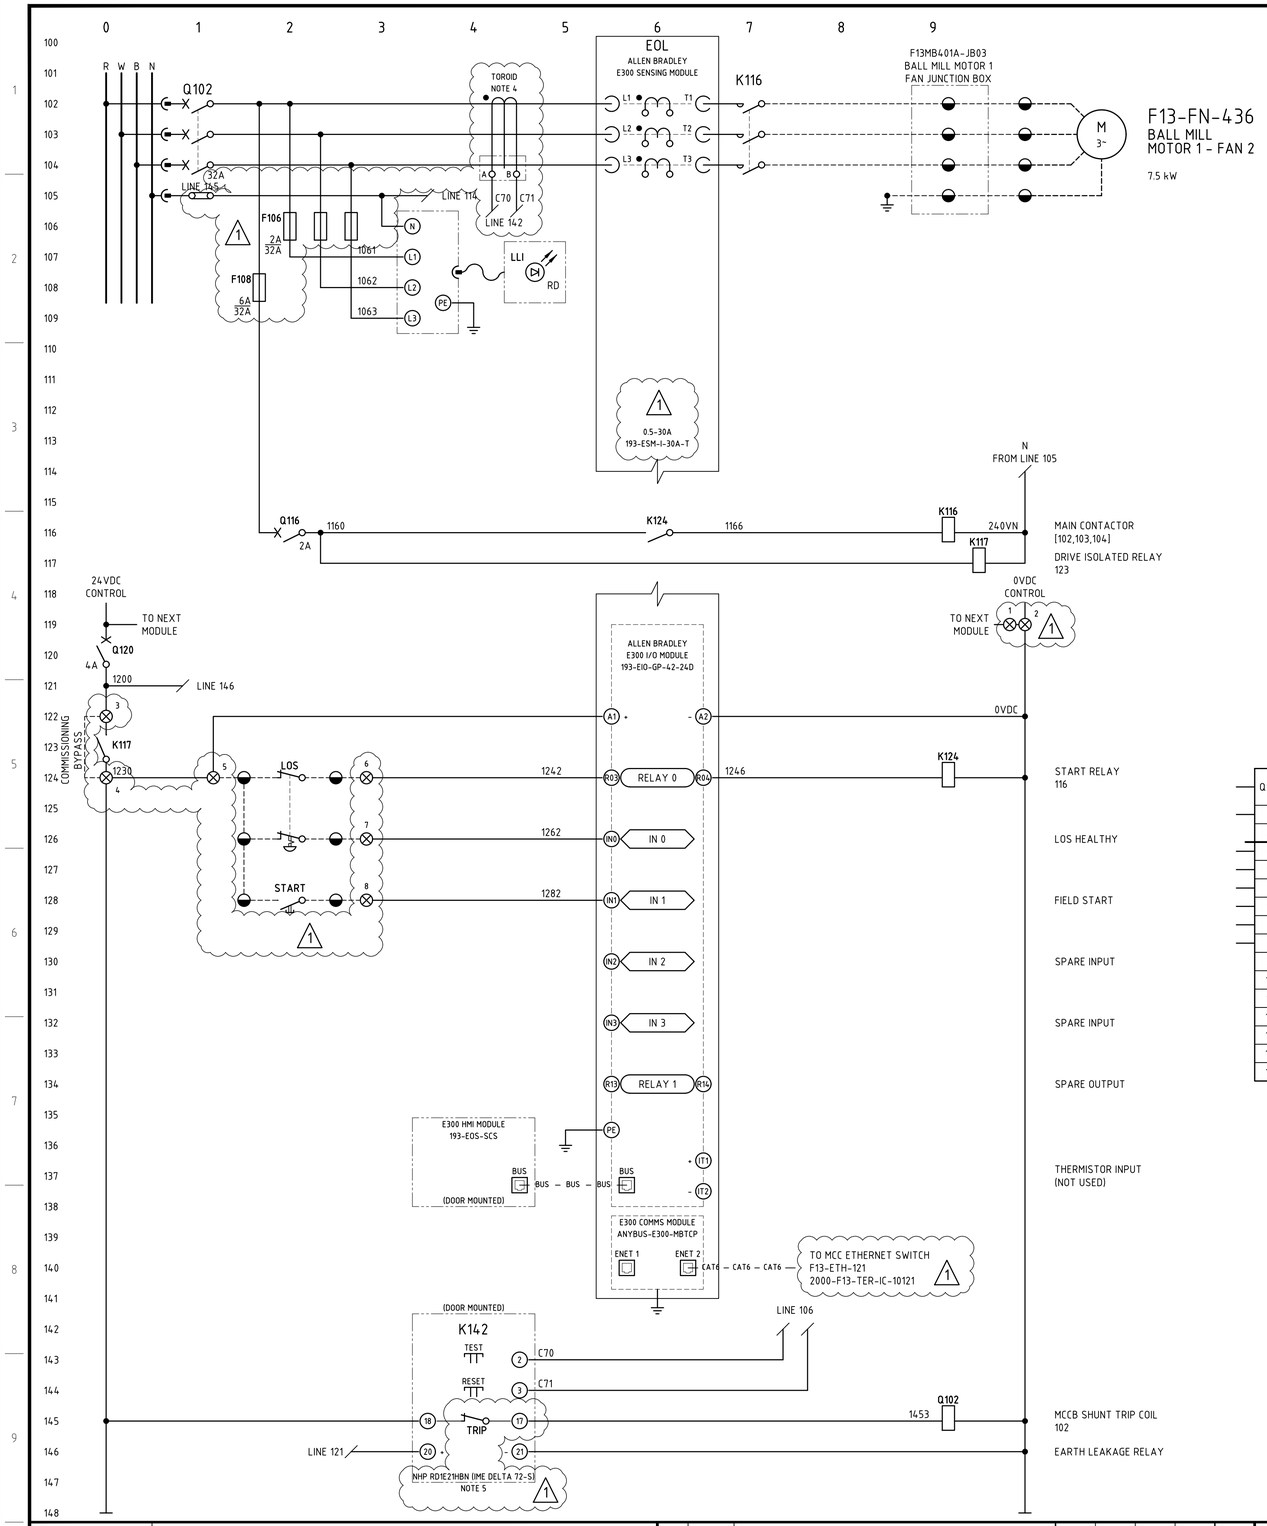



NOTES

1. TERMINALS ON TERMINAL STRIPS ABOVE 50VAC SHALL HAVE A SEPARATE PERSPEX SHROUD AND SHALL BE LABELLED "DANGER xxxVAC".
2. WIRE NUMBER FERRULES ON TERMINAL STRIP SHALL BE PREFIXED WITH EQUIPMENT NUMBER e.g. F13FN436-1200, UNLESS OTHERWISE NOTED.
3. EACH WIRE SHALL BE IDENTIFIED AT BOTH ENDS WITH FERRULES.
4. NHP TDGB2
   IN:70A IΔN MIN:0.03A TOROID TO SUIT CABLE DIAMETER.
5. EARTH LEAKAGE RELAY (ELV) USER INTERFACE TO BE MOUNTED ON MCC MODULE DOOR. RELAY ENERGISED (NORMALLY CLOSED CONTACT OPEN) IN NORMAL OPERATION.

LEGEND

- 00/01/00 — DCS DIGITAL INPUT
- 00/02/00 — DCS DIGITAL OUTPUT
- MCC TERMINAL
- VSD TERMINAL
- FIELD TERMINAL
- DCS OR I/O TERMINAL
- MARSHALLING TERMINAL
- DEVICE TERMINAL
- INDICATION LAMP, cc = COLOUR

TERMINATION LEGEND

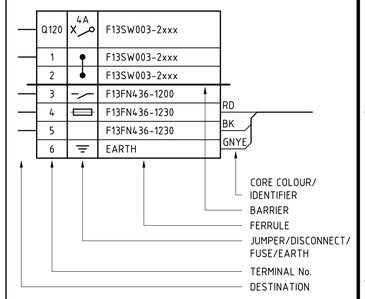

DRG No.	REFERENCES
2000-F13-SLD-EL-10901	F13-SW-003 415V MCC SINGLE LINE DIAGRAM SHEET 1
2000-F00-STD-EL-10001	GENERAL NOTES AND STANDARD DRAWINGS INDEX

REV	DATE	DESCRIPTION	DRAW	CHECK	DESIGN	TECH APP	PROJ APP
1	21AUG25	FAT REDLINES INCORPORATED					
0	07AUG24	APPROVED FOR CONSTRUCTION					

NORTHERN STAR RESOURCES LIMITED

PRIMERO
primero.com.au | DESIGN | CONSTRUCT | OPERATE

PRIMERO PROJECT NUMBER: 23517

INFORMATION AND REPRESENTATIONS ON THIS DRAWING ARE THE INTELLECTUAL PROPERTY OF PRIMERO UNLESS SPECIFICALLY IDENTIFIED OTHERWISE. ALL RIGHTS INCLUDING USE RESERVED

PROJECT: NORTHERN STAR RESOURCES LTD
KCGM GROWTH PROJECT

TITLE: MILLING & CLASSIFICATION - F13-SW-003
F13-FN-436 BALL MILL MOTOR 1 - FAN 2
SCHEMATIC AND TERMINATION DIAGRAM

SHEET	SCALE	DRG No.	REVISION
A1	NONE	2000-F13-SCM-EL-10915	1

O:\CAD PROJECTS\23S NORTHERN STAR RESOURCES LTD\23517 KCGM GROWTH PROJECT\03 DELIVERABLES\EL\F13 - MILLING & CLASSIFICATION\2000-F13-SCM-EL-10915.DWG 25SEP25 12:51PM HOTSEAT04