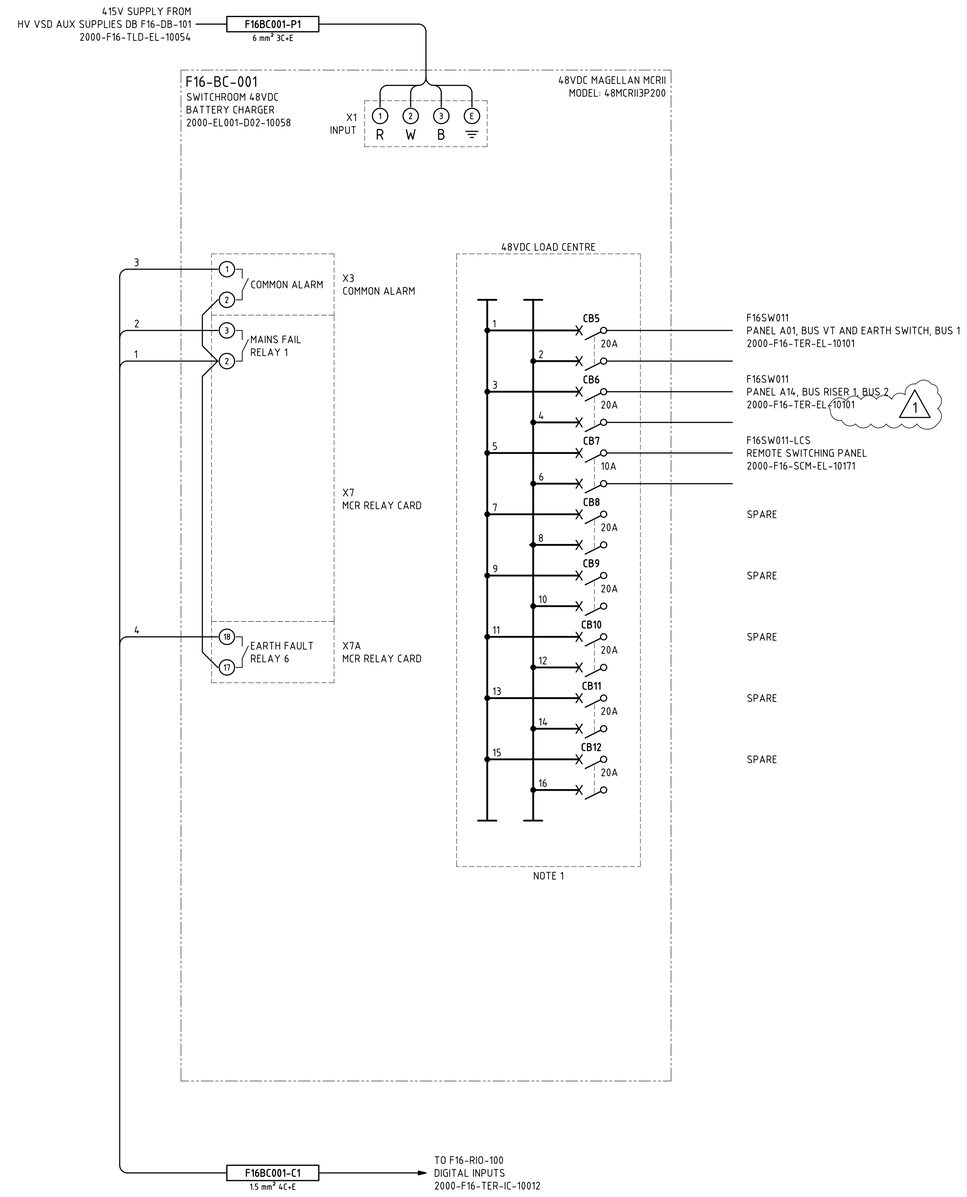


NOTES

1. ALL SPARE SPACE SHALL BE FILLED WITH DUMMY CIRCUIT BREAKERS, ESCUTCHEON POLE FILLERS SHALL NOT BE ACCEPTABLE.
2. EQUIPOTENTIAL BONDING CONDUCTOR SHALL BE INSTALLED FROM DB EARTH BAR TO SWITCHROOM EARTH BAR OR NEAREST EARTHED STRUCTURE VIA 35mm² Cu GNYE/PVC OR AS PER CABLE SCHEDULE.
3. AS-BUILT CIRCUIT SCHEDULE SHALL BE KEPT INTERNAL TO DISTRIBUTION BOARD AT ALL TIMES.
4. MINIMUM 20% SPARE CIRCUIT BREAKERS AND ADDITIONAL 20% SPARE SPACE SHALL BE PROVIDED FOR FUTURE LOADS.

LEGEND

- MCC TERMINAL
- VSD TERMINAL
- FIELD TERMINAL
- PLC OR I/O TERMINAL
- MARSHALLING TERMINAL
- DISTRIBUTION BOARD TERMINAL
- DEVICE TERMINAL
- INDICATION LAMP (cc = COLOUR)
- DUMMY CIRCUIT BREAKER (NOTE 1)

DRG No.	REFERENCES	REV	DATE	DESCRIPTION	DRAW	CHECK	DESIGN	TECH APP	PROJ APP
2000-EL001-D04-10058	F16-BC-001 11kV SWITCHROOM 48VDC CHARGER GENERAL ARRANGEMENT								
2000-F16-TLD-EL-10054	F16-DB-101 HV VSD AUXILIARY SUPPLIES DB	1	29AUG25	FAT REDLINES INCORPORATED					
2000-F00-STD-EL-10001	GENERAL NOTES AND STANDARD DRAWINGS INDEX	0	30OCT24	APPROVED FOR CONSTRUCTION					

NORTHERN STAR RESOURCES LIMITED

PRIMERO
primero.com.au | DESIGN | CONSTRUCT | OPERATE

PRIMERO PROJECT NUMBER: 23517

INFORMATION AND REPRESENTATIONS ON THIS DRAWING ARE THE INTELLECTUAL PROPERTY OF PRIMERO UNLESS SPECIFICALLY IDENTIFIED OTHERWISE. ALL RIGHTS INCLUDING USE RESERVED

PROJECT: NORTHERN STAR RESOURCES LTD
KCGM GROWTH PROJECT

TITLE: ROUGHER & SCAVENGER FLOTATION - F16-SR-001
F16-BC-001 HV SWITCHROOM 48VDC BATTERY CHARGER
THREE LINE DIAGRAM

SHEET	SCALE	DRG No.	REVISION
A1	NONE	2000-F16-TLD-EL-10051	1

O:\CAD PROJECTS\235 NORTHERN STAR RESOURCES LTD\23517 KCGM GROWTH PROJECT\03 DELIVERABLES\EL\F16 - ROUGHER & SCAVENGER FLOTATION\2000-F16-TLD-EL-10051DWG 09SEP25 7:25AM HOTSEAT04