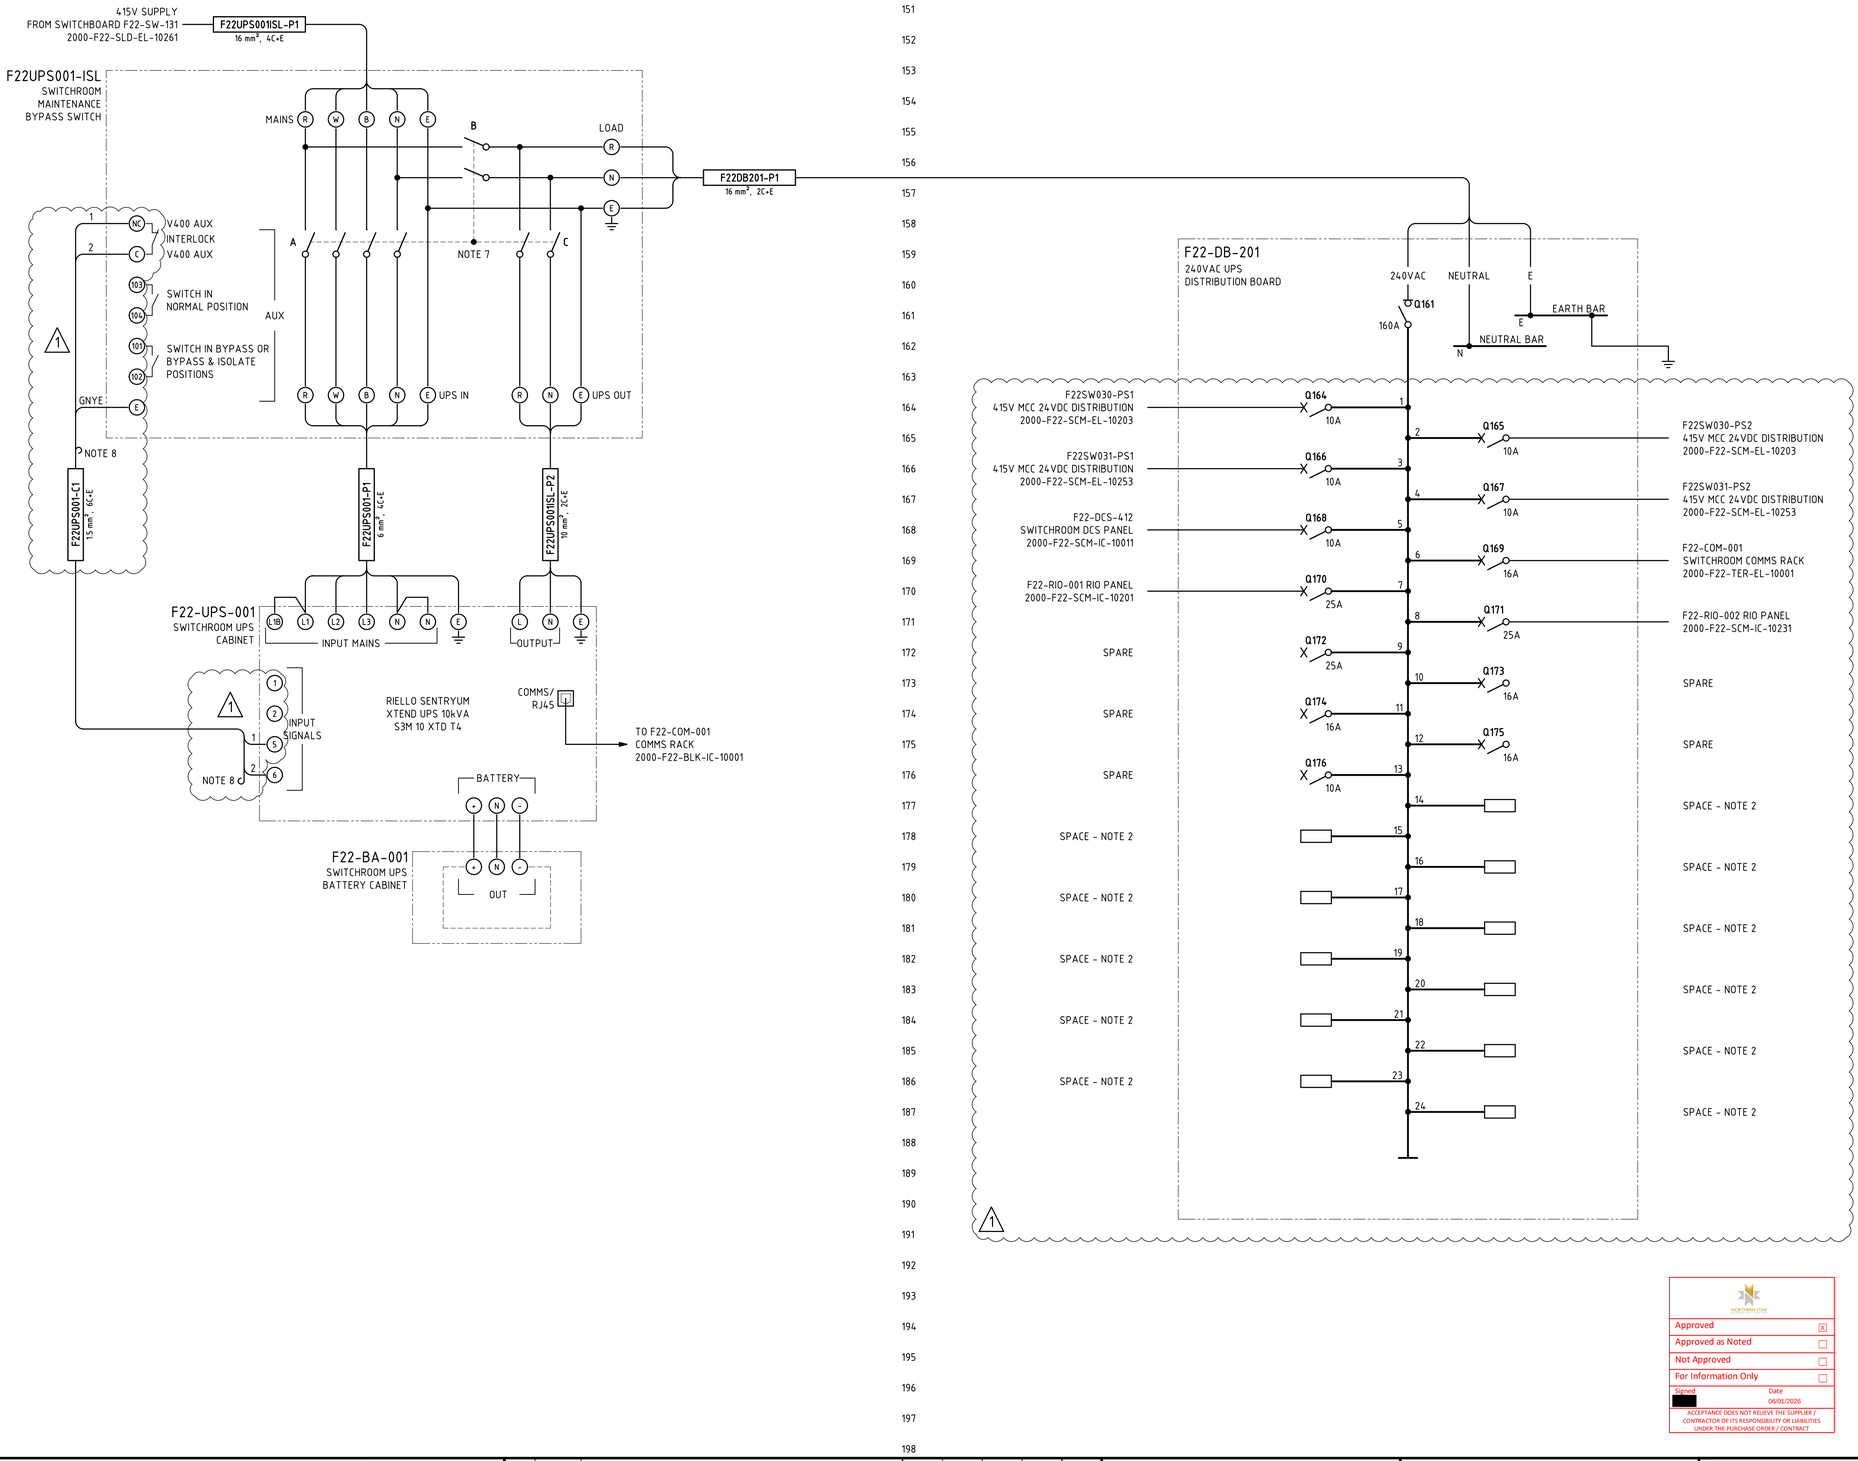



## NOTES

1. CIRCUIT BREAKERS SHALL BE PAD-LOCKABLE IN THE 'OFF' POSITION ONLY, VIA LOCK-DOGS OR SIMILAR, LOCKING TO ESCUTCHEON SHALL NOT BE ACCEPTABLE.
2. ALL SPARE SPACE SHALL BE FILLED WITH DUMMY CIRCUIT BREAKERS, ESCUTCHEON POLE FILLERS SHALL NOT BE ACCEPTABLE.
3. EQUIPOTENTIAL BONDING CONDUCTOR SHALL BE INSTALLED FROM DB EARTH BAR TO SWITCHROOM EARTH BAR OR NEAREST EARTHED STRUCTURE VIA 35mm² Cu GNYE/PVC OR AS PER CABLE SCHEDULE.
4. AS-BUILT CIRCUIT SCHEDULE SHALL BE KEPT INTERNAL TO DISTRIBUTION BOARD AT ALL TIMES.
5. MINIMUM 20% SPARE CIRCUIT BREAKERS AND ADDITIONAL 20% SPARE SPACE SHALL BE PROVIDED FOR FUTURE LOADS.
6. DISTRIBUTION BOARD SHALL BE CONSTRUCTED IN ACCORDANCE WITH STANDARD - 2000-F00-STS-EL-10007. LOW VOLTAGE DISTRIBUTION BOARDS SPECIFICATION.
7. UPS MAINTENANCE BYPASS SWITCH SHALL BE OF THE ROTARY 3-POSITION TYPE. POSITIONS AS FOLLOWS:
   NORMAL MODE: SWITCH A & C CLOSED
   BYPASS MODE: SWITCH A & B CLOSED
   BYPASS & ISOLATE MODE: SWITCH B CLOSED.
8. SPARE CABLE CORES TO BE TAPED BACK, HEAT SHRINK APPLIED TO BOTH ENDS AND MADE SAFE. (1)

## LEGEND

- MCC TERMINAL
- VSD TERMINAL
- FIELD TERMINAL
- PLC OR I/O TERMINAL
- MARSHALLING TERMINAL
- DISTRIBUTION BOARD TERMINAL
- DEVICE TERMINAL
- INDICATION LAMP cc = COLOUR
- DUMMY CIRCUIT BREAKER NOTE 2

## CONSTRUCTION DETAILS

| | |
|---|---|
| No. OF POLES | 24 |
| MOUNTING | WALL-MOUNTED |
| MAIN SWITCH | 160A SINGLE POLE |
| INTERNAL COLOUR | ESCUTCHEON GLOSS WHITE |
| EXTERNAL COLOUR | X15 ORANGE |
| LOCATION | SWITCHROOM INTERNAL |
| IP RATING | IP4x MIN. |
| PANEL THICKNESS | 1.6mm MIN. |
| MCB FAULT RATING | 10kA |
| DOOR | PADLOCKABLE |
| MATERIAL | POWDER COATED MILD STEEL |
| DOOR SEAL | MOLDED SILICONE SEAL/NEOPRENE SEAL |
| GLAND PLATE SEAL | MOLDED SILICONE SEAL/NEOPRENE SEAL GLAND PLATE BOTTOM MOUNT ONLY |

NORTHERN STAR

| | |
|---|---|
| Approved | X |
| Approved as Noted | |
| Not Approved | |
| For Information Only | |

Signed [redacted] Date 06/01/2026

ACCEPTANCE DOES NOT RELIEVE THE SUPPLIER / CONTRACTOR OF ITS RESPONSIBILITY OR LIABILITIES UNDER THE PURCHASE ORDER / CONTRACT

| DRG No. | REFERENCES | REV | DATE | DESCRIPTION | DRAW | CHECK | DESIGN | TECH APP | PROJ APP |
|---|---|---|---|---|---|---|---|---|---|
| 2000-F22-SLD-EL-10261 | F22-SW-131 415V ESSENTIAL SWITCHBOARD SINGLE LINE DIAGRAM | 1 | 24NOV25 | FAT REDLINES INCORPORATED | | | | | |
| 2000-F00-STD-EL-10001 | GENERAL NOTES AND STANDARD DRAWINGS INDEX | 0 | 17SEP24 | APPROVED FOR CONSTRUCTION | | | | | |

NORTHERN STAR RESOURCES LIMITED

PRIMERO
primero.com.au | DESIGN | CONSTRUCT | OPERATE

PRIMERO PROJECT NUMBER: 23517

INFORMATION AND REPRESENTATIONS ON THIS DRAWING ARE THE INTELLECTUAL PROPERTY OF PRIMERO UNLESS SPECIFICALLY IDENTIFIED OTHERWISE. ALL RIGHTS INCLUDING USE RESERVED

PROJECT: NORTHERN STAR RESOURCES LTD
KCGM GROWTH PROJECT

TITLE: CIL 4 - CARBON TREATMENT & ELUTION - F22-SR-001
F22-DB-201 LV SWITCHROOM 240V UPS DB
THREE LINE DIAGRAM

| SHEET | SCALE | DRG No. | REVISION |
|---|---|---|---|
| A1 | NONE | 2000-F22-TLD-EL-10052 | 1 |

O:\CAD PROJECTS\235 NORTHERN STAR RESOURCES LTD\235T1 KCGM GROWTH PROJECT\03 DELIVERABLES\EL\F22 - CIL4 CARBON TREAMENT & ELUTION\2000-F22-TLD-EL-10052.DWG 18DEC25 12:12PM HOTSEAT04