
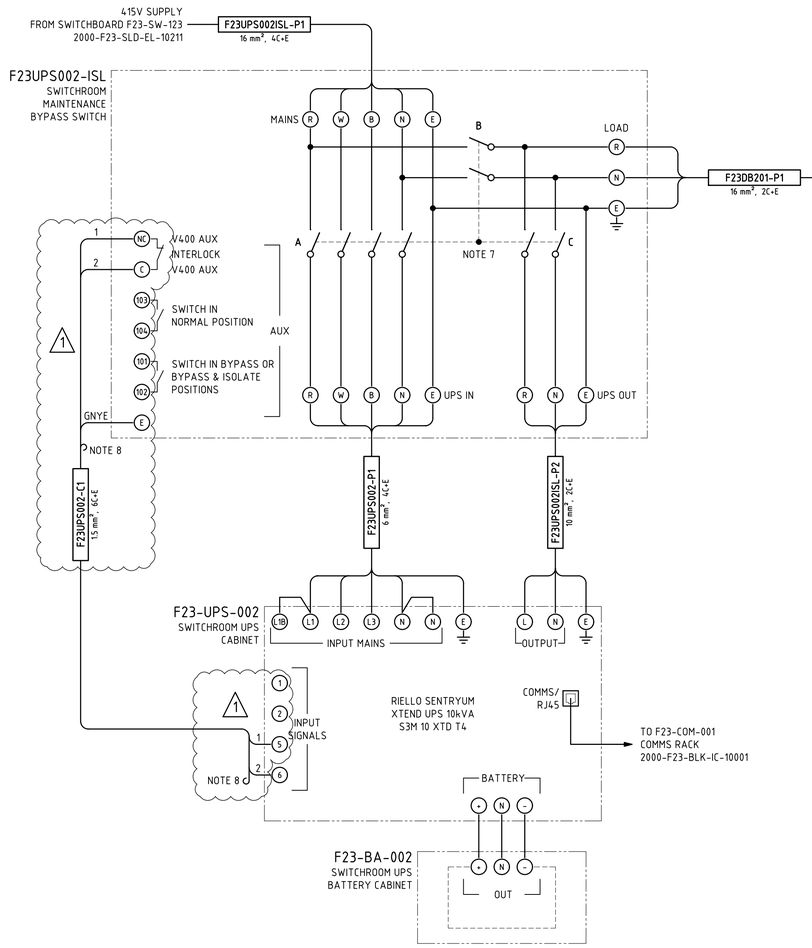


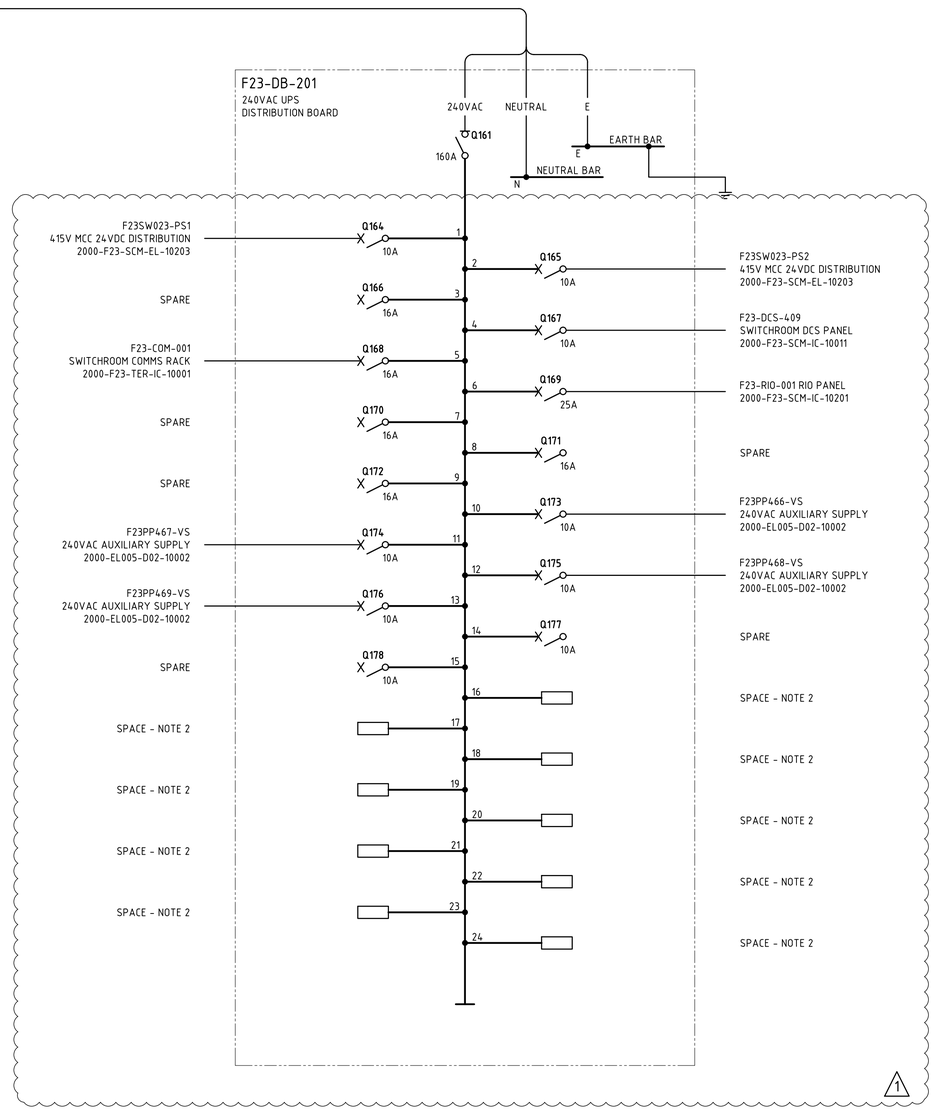

NOTES

1. CIRCUIT BREAKERS SHALL BE PAD-LOCKABLE IN THE 'OFF' POSITION ONLY, VIA LOCK-DOGS OR SIMILAR, LOCKING TO ESCUTCHEON SHALL NOT BE ACCEPTABLE.
2. ALL SPARE SPACE SHALL BE FILLED WITH DUMMY CIRCUIT BREAKERS, ESCUTCHEON POLE FILLERS SHALL NOT BE ACCEPTABLE.
3. EQUIPOTENTIAL BONDING CONDUCTOR SHALL BE INSTALLED FROM DB EARTH BAR TO SWITCHROOM EARTH BAR OR NEAREST EARTHED STRUCTURE VIA 35mm² Cu GNYE/PVC OR AS PER CABLE SCHEDULE.
4. AS-BUILT CIRCUIT SCHEDULE SHALL BE KEPT INTERNAL TO DISTRIBUTION BOARD AT ALL TIMES.
5. MINIMUM 20% SPARE CIRCUIT BREAKERS AND ADDITIONAL 20% SPARE SPACE SHALL BE PROVIDED FOR FUTURE LOADS.
6. DISTRIBUTION BOARD SHALL BE CONSTRUCTED IN ACCORDANCE WITH STANDARD - 2000-F00-STS-EL-10007. LOW VOLTAGE DISTRIBUTION BOARDS SPECIFICATION.
7. UPS MAINTENANCE BYPASS SWITCH SHALL BE OF THE ROTARY 3-POSITION TYPE. POSITIONS AS FOLLOWS:
   NORMAL MODE: SWITCH A & C CLOSED
   BYPASS MODE: SWITCH A & B CLOSED
   BYPASS & ISOLATE MODE: SWITCH B CLOSED.
8. SPARE CABLE CORES TO BE TAPED BACK, HEAT SHRINK APPLIED TO BOTH ENDS AND MADE SAFE. (1)

LEGEND

- MCC TERMINAL
- VSD TERMINAL
- FIELD TERMINAL
- PLC OR I/O TERMINAL
- MARSHALLING TERMINAL
- DISTRIBUTION BOARD TERMINAL
- DEVICE TERMINAL
- INDICATION LAMP, cc = COLOUR
- DUMMY CIRCUIT BREAKER, NOTE 2

CONSTRUCTION DETAILS

No. OF POLES	24
MOUNTING	WALL-MOUNTED
MAIN SWITCH	160A SINGLE POLE
INTERNAL COLOUR	ESCUTCHEON GLOSS WHITE
EXTERNAL COLOUR	X15 ORANGE
LOCATION	SWITCHROOM INTERNAL
IP RATING	IP4x MIN.
PANEL THICKNESS	1.6mm MIN.
MCB FAULT RATING	10kA
DOOR	PADLOCKABLE
MATERIAL	POWDER COATED MILD STEEL
DOOR SEAL	MOLDED SILICONE SEAL/NEOPRENE SEAL
GLAND PLATE SEAL	MOLDED SILICONE SEAL/NEOPRENE SEAL GLAND PLATE BOTTOM MOUNT ONLY

NORTHERN STAR RESOURCES LIMITED

Comments ☐

No Comments ☒

Signed [redacted] Date 15/10/2025

ACCEPTANCE DOES NOT RELIEVE THE SUPPLIER / CONTRACTOR OF ITS RESPONSIBILITY OR LIABILITIES UNDER THE PURCHASE ORDER / CONTRACT

DRG No.	REFERENCES
2000-F23-SLD-EL-10211	F23-SW-123 415V EMERGENCY MCC SINGLE LINE DIAGRAM
2000-F00-STD-EL-10001	GENERAL NOTES AND STANDARD DRAWINGS INDEX

REV	DATE	DESCRIPTION	DRAW	CHECK	DESIGN	TECH APP	PROJ APP
1	23SEP25	FAT REDLINES INCORPORATED					
0	17SEP24	APPROVED FOR CONSTRUCTION					

NORTHERN STAR RESOURCES LIMITED

PRIMERO
primero.com.au | DESIGN | CONSTRUCT | OPERATE

PRIMERO PROJECT NUMBER: 23517

INFORMATION AND REPRESENTATIONS ON THIS DRAWING ARE THE INTELLECTUAL PROPERTY OF PRIMERO UNLESS SPECIFICALLY IDENTIFIED OTHERWISE. ALL RIGHTS INCLUDING USE RESERVED

PROJECT: NORTHERN STAR RESOURCES LTD
KCGM GROWTH PROJECT

TITLE: FINAL TAILINGS HANDLING & STORAGE - F23-SR-002
F23-DB-201 SWITCHROOM 240V UPS DB
THREE LINE DIAGRAM

SHEET	SCALE	DRG No.	REVISION
A1	NONE	2000-F23-TLD-EL-10101	1

O:\CAD PROJECTS\235 NORTHERN STAR RESOURCES LTD\23517 KCGM GROWTH PROJECT\03 DELIVERABLES\EL\F23 - FINAL TAILINGS HANDLING & STORAGE\2000-F23-TLD-EL-10101.DWG 020CT25 9:05AM HOTSEAT04