
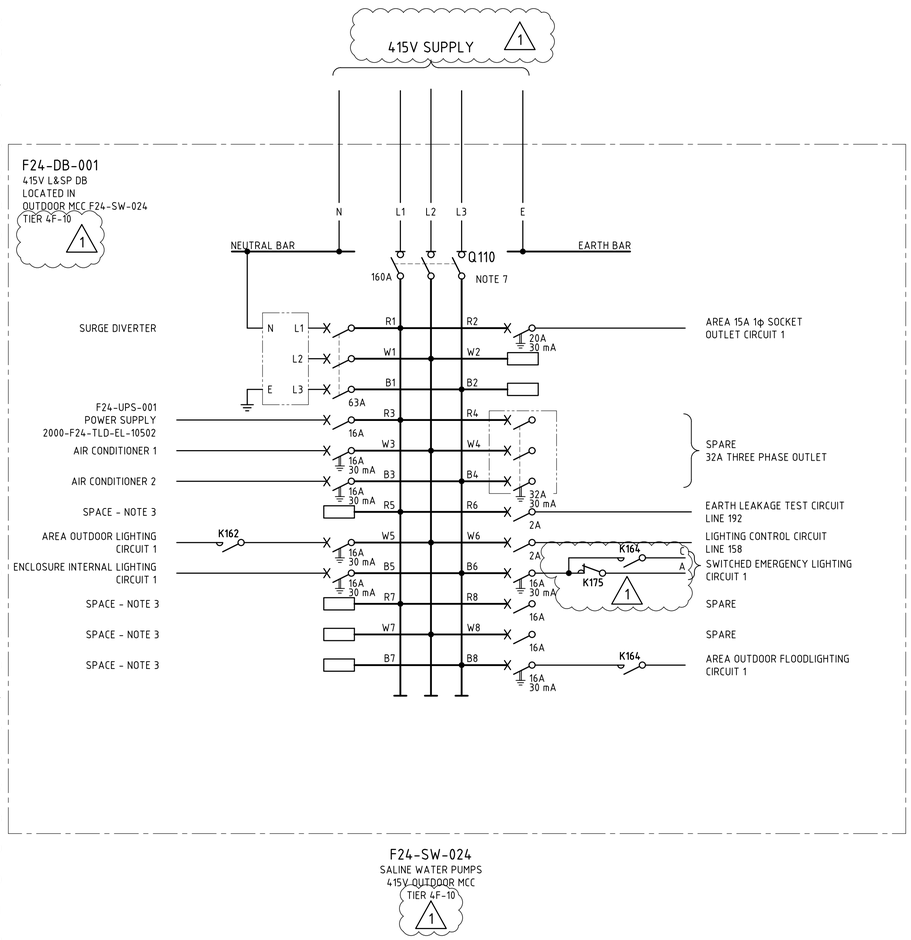


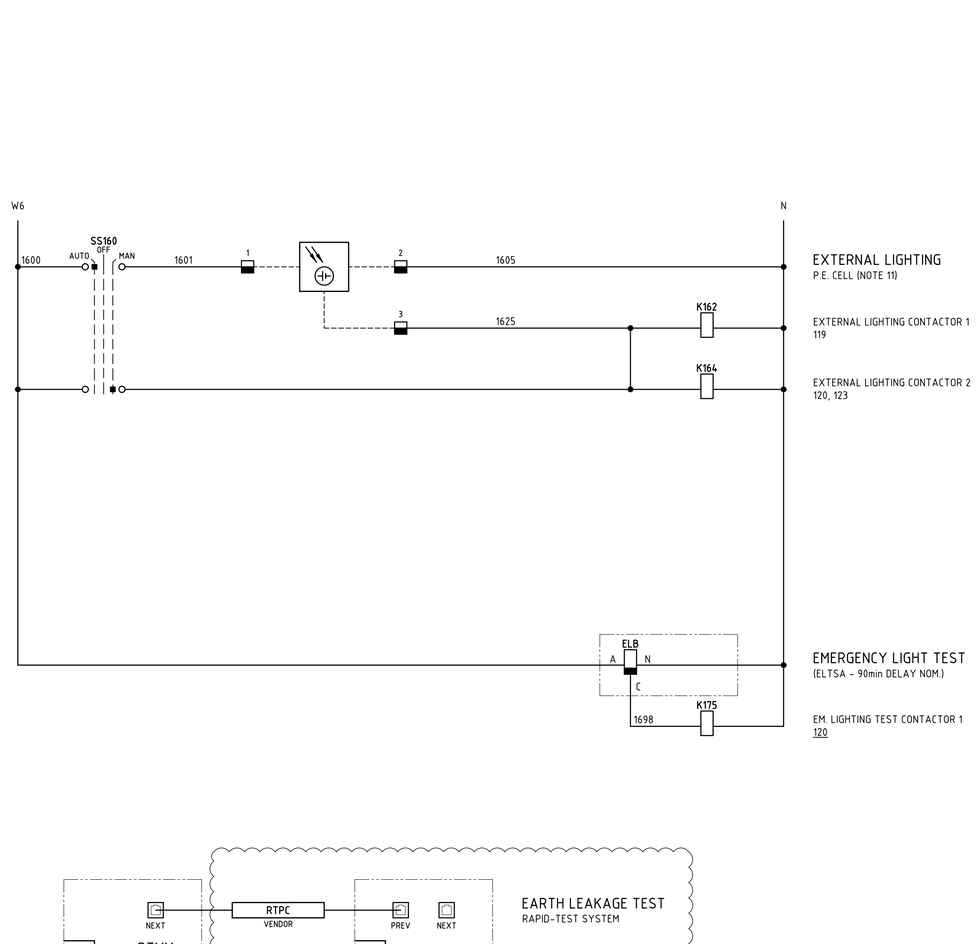

NOTES

1. THREE PHASE CIRCUITS SHALL ALWAYS BE PLACED ACROSS CIRCUIT RWB - i.e. R7, W7, B7 - NEVER ACROSS MIXED CIRCUITS i.e. B5, R7, W7.
2. CIRCUIT BREAKERS SHALL BE PAD-LOCKABLE IN THE 'OFF' POSITION ONLY, VIA LOCK-DOGS OR SIMILAR, LOCKING TO ESCUTCHEON SHALL NOT BE ACCEPTABLE.
3. ALL SPARE SPACE SHALL BE FILLED WITH DUMMY CIRCUIT BREAKERS, ESCUTCHEON POLE FILLERS SHALL NOT BE ACCEPTABLE.
4. ESCUTCHEON SHALL BE KEYED TO MAIN ISOLATOR HANDLE SUCH THAT ESCUTCHEON CANNOT BE REMOVED WHILE BOARD IS LIVE.
5. NEUTRAL CIRCUITS FED FROM RCDs MUST BE WIRED BACK TO THE NEUTRAL OF THE RCD, NOT THE NEUTRAL BAR.
6. MINIMUM 20% SPARE CIRCUIT BREAKERS AND ADDITIONAL 20% SPARE SPACE SHALL BE PROVIDED FOR FUTURE LOADS.
7. FOR PROSPECTIVE FAULT CURRENT >10kA, FUSED-SWITCH SHALL BE INSTALLED IN PLACE OF LOAD-BREAK ISOLATOR C/W HRC gG FAULT-CURRENT LIMITING FUSES, SIZED TO SUIT.
8. 6kA MINIATURE CIRCUIT BREAKERS SHALL ONLY BE USED WITH ENGINEERING APPROVAL.
9. AS-BUILT CIRCUIT SCHEDULE SHALL BE KEPT INTERNAL TO DISTRIBUTION BOARD AT ALL TIMES.
10. P.E. CELL SHALL BE INSTALLED OUT OF DIRECT LINE OF ANY LIGHTING.
11. DISTRIBUTION BOARD SHALL BE CONSTRUCTED IN ACCORDANCE WITH STANDARD - 2000-F00-STS-EL-10007. LOW VOLTAGE DISTRIBUTION BOARDS SPECIFICATION.

LEGEND

- PE CELL
- MCC TERMINAL
- VSD TERMINAL
- FIELD TERMINAL
- PLC OR I/O TERMINAL
- MARSHALLING TERMINAL
- DISTRIBUTION BOARD TERMINAL
- DEVICE TERMINAL
- INDICATION LAMP (cc = COLOUR)
- DUMMY CIRCUIT BREAKER NOTE 3

CONSTRUCTION DETAILS

BUSBAR RATING	160A 20kA for 0.2sec
No. OF POLES	24
MOUNTING	MOUNTING WITHIN F24-SW-024
LABELLING	ALL INTERNAL EQUIPMENT SHALL BE LABELLED AS PER SCHEMATIC. REFER - 2000-F00-STD-EL-10010
MAIN SWITCH	160A 3-POLE
INTERNAL COLOUR	ESCUTCHEON GLOSS WHITE
EXTERNAL COLOUR	N/A
LOCATION	LOCATED WITHIN F24-SW-024
IP RATING	N/A
PANEL THICKNESS	N/A
MCB FAULT RATING	10kA
MATERIAL	N/A
DOOR SEAL	N/A
GLAND PLATE SEAL	N/A
WEATHER PROTECTION	N/A

NORTHERN STAR RESOURCES LIMITED

Comments ☐

No Comments ☒

Signed: C Laird — Date: 30/09/2025

ACCEPTANCE DOES NOT RELIEVE THE SUPPLIER / CONTRACTOR OF ITS RESPONSIBILITY OR LIABILITIES UNDER THE PURCHASE ORDER / CONTRACT

DRG No.	REFERENCES
2000-F24-DRG-EL-10501	AIR & WATER SERVICES - SALINE WATER ELECTRICAL EQUIPMENT LAYOUT
2000-F24-SLD-EL-10501	F24-SW-024 415V MCC SINGLE LINE DIAGRAM
2000-F00-STD-EL-10001	GENERAL NOTES AND STANDARD DRAWINGS INDEX

REV	DATE	DESCRIPTION	DRAW	CHECK	DESIGN	TECH APP	PROJ APP
1	10SEP25	FAT REDLINES INCORPORATED				MB	
0	29JAN25	APPROVED FOR CONSTRUCTION					

NORTHERN STAR RESOURCES LIMITED

PRIMERO — primero.com.au | DESIGN | CONSTRUCT | OPERATE

PRIMERO PROJECT NUMBER: 23517

INFORMATION AND REPRESENTATIONS ON THIS DRAWING ARE THE INTELLECTUAL PROPERTY OF PRIMERO UNLESS SPECIFICALLY IDENTIFIED OTHERWISE. ALL RIGHTS INCLUDING USE RESERVED

PROJECT: NORTHERN STAR RESOURCES LTD
KCGM GROWTH PROJECT

TITLE: AIR & WATER SERVICES - F24-SW-024
F24-DB-001 OUTDOOR MCC 415V L&SP DB
THREE LINE DIAGRAM

SHEET	SCALE	DRG No.	REVISION
A1	NTS	2000-F24-TLD-EL-10501	1

O:\CAD PROJECTS\235 NORTHERN STAR RESOURCES LTD\23517 KCGM GROWTH PROJECT\03 DELIVERABLES\ELV\F24 - AIR & WATER SERVICES\2000-F24-TLD-EL-10501.DWG 16SEP25 4:05PM HOTSEAT04