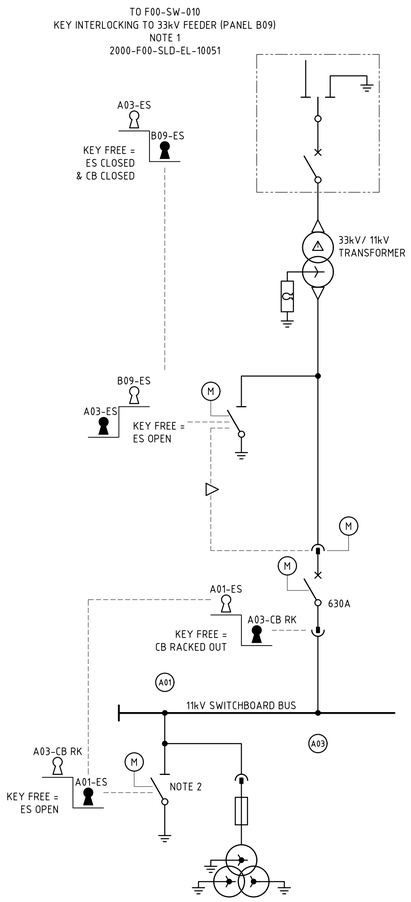


F28-SW-013 11kV INCOMER & BUS
EARTH SWITCH KEY
INTERLOCKING SCHEME
ALL INTERLOCKING IS SINGLE KEY
1 OUT OF 2 INTERLOCKING

NOTES

1. UPSTREAM 33kV FEEDER 3 POSITION SWITCH KEY INTERLOCKED WITH THE 11kV SWITCHBOARD INCOMER EARTH SWITCH SUCH THAT THE UPSTREAM 3 POSITION SWITCH MUST BE CLOSED IN THE EARTH POSITION AND THE FEEDER CIRCUIT BREAKER CLOSED WHEN THE 11kV INCOMER EARTH SWITCH IS CLOSED.
2. BUS EARTH SWITCH AND INCOMER CIRCUIT BREAKER SHALL BE KEY INTERLOCKED SUCH THAT BUS EARTH SWITCH CANNOT BE CLOSED WHILE INCOMER CIRCUIT BREAKER IS RACKED IN.

LEGEND

- MECHANICAL OR ELECTRICAL INTERLOCK DEVICE
- KEY FREE
- KEY CAPTIVE

DRG No.	REFERENCES
2000-F00-LST-EL-11004	ELECTRICAL INTERLOCKING SCHEDULE
2000-F28-DRG-EL-10001	F28-SR-001 11kV ULTRAFINE GRINDING TAILS SWITCHROOM ELECTRICAL EQUIPMENT LAYOUT
2000-F28-SLD-EL-10001	F28-SW-013 ULTRAFINE GRINDING 2/3 11kV SWITCHBOARD SINGLE LINE DIAGRAM
2000-F00-SLD-EL-10001	OVERALL SITEWIDE SINGLE LINE DIAGRAM
2000-F00-STD-EL-10001	GENERAL NOTES AND STANDARD DRAWINGS INDEX

REV	DATE	DESCRIPTION	DRAW	CHECK	DESIGN	TECH APP	PROJ APP
2	02OCT26	KCGM GROWTH PROJECT - SP1 AS-BUILT					
1	16SEP25	FAT REDLINES INCORPORATED - NO CHANGE					
0	19NOV24	APPROVED FOR CONSTRUCTION					

NORTHERN STAR RESOURCES LIMITED

PRIMERO
primero.com.au | DESIGN | CONSTRUCT | OPERATE

PRIMERO PROJECT NUMBER: 23517

INFORMATION AND REPRESENTATIONS ON THIS DRAWING ARE THE INTELLECTUAL PROPERTY OF PRIMERO UNLESS SPECIFICALLY IDENTIFIED OTHERWISE. ALL RIGHTS INCLUDING USE RESERVED

PROJECT: NORTHERN STAR RESOURCES LTD
KCGM GROWTH PROJECT

TITLE: ULTRA FINE GRINDING 2/3
F28-SW-013 11kV SWITCHBOARD
KEY INTERLOCKING SINGLE LINE DIAGRAM

SHEET	SCALE	DRG No.	REVISION
A1	NONE	2000-F28-SLD-EL-10051	2

O:\CAD PROJECTS\235 NORTHERN STAR RESOURCES LTD\23517 KCGM GROWTH PROJECT\03 DELIVERABLES\ELV\F28 - ULTRAFINE GRINDING 2 & 3\2000-F28-SLD-EL-10051.DWG 29SEP26 7:27AM ROBIN.LAW