
SUBSTATION No. 35
MILLING CIRCUIT 2 FILTRATION/GOLDROOM

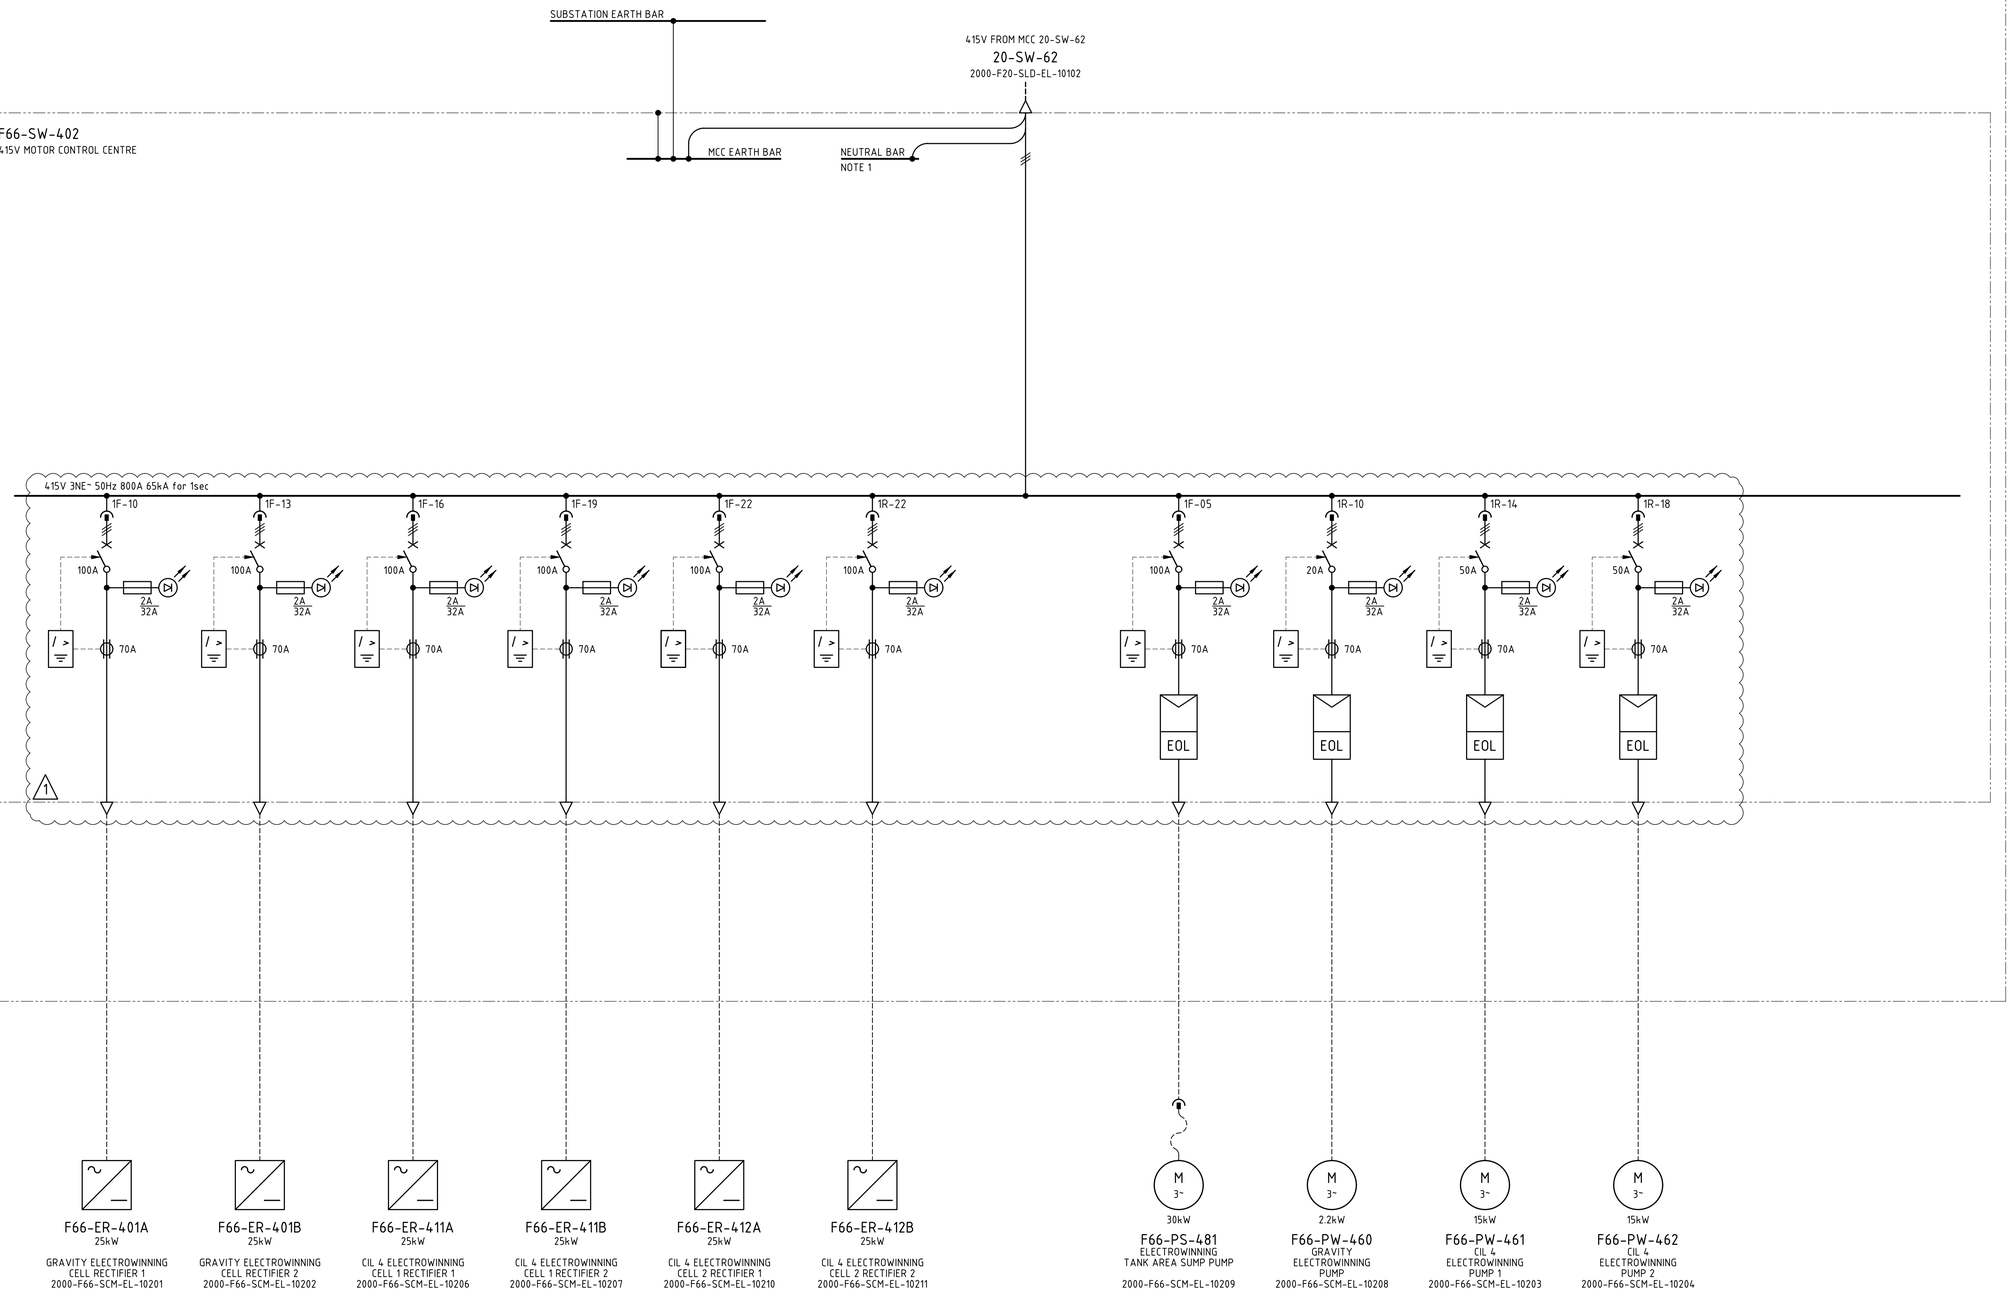

NOTES

1. EARTH-NEUTRAL LINK INSTALLED IN UPSTREAM 20-SW-62 INCOMER. SIGNAGE SHALL BE PLACED ON F66-SW-402 INCOMING SUPPLY SECTION READING "M.E.N. LINK LOCATED IN 20-SW-62".
2. SWITCHBOARD VENDOR SHALL SELECT SWITCHGEAR TO PROVIDE TYPE-2 CO-ORDINATION SUITABLE FOR HIGH EFFICIENCY MOTORS.
3. ALL DRIVE I/O VIA COMMS NETWORK TO DCS.
4. ANY DRIVE RTDs SHALL BE WIRED TO DEDICATED REMOTE I/O CARDS IN THE FIELD. RTD RELAYS MAY BE INCLUDED IN THE MCC MODULE WITH ENGINEERING APPROVAL.
5. CIRCUIT BREAKER TO BE SUBSTITUED FOR FUSED-SWITCH WHERE REQUIRED BY EQUIPMENT MANUFACTURERS GUIDELINES.

LEGEND

- DIRECT ON-LINE MOTOR STARTER GENERIC
- EOL — ELECTRONIC OVERLOAD UNIT
- I > — EARTH LEAKAGE RELAY
- FIELD-MOUNTED DECONTACTOR
- CIRCUIT BREAKER (NOTE 5)
  - xxxA — ST TRIP SET POINT
  - xxxA — CB SIZE

Approved	☒
Approved as Noted	☐
Not Approved	☐
For Information Only	☐

Signed [redacted] Date 21/1/2025

ACCEPTANCE DOES NOT RELIEVE THE SUPPLIER / CONTRACTOR OF ITS RESPONSIBILITY OR LIABILITIES UNDER THE PURCHASE ORDER / CONTRACT

DRG No.	REFERENCES	REV	DATE	DESCRIPTION	DRAW	CHECK	DESIGN	TECH APP	PROJ APP
2000-F20-DRG-EL-10001	SUBSTATION NO. 35 MCC AND GENERAL EQUIPMENT LAYOUT								
2000-F20-SLD-EL-10102	SUBSTATION NO. 35 MCC 20-SW-62 SINGLE LINE DIAGRAM SHEET 1	1	29OCT25	FAT REDLINES INCORPORATED	[redacted]				
2000-F00-STD-EL-10001	GENERAL NOTES AND STANDARD DRAWING INDEX	0	17MAR25	APPROVED FOR CONSTRUCTION	[redacted]	[redacted]	[redacted]	[redacted]	[redacted]

NORTHERN STAR RESOURCES LIMITED

PRIMERO
primero.com.au | DESIGN | CONSTRUCT | OPERATE

PRIMERO PROJECT NUMBER: 23517

INFORMATION AND REPRESENTATIONS ON THIS DRAWING ARE THE INTELLECTUAL PROPERTY OF PRIMERO UNLESS SPECIFICALLY IDENTIFIED OTHERWISE. ALL RIGHTS INCLUDING USE RESERVED

PROJECT: NORTHERN STAR RESOURCES LTD
KCGM GROWTH PROJECT

TITLE: FIMISTON PLANT - MILLING CCT. 2 FILTRATION/GOLDROOM
SUBSTATION NO. 35 MCC F66-SW-402
SINGLE LINE DIAGRAM

SHEET	SCALE	DRG No.	REVISION
A1	NONE	2000-F66-SLD-EL-10101	1

O:\CAD PROJECTS\235 NORTHERN STAR RESOURCES LTD\23517 KCGM GROWTH PROJECT\03 DELIVERABLES\EL\F66 - ELECTROWINNING & GOLDROOM\2000-F66-SLD-EL-10101.DWG 13NOV25 12:39PM HOTSEAT04