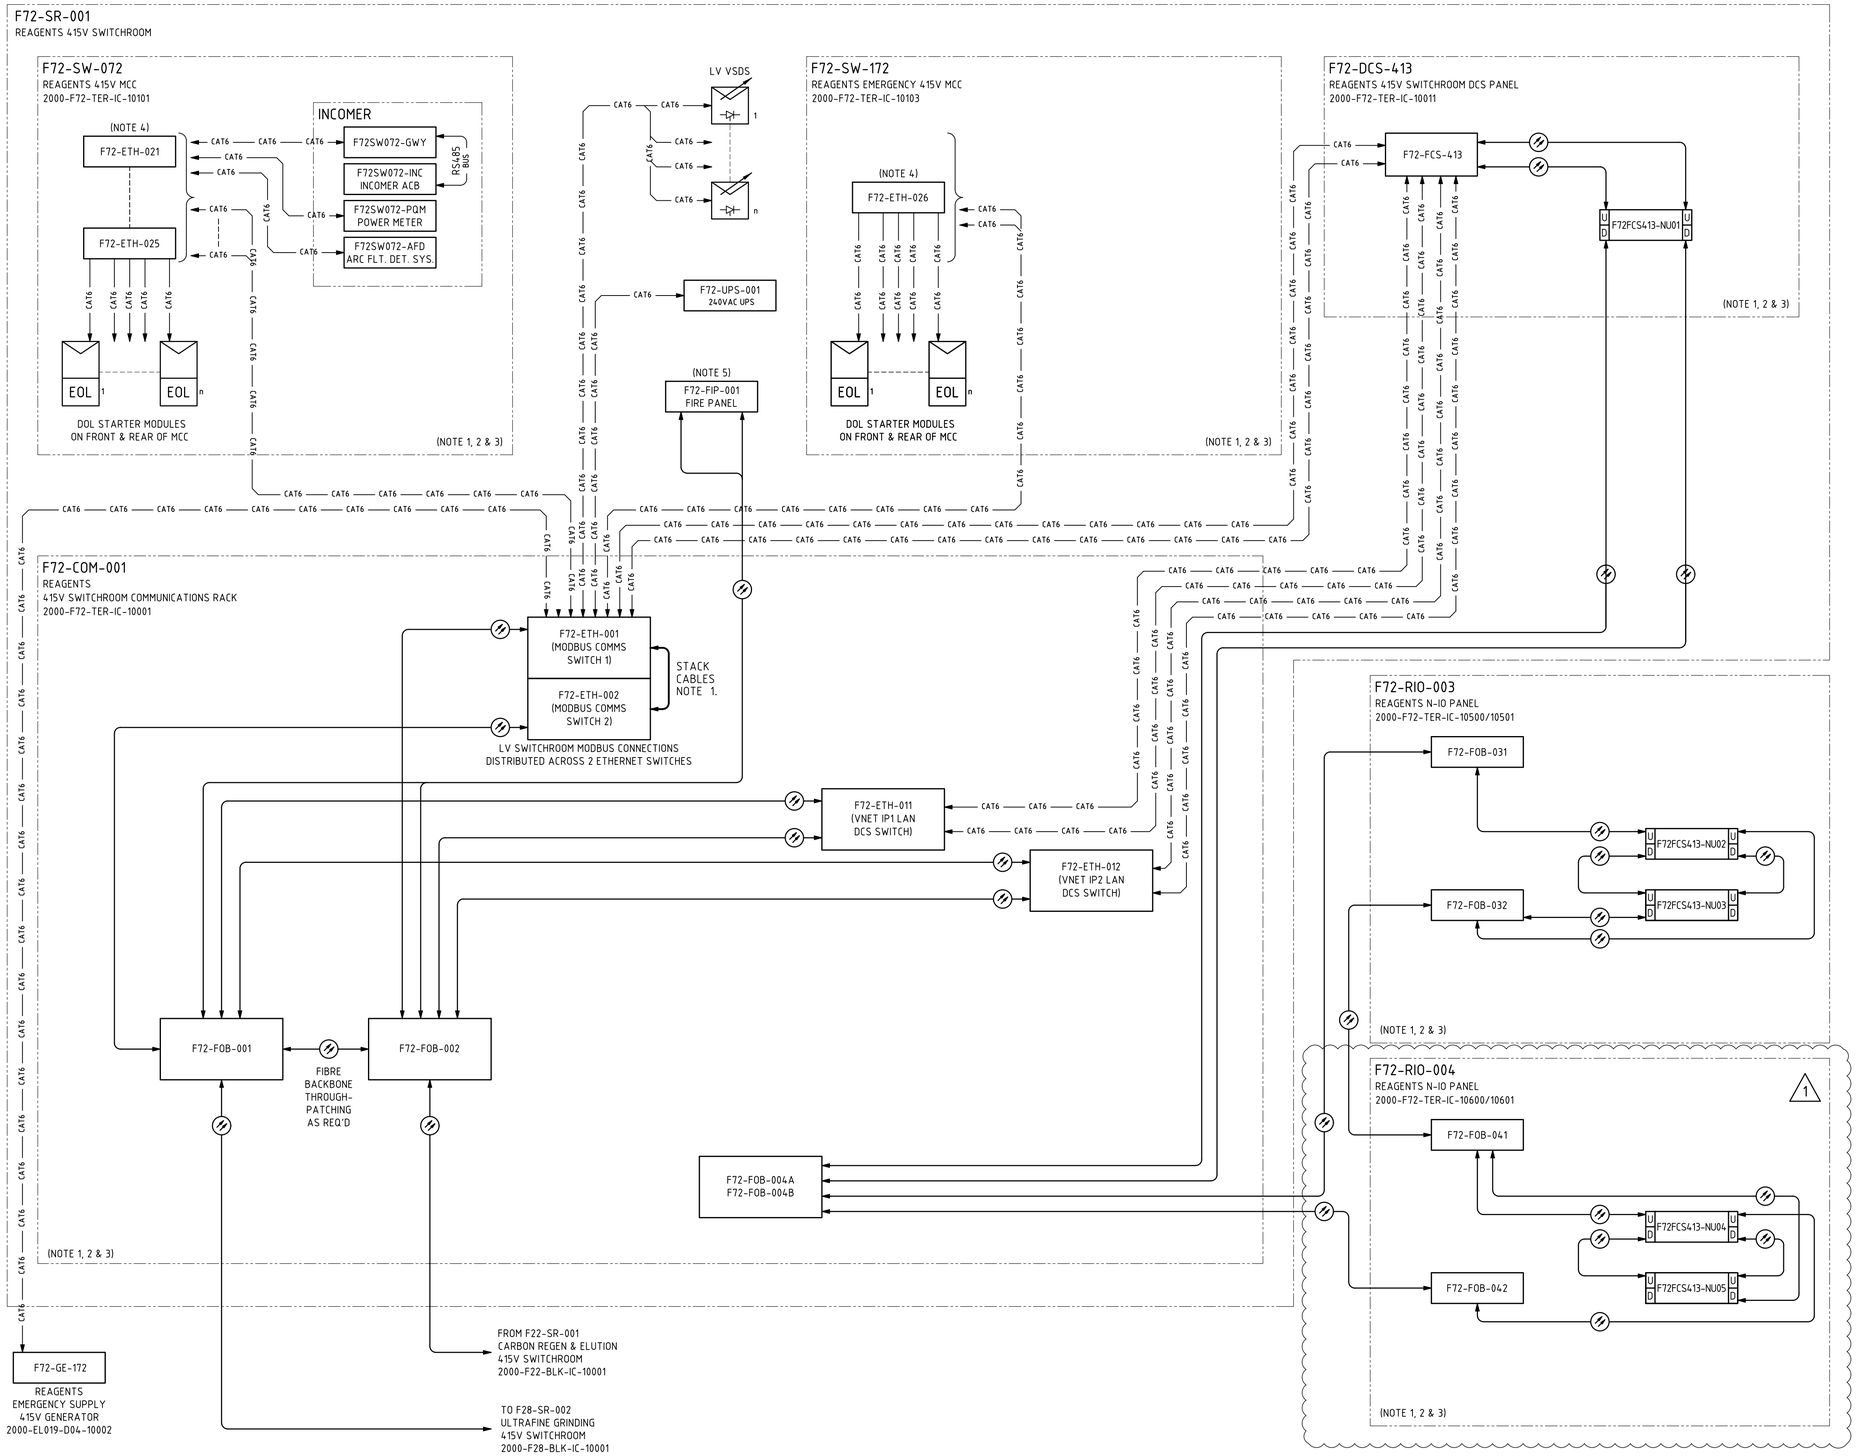


NOTES

1. FOR INTERNAL FIBRE OPTIC, CAT6 PATCH LEAD (& STACK CABLING IN SWITCHROOM COMMS CABINETS) EQUIPMENT CONNECTION DETAILS REFER TO SPECIFIC TERMINATION DIAGRAMS.
2. REFER TO SPECIFIC COMMUNICATIONS TERMINATION DRAWINGS FOR EXTERNAL EQUIPMENT CONNECTION DETAIL.
3. COM CABINET, DCS PANEL, RIO PANEL, MCC & SWITCHBOARD HARDWARE/INTERCONNECTIONS (E.G. NIO NODE) & INTER-FOBOT PATCHING NOT SHOWN FOR CLARITY. REFER TO SPECIFIC COMMUNICATIONS TERMINATION DRGS FOR DETAIL.
4. ETHERNET SWITCHES LOCATED IN CABLE ZONE OF 415VAC MCC, FRONT & BACK - AS REQUIRED.
5. FIRE INDICATION PANELS SHALL BE ON A FIBRE OPTIC RING AND WILL TIE-IN TO EXISTING MAIN PLANT FIRE ANNUNCIATOR PANEL. FIP CONNECTS TO FIBRE INFRASTRUCTURE VIA 2 FIBRE OPTIC PATCH CABLES.

Approved	X
Approved as Noted	
Not Approved	
For Information Only	

Signed [redacted] Date 13.08.2025

ACCEPTANCE DOES NOT RELIEVE THE SUPPLIER / CONTRACTOR OF ITS RESPONSIBILITY OR LIABILITIES UNDER THE PURCHASE ORDER / CONTRACT

LEGEND

FOB	FIBRE OPTIC BREAK OUT TRAY
ETH	ETHERNET SWITCH HIRSCHMANN = DCS NETWORKS CISCO = ALL OTHER NETWORKS
FCS	YOKOGAWA FIELD CONTROL UNIT
U xxxFCS4xx-NUxx D	YOKOGAWA NODE INTERFACE UNIT (DUAL OPTICAL ESB PORTS: U = UPLINK, D = DOWNLINK) TAG RELATED TO PARENT FCS
GWY	COMMUNICATIONS GATEWAY
MC	FIBRE TO CAT6 MEDIA CONVERTER
xxx	EQUIPMENT OR VENDOR PACKAGE PANELS AS NOTED WITHIN BLOCK.
EOL	MCC MODULE DOL INTELLIGENT ELECTRONIC DEVICE/OVERLOAD
UPS	UNINTERRUPTIBLE POWER SUPPLY
	VSD - VARIABLE SPEED DRIVE (WALL MOUNTED)
	MULTI CORE FIBRE OPTIC CABLE OR DUPLEX PATCH LEADS
CAT6	CAT6 ETHERNET CABLE CONNECTION

DRG No.	REFERENCES
2000-F72-TER-IC-10101	F72-SW-072 SWITCHROOM MCC COMMUNICATIONS TERMINATION DRAWING
2000-F72-TER-IC-10011	F72-DCS-413 415V SWITCHROOM DCS PANEL COMMUNICATIONS TERMINATION DIAGRAM
2000-F72-TER-IC-10001	SWITCHROOM COM RACK COMMUNICATIONS TERMINATION DIAGRAM SHEET 1 (TO SHEET 4 -10004)
2000-F00-BLK-IC-10001	OVERALL SITEWIDE FIBRE OPTIC COMMUNICATIONS BLOCK DIAGRAM
2000-F00-BLK-IC-10011	OVERALL SITEWIDE NETWORK ARCHITECTURE BLOCK DIAGRAM SHEET 1 (TO SHEET 5 -10015)
2000-F00-STD-EL-10001	GENERAL NOTES AND STANDARD DRAWINGS INDEX

REV	DATE	DESCRIPTION	DRAW	CHECK	DESIGN	TECH APP	PROJ APP
1	08AUG25	F72-RIO-004 ADDED					
0	11MAR25	APPROVED FOR CONSTRUCTION					

INFORMATION AND REPRESENTATIONS ON THIS DRAWING ARE THE INTELLECTUAL PROPERTY OF PRIMERO UNLESS SPECIFICALLY IDENTIFIED OTHERWISE. ALL RIGHTS INCLUDING USE RESERVED

NORTHERN STAR RESOURCES LIMITED

PRIMERO
primero.com.au | DESIGN | CONSTRUCT | OPERATE

PRIMERO PROJECT NUMBER: 23517

PROJECT: NORTHERN STAR RESOURCES LTD
KCGM GROWTH PROJECT

TITLE: REAGENTS MIXING & STORAGE
F72-SR-001 415V SWITCHROOM & N-IO PANELS
COMMUNICATIONS BLOCK DIAGRAM

SHEET	SCALE	DRG No.	REVISION
A1	NONE	2000-F72-BLK-IC-10001	1

O:\CAD PROJECTS\235 NORTHERN STAR RESOURCES LTD\23517 KCGM GROWTH PROJECT\03 DELIVERABLES\IC\F72 - REAGENTS MIXING & STORAGE\2000-F72-BLK-IC-10001.DWG 06AUG25 3:28PM HOTSEAT04