

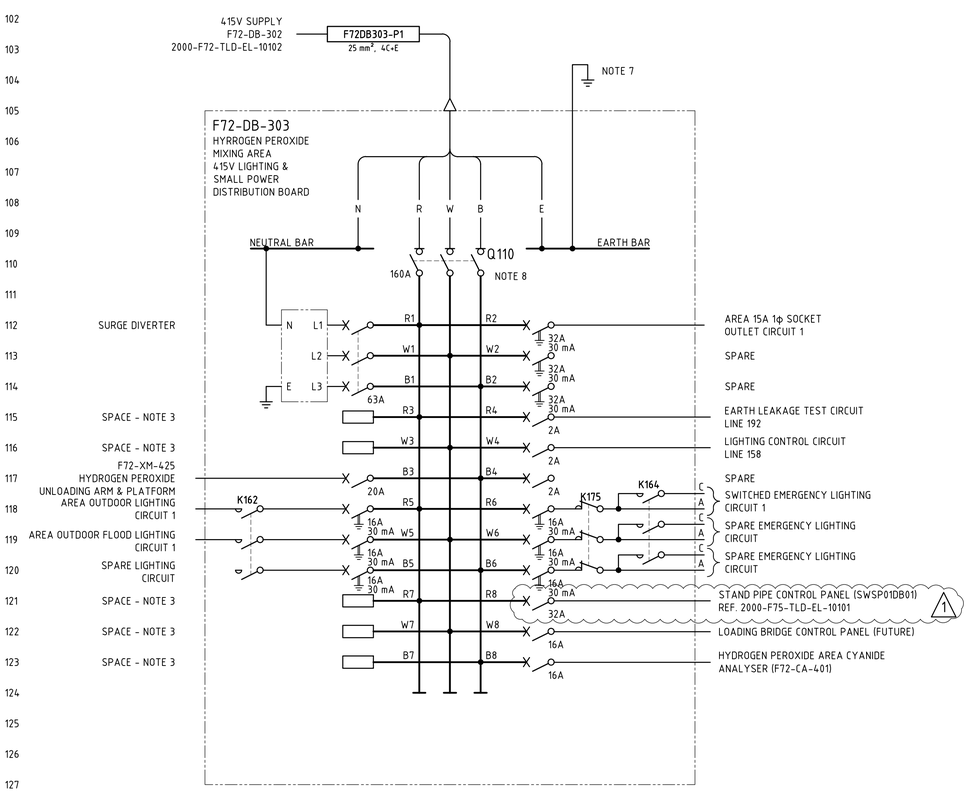


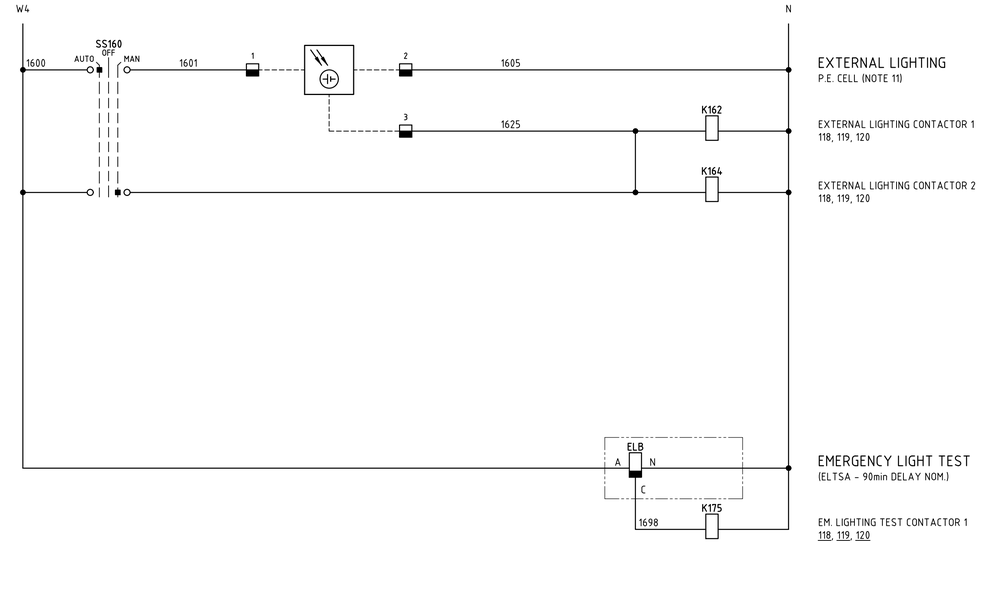

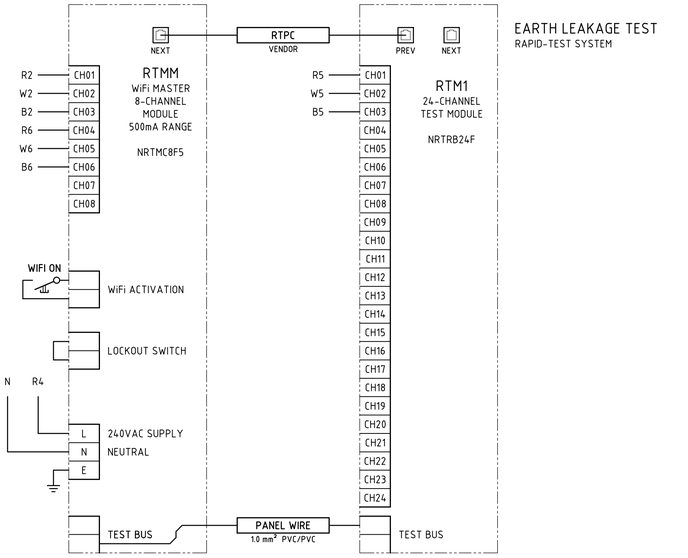

NOTES

1. THREE PHASE CIRCUITS SHALL ALWAYS BE PLACED ACROSS CIRCUIT RWB - i.e. R7, W7, B7 - NEVER ACROSS MIXED CIRCUITS i.e. B5, R7, W7.
2. CIRCUIT BREAKERS SHALL BE PAD-LOCKABLE IN THE 'OFF' POSITION ONLY, VIA LOCK-DOGS OR SIMILAR, LOCKING TO ESCUTCHEON SHALL NOT BE ACCEPTABLE.
3. ALL SPARE SPACE SHALL BE FILLED WITH DUMMY CIRCUIT BREAKERS, ESCUTCHEON POLE FILLERS SHALL NOT BE ACCEPTABLE.
4. ESCUTCHEON SHALL BE KEYED TO MAIN ISOLATOR HANDLE SUCH THAT ESCUTCHEON CANNOT BE REMOVED WHILE BOARD IS LIVE.
5. NEUTRAL CIRCUITS FED FROM RCDs MUST BE WIRED BACK TO THE NEUTRAL OF THE RCD, NOT THE NEUTRAL BAR.
6. MINIMUM 20% SPARE CIRCUIT BREAKERS AND ADDITIONAL 20% SPARE SPACE SHALL BE PROVIDED FOR FUTURE LOADS.
7. EQUIPOTENTIAL BONDING CONDUCTOR SHALL BE INSTALLED FROM DISTRIBUTION BOARD EARTH BAR TO THE RUNNING EARTH IN THE CABLE LADDER, THIS EARTH BOND CABLE SHALL BE 35mm² Cu GNYE/PVC.
8. FOR PROSPECTIVE FAULT CURRENT >10kA, FUSED-SWITCH SHALL BE INSTALLED IN PLACE OF LOAD-BREAK ISOLATOR C/W HRC gG FAULT-CURRENT LIMITING FUSES, SIZED TO SUIT.
9. 6kA MINIATURE CIRCUIT BREAKERS SHALL ONLY BE USED WITH ENGINEERING APPROVAL.
10. AS-BUILT CIRCUIT SCHEDULE SHALL BE KEPT INTERNAL TO DISTRIBUTION BOARD AT ALL TIMES.
11. P.E. CELL SHALL BE INSTALLED OUT OF DIRECT LINE OF ANY LIGHTING.
12. REFER GENERAL ARRANGEMENT 2000-F00-STD-EL-10021 FOR ALL WIRING AND CONSTRUCTION DETAILS.
13. DISTRIBUTION BOARD SHALL BE CONSTRUCTED IN ACCORDANCE WITH STANDARD - 2000-F00-STS-EL-10007. LOW VOLTAGE DISTRIBUTION BOARDS SPECIFICATION.

LEGEND

- PE CELL
- MCC TERMINAL
- VSD TERMINAL
- FIELD TERMINAL
- PLC OR I/O TERMINAL
- MARSHALLING TERMINAL
- DISTRIBUTION BOARD TERMINAL
- DEVICE TERMINAL
- INDICATION LAMP (cc = COLOUR)
- DUMMY CIRCUIT BREAKER (NOTE 3)

CONSTRUCTION DETAILS

BUSBAR RATING	250A 20kA for 0.2sec
No. OF POLES	24
MOUNTING	WALL-MOUNTED (WITH EXTERNAL MOUNTING TABS PRE-DRILLED Ø14mm)
LABELLING	ALL INTERNAL EQUIPMENT SHALL BE LABELLED AS PER SCHEMATIC. REFER - 2000-F00-STD-EL-10010
MAIN SWITCH	160A 3-POLE
INTERNAL COLOUR	ESCUTCHEON GLOSS WHITE
EXTERNAL COLOUR	BARE STAINLESS
LOCATION	OUTDOORS
IP RATING	IP65 MIN.
PANEL THICKNESS	MINIMUM 2.0mm
MCB FAULT RATING	10kA
MATERIAL	316 STAINLESS STEEL
DOOR SEAL	MOLDED SILICONE SEAL/ NEOPRENE SEAL
GLAND PLATE SEAL	MOLDED SILICONE SEAL/ NEOPRENE SEAL
WEATHER PROTECTION	OUTDOORS DISTRIBUTION BOARDS SHALL BE PROVIDED WITH SLOPING RAIN HOOD WITH GUTTERING WHICH SHALL DIRECT WATER AWAY FROM THE DOORS

DRG No.	REFERENCES
2000-F72-TLD-EL-10102	F72-DB-302 415V L&SM DB THREE LINE DIAGRAM
2000-F72-DRG-EL-10701	F72 AREA ELECTRICAL EQUIPMENT LAYOUT
2000-F72-DRG-EL-10103	F72-DB-303 FIELD 415V L&SP DB GENERAL ARRANGEMENT
2000-F00-STD-EL-10001	GENERAL NOTES AND STANDARD DRAWINGS INDEX

REV	DATE	DESCRIPTION	DRAW	CHECK	DESIGN	TECH APP	PROJ APP
1	17JUL26	SUPPLY TO STAND PIPE CONTROL PANEL - SWSP01DB01 ADDED			JH	JH	
0	11FEB25	APPROVED FOR CONSTRUCTION					

NORTHERN STAR RESOURCES LIMITED

PRIMERO
primero.com.au | DESIGN | CONSTRUCT | OPERATE

PRIMERO PROJECT NUMBER: 23517

INFORMATION AND REPRESENTATIONS ON THIS DRAWING ARE THE INTELLECTUAL PROPERTY OF PRIMERO UNLESS SPECIFICALLY IDENTIFIED OTHERWISE. ALL RIGHTS INCLUDING USE RESERVED

PROJECT: NORTHERN STAR RESOURCES LTD
KCGM GROWTH PROJECT

TITLE: REAGENTS MIXING AND STORAGE
F72-DB-303 HYD. PEROXIDE MIXING AREA 415V L&SP DB
THREE LINE DIAGRAM

SHEET	SCALE	DRG No.	REVISION
A1	NTS	2000-F72-TLD-EL-10103	1

O:\CAD PROJECTS\235 NORTHERN STAR RESOURCES LTD\23517 KCGM GROWTH PROJECT\03 DELIVERABLES\ELV\F72 - REAGENTS MIXING & STORAGE\2000-F72-TLD-EL-10103.DWG 21JUL26 4:13PM GRENVILLE.DEASY