
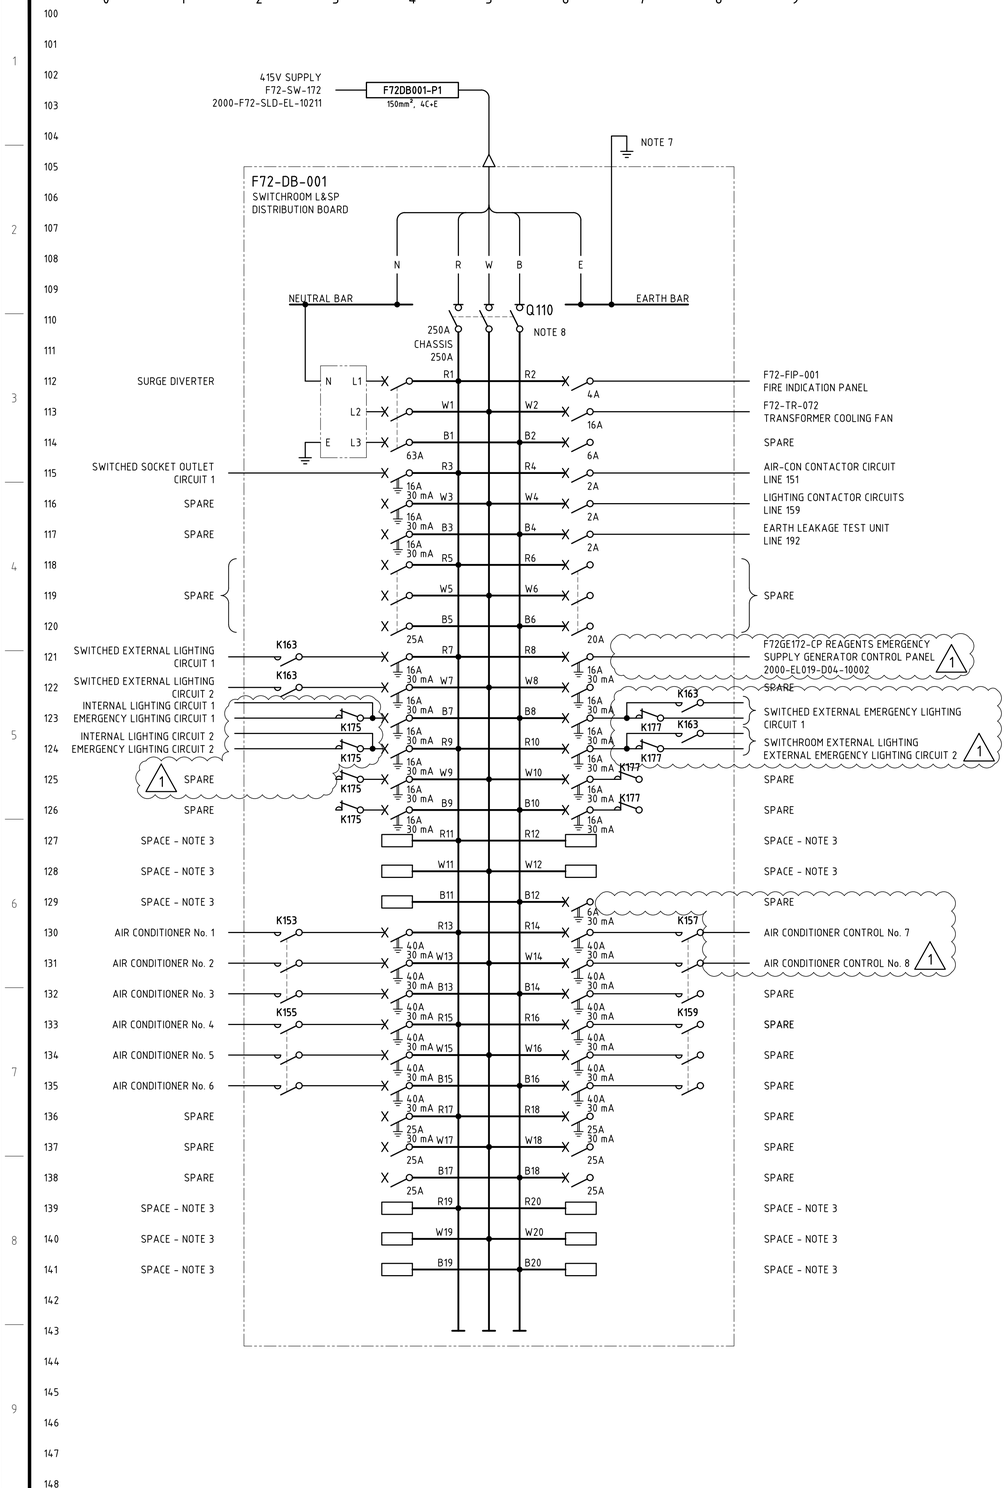


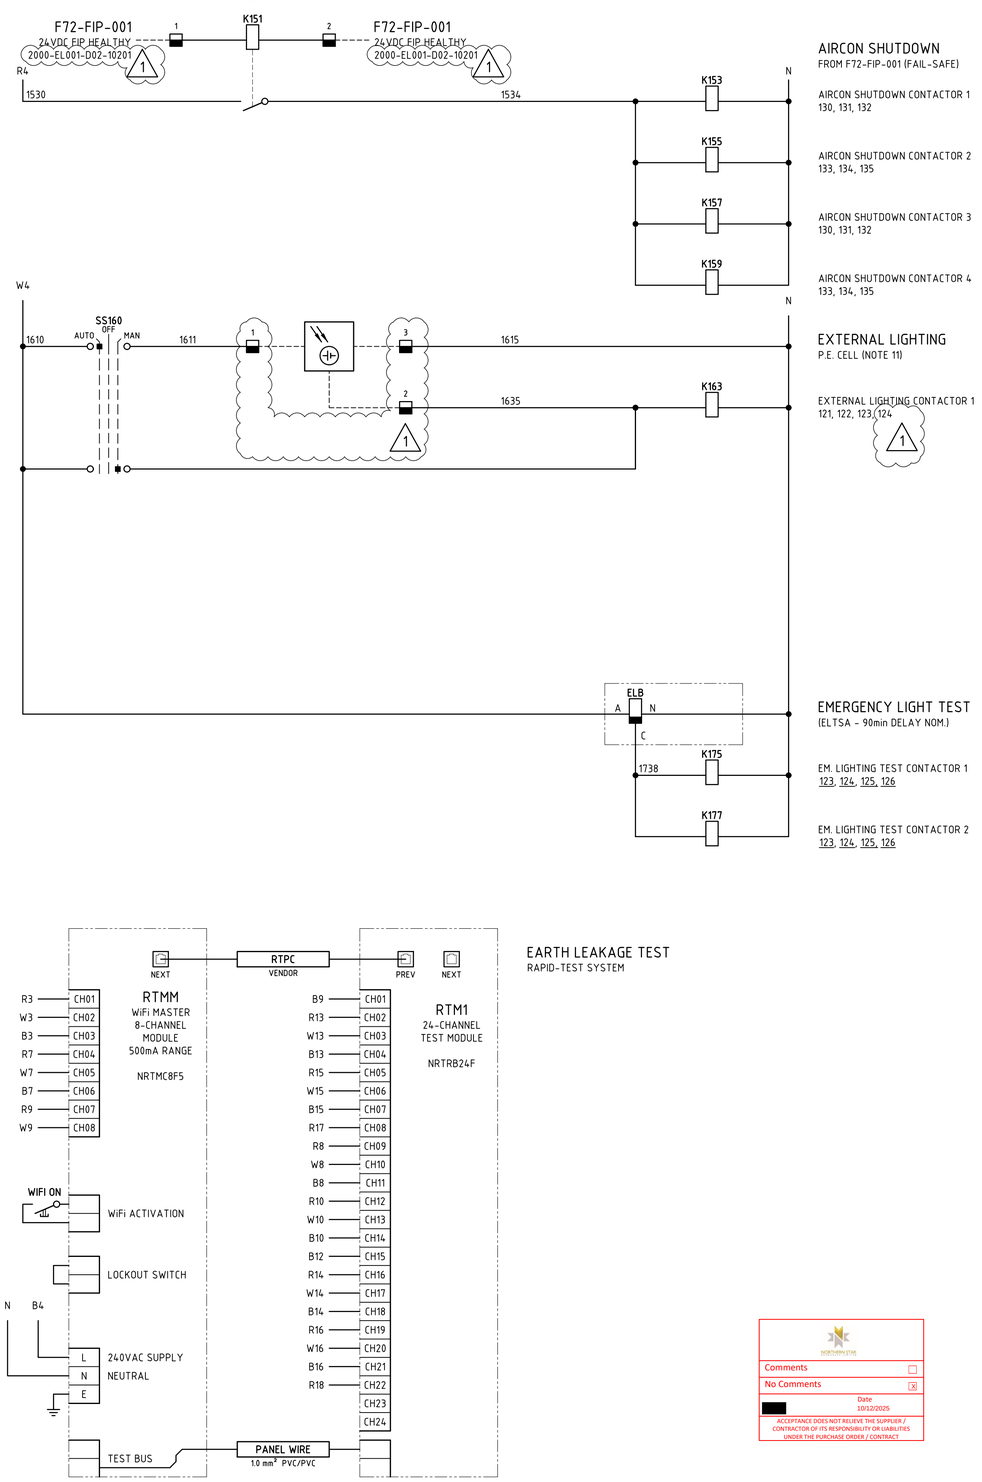

NOTES

1. THREE PHASE CIRCUITS SHALL ALWAYS BE PLACED ACROSS CIRCUIT RWB - i.e. R7, W7, B7 - NEVER ACROSS MIXED CIRCUITS i.e. B5, R7, W7.
2. CIRCUIT BREAKERS SHALL BE PAD-LOCKABLE IN THE 'OFF' POSITION ONLY, VIA LOCK-DOGS OR SIMILAR, LOCKING TO ESCUTCHEON SHALL NOT BE ACCEPTABLE.
3. ALL SPARE SPACE SHALL BE FILLED WITH DUMMY CIRCUIT BREAKERS, ESCUTCHEON POLE FILLERS SHALL NOT BE ACCEPTABLE.
4. ESCUTCHEON SHALL BE KEYED TO MAIN ISOLATOR HANDLE SUCH THAT ESCUTCHEON CANNOT BE REMOVED WHILE BOARD IS LIVE.
5. NEUTRAL CIRCUITS FED FROM RCDs MUST BE WIRED BACK TO THE NEUTRAL OF THE RCD, NOT THE NEUTRAL BAR.
6. MINIMUM 20% SPARE CIRCUIT BREAKERS AND ADDITIONAL 20% SPARE SPACE SHALL BE PROVIDED FOR FUTURE LOADS.
7. EQUIPOTENTIAL BONDING CONDUCTOR SHALL BE INSTALLED FROM DB EARTH BAR TO SWITCHROOM EARTH BAR OR NEAREST EARTHED STRUCTURE VIA 35mm² Cu GNYE/PVC OR AS PER CABLE SCHEDULE.
8. FOR PROSPECTIVE FAULT CURRENT >10kA, FUSED-SWITCH SHALL BE INSTALLED IN PLACE OF LOAD-BREAK ISOLATOR C/W HRC gG FAULT-CURRENT LIMITING FUSES, SIZED TO SUIT.
9. 6kA MINIATURE CIRCUIT BREAKERS SHALL ONLY BE USED WITH ENGINEERING APPROVAL.
10. AS-BUILT CIRCUIT SCHEDULE SHALL BE KEPT INTERNAL TO DISTRIBUTION BOARD AT ALL TIMES.
11. P.E. CELL SHALL BE INSTALLED OUT OF DIRECT LINE OF ANY LIGHTING.
12. REFER GENERAL ARRANGEMENT 2000-F00-STD-EL-10022 FOR ALL WIRING AND CONSTRUCTION DETAILS.
13. DISTRIBUTION BOARD SHALL BE CONSTRUCTED IN ACCORDANCE WITH STANDARD - 2000-F00-STS-EL-10007. LOW VOLTAGE DISTRIBUTION BOARDS SPECIFICATION.

LEGEND

- PE CELL
- MCC TERMINAL
- VSD TERMINAL
- FIELD TERMINAL
- PLC OR I/O TERMINAL
- MARSHALLING TERMINAL
- DISTRIBUTION BOARD TERMINAL
- DEVICE TERMINAL
- INDICATION LAMP (cc = COLOUR)
- DUMMY CIRCUIT BREAKER (NOTE 2)

CONSTRUCTION DETAILS

BUSBAR RATING	250A 20kA for 0.3sec
No. OF POLES	60
MOUNTING	WALL-MOUNTED (WITH EXTERNAL MOUNTING TABS PRE-DRILLED Φ14mm)
MAIN SWITCH	250A 3-POLE
INTERNAL COLOUR	ESCUTCHEON GLOSS WHITE
EXTERNAL COLOUR	X15 ORANGE SWITCHROOM INTERNAL
IP RATING	IP4x MIN.
PANEL THICKNESS	1.6mm MIN.
MCB FAULT RATING	10kA
MATERIAL	POWDER COATED MILD STEEL
DOOR SEAL	MOLDED SILICONE SEAL/NEOPRENE SEAL
GLAND PLATE SEAL	MOLDED SILICONE SEAL/NEOPRENE SEAL GLAND PLATE BOTTOM MOUNT ONLY

NORTHERN STAR
Comments ☐
No Comments ☒
Date 10/12/2025
ACCEPTANCE DOES NOT RELIEVE THE SUPPLIER / CONTRACTOR OF ITS RESPONSIBILITY OR LIABILITIES UNDER THE PURCHASE ORDER / CONTRACT

DRG No.	REFERENCES
2000-F72-SLD-EL-10211	F72-SW-172 415V ESSENTIAL SWITCHBOARD SINGLE LINE DIAGRAM
2000-F72-DRG-EL-10104	F72-DB-001 SWITCHROOM 415V L&SP DB GENERAL ARRANGEMENT
2000-F72-DRG-EL-10001	F72-SR-001 REAGENTS MIXING & STORAGE SWITCHROOM 415V ELECTRICAL EQUIPMENT LAYOUT
2000-F00-STD-EL-10001	GENERAL NOTES AND STANDARD DRAWINGS INDEX

REV	DATE	DESCRIPTION	DRAW	CHECK	DESIGN	TECH APP	PROJ APP
1	04NOV25	FAT REDLINES INCORPORATED					
0	24FEB25	APPROVED FOR CONSTRUCTION					

NORTHERN STAR RESOURCES LIMITED

PRIMERO
primero.com.au | DESIGN | CONSTRUCT | OPERATE
PRIMERO PROJECT NUMBER: 23517

INFORMATION AND REPRESENTATIONS ON THIS DRAWING ARE THE INTELLECTUAL PROPERTY OF PRIMERO UNLESS SPECIFICALLY IDENTIFIED OTHERWISE. ALL RIGHTS INCLUDING USE RESERVED

PROJECT: NORTHERN STAR RESOURCES LTD
KCGM GROWTH PROJECT

TITLE: REAGENTS MIXING & STORAGE - F72-SR-001
F72-DB-001 SWITCHROOM 415V L&SP DB
THREE LINE DIAGRAM

SHEET	SCALE	DRG No.	REVISION
A1	NONE	2000-F72-TLD-EL-10104	1

O:\CAD PROJECTS\23517 KCGM GROWTH PROJECT\03 DELIVERABLES\ELV\F72 - REAGENTS MIXING & STORAGE\2000-F72-TLD-EL-10104.DWG 02DEC25 12:41PM HOTSEAT04