
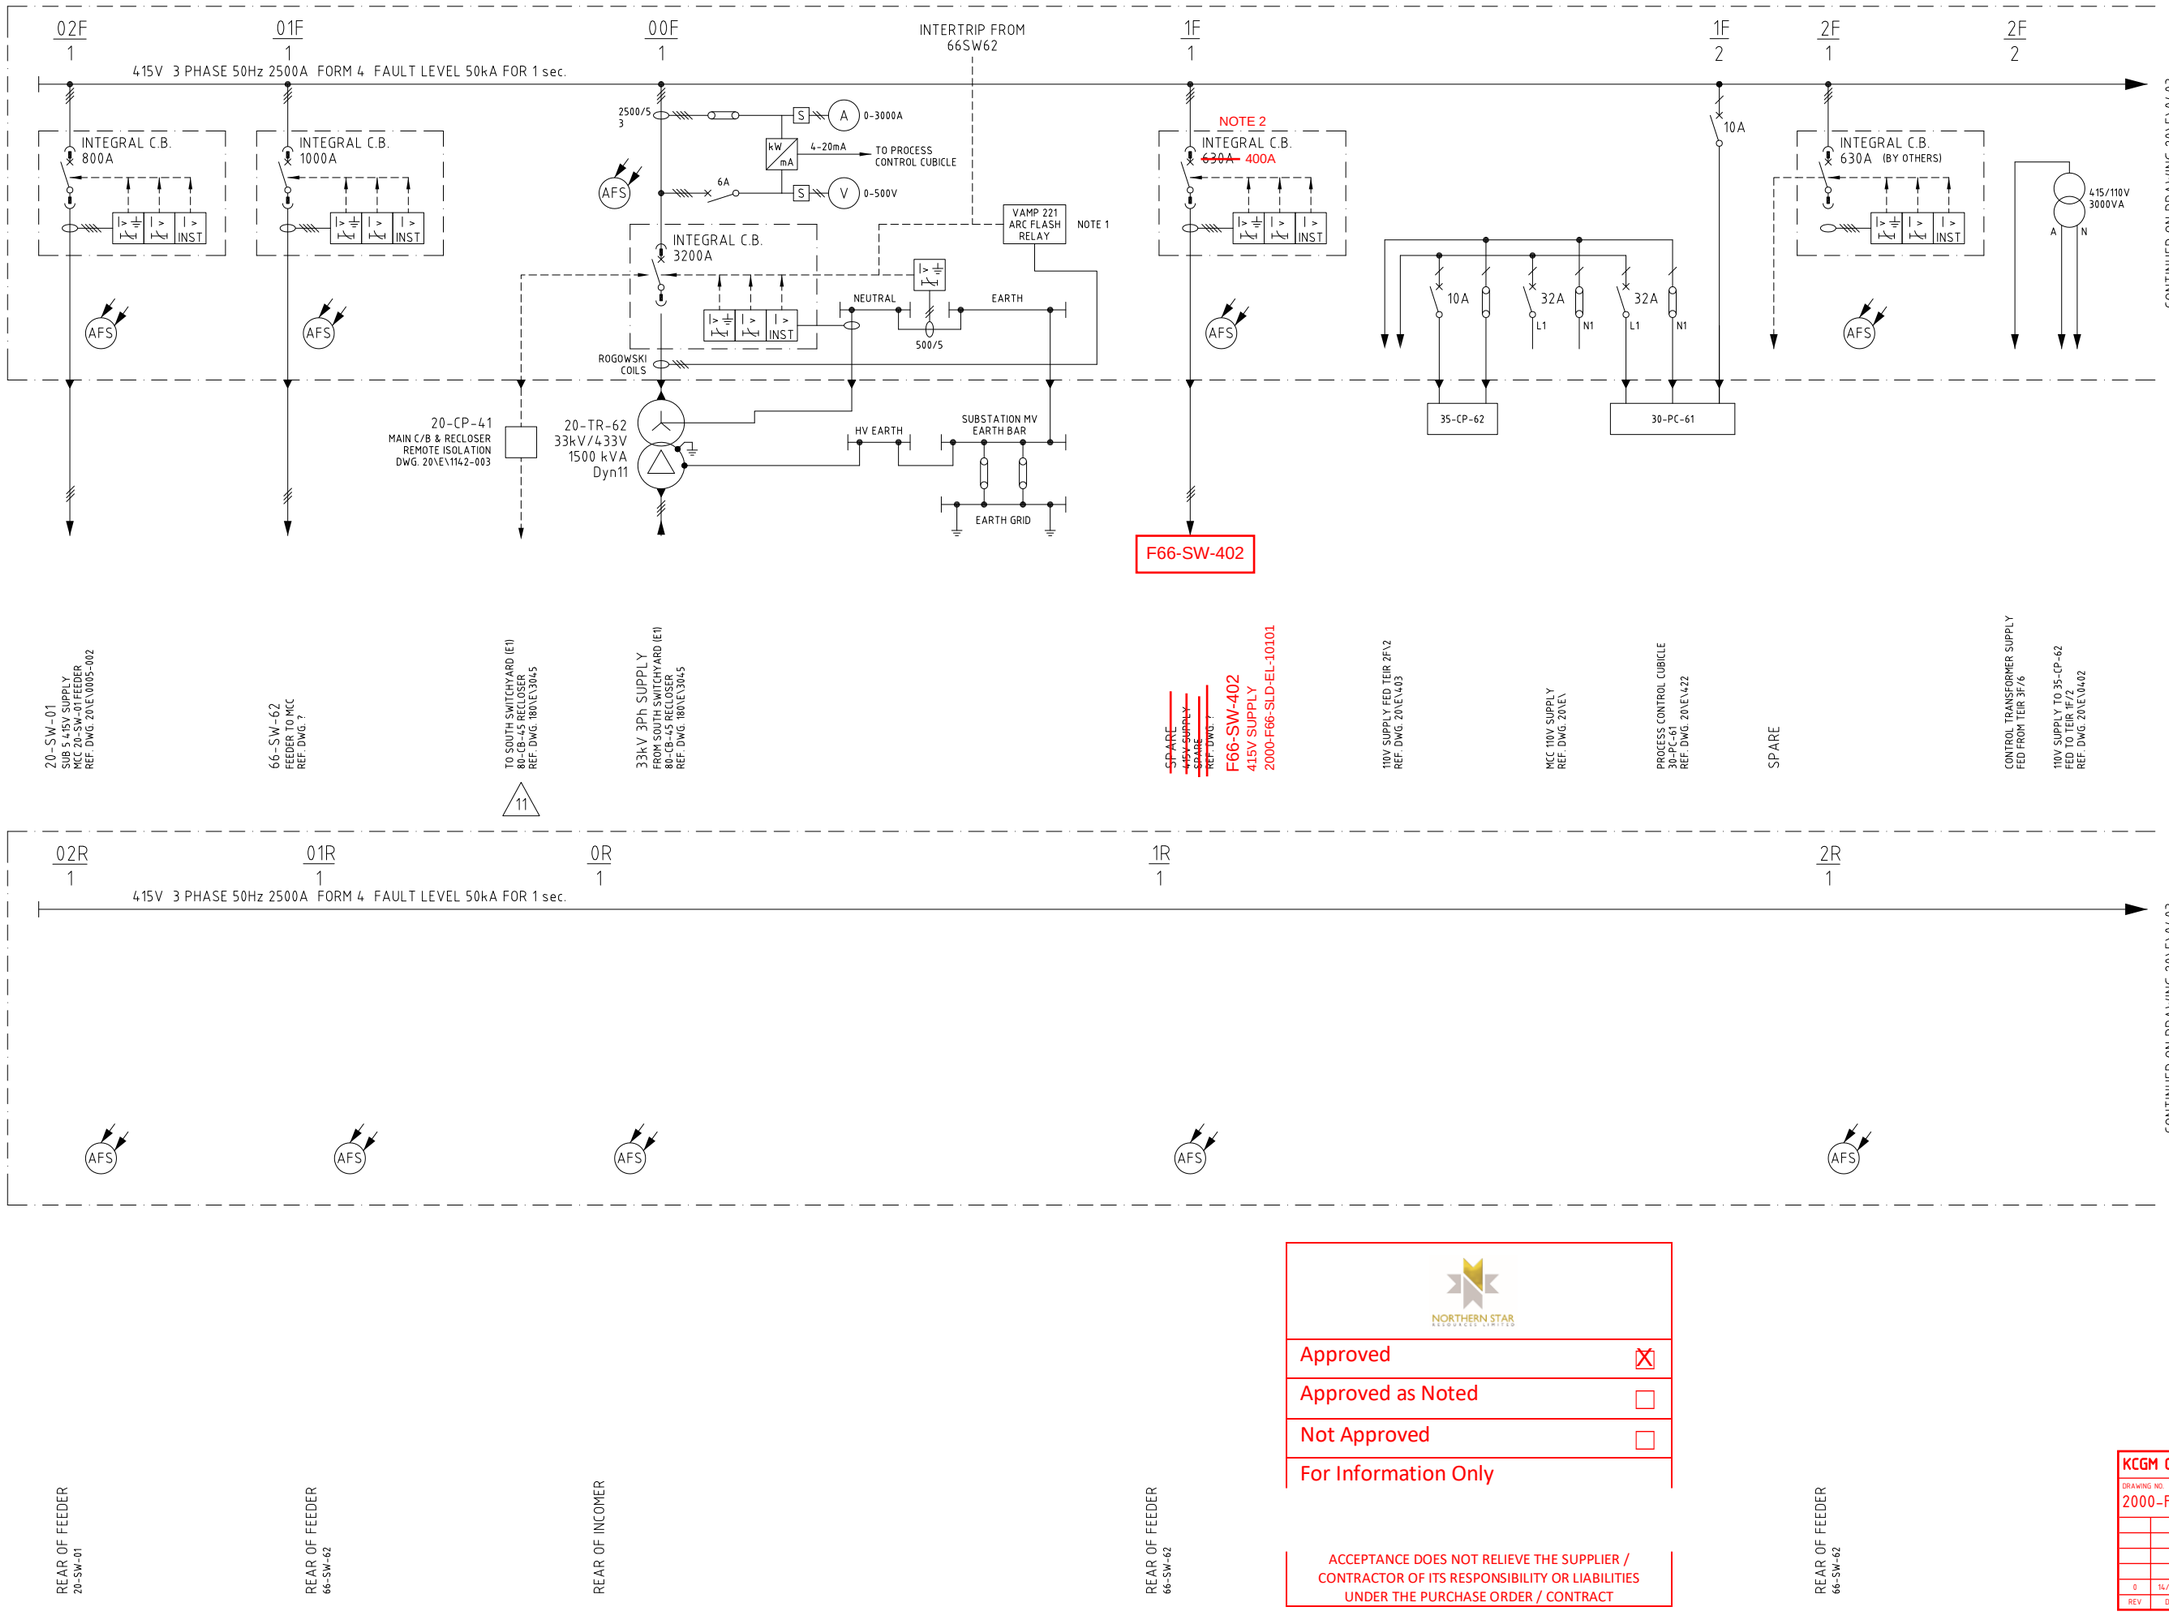


LEGEND

LOCATION

SUB STATION 35

20-SW-62

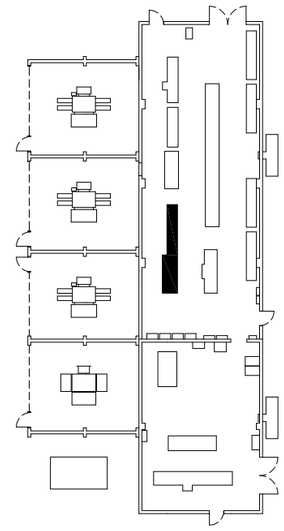

NOTES

1. ALL AFS (ARC FLASH SENSORS) ARE CONNECTED TO THE ARC FLASH RELAY VIA I/O UNITS
2. TIER 1F SPARE FEEDER RE-PURPOSED FOR KCGM GROWTH PROJECT. MCCB TRIP UNIT TO BE SET AT 400A.

NORTHERN STAR RESOURCES LIMITED

Approved	☒
Approved as Noted	☐
Not Approved	☐
For Information Only	

ACCEPTANCE DOES NOT RELIEVE THE SUPPLIER / CONTRACTOR OF ITS RESPONSIBILITY OR LIABILITIES UNDER THE PURCHASE ORDER / CONTRACT

LEGEND

- STAGE 1 - NEW
- STAGE 1 - REMOVE
- STAGE 1 - DECOMMISSIONED (OTHERS)
- STAGE 2 - NEW
- STAGE 2 - REMOVE
- STAGE 2 - DECOMMISSIONED (OTHERS)

KCGM GROWTH PROJECT

DRAWING NO.
2000-F20-SLD-EL-10102

REV	DATE	DESCRIPTION	CHECK	TECH APP
0	14/03/25	APPROVED FOR CONSTRUCTION		MB/DM

2000-F20-SLD-EL-10102_Rev0

Fimiston recycle crushing substation no. 35 415V MCC 20-SW-62 single line diagram sheet 1