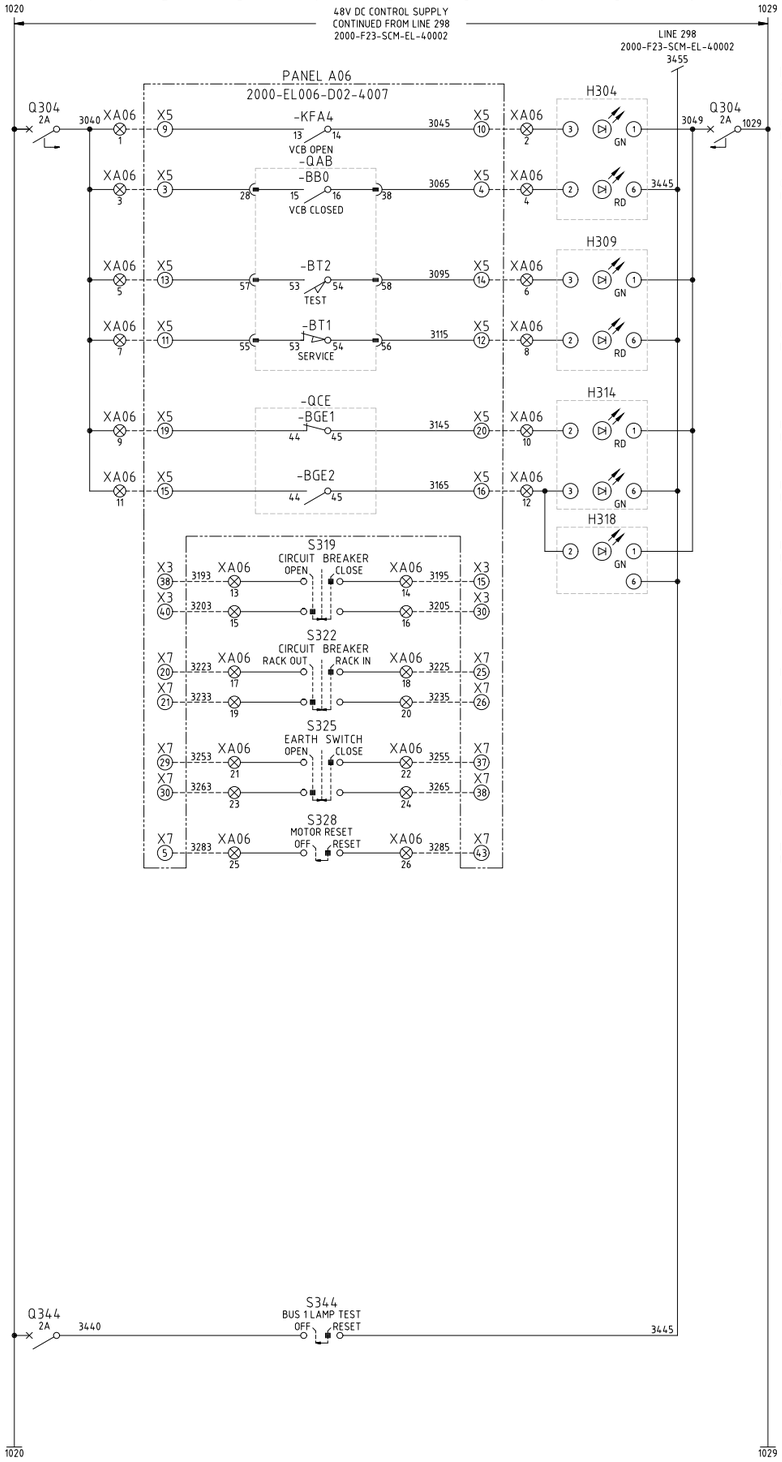


PANEL A06
SPARE FEEDER
2000-F23-TER-EL-40001

CIRCUIT BREAKER OPEN INDICATION

CIRCUIT BREAKER CLOSED INDICATION

CIRCUIT BREAKER RACKED OUT INDICATION

CIRCUIT BREAKER RACKED IN INDICATION

EARTH SWITCH OPEN INDICATION

EARTH SWITCH CLOSED INDICATION

EARTH SYMBOL INDICATION

CLOSE BREAKER COMMAND

OPEN BREAKER COMMAND

RACK IN BREAKER COMMAND

RACK OUT BREAKER COMMAND

CLOSE EARTH SWITCH COMMAND

OPEN EARTH SWITCH COMMAND

EARTH SWITCH MOTOR RESET

NOTES

1. WIRE NUMBER FERRULES ON TERMINAL STRIP SHALL BE PREFIXED WITH EQUIPMENT NUMBER e.g. FxxPPxxx-1200.
2. EACH WIRE SHALL BE IDENTIFIED AT BOTH ENDS WITH FERRULES.

LEGEND

⊗ RSP TERMINAL

Xx
(xx) HV SWITCHBOARD TERMINAL

(x) DEVICE TERMINAL

AS BUILT

2000-F23-SCM-EL-40003_Rev2

FIM III booster station F23-SW-601 HV switchboard
remote switching panel schematic diagram sheet 3