
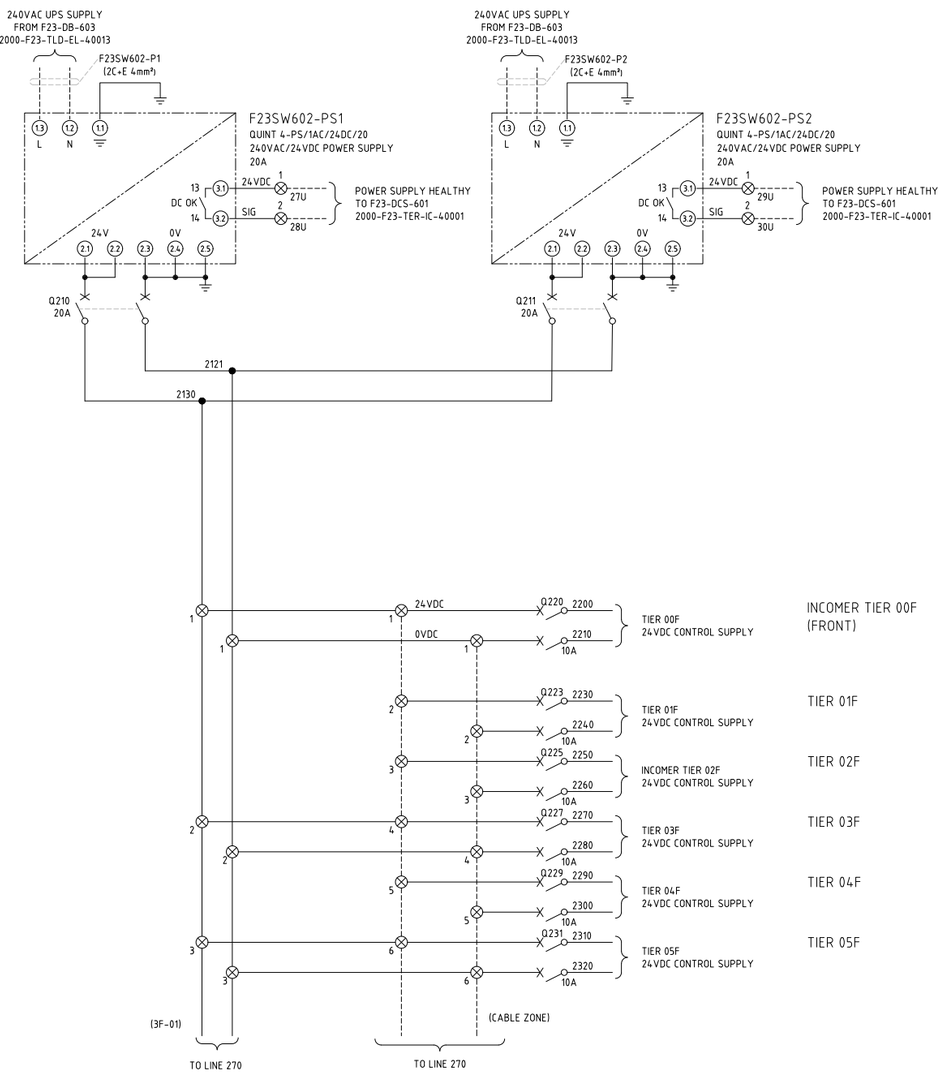


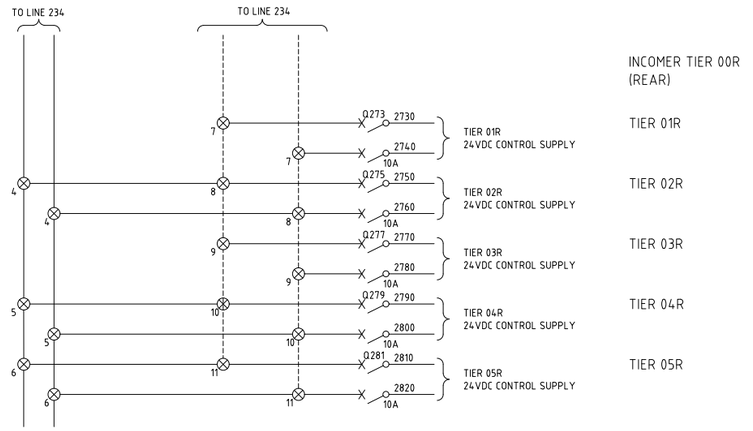


NOTES

1. TERMINALS ON TERMINAL STRIPS ABOVE 50VAC SHALL HAVE A SEPARATE PERSPEX SHROUD AND SHALL BE LABELLED "DANGER xxxVAC".
2. WIRE NUMBER FERRULES ON TERMINAL STRIP SHALL BE PREFIXED WITH EQUIPMENT NUMBER e.g. F23SW602-1200.
3. EACH WIRE SHALL BE IDENTIFIED AT BOTH ENDS WITH FERRULES.

LEGEND

- 00/01/00 — DCS DIGITAL INPUT
- 00/02/00 — DCS DIGITAL OUTPUT
- MCC TERMINAL
- VSD TERMINAL
- FIELD TERMINAL
- DCS OR I/O TERMINAL
- MARSHALLING TERMINAL
- DEVICE TERMINAL
- INDICATION LAMP (cc = COLOUR)

TERMINATION LEGEND

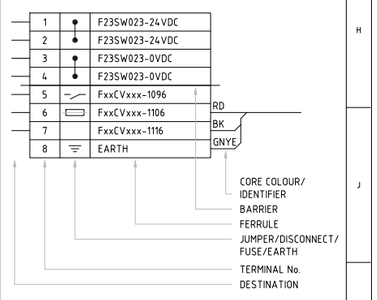

AS BUILT

2000-F23-SCM-EL-40014_Rev3

FIM III booster station F23-SW-602 24dc distribution schematic diagram