


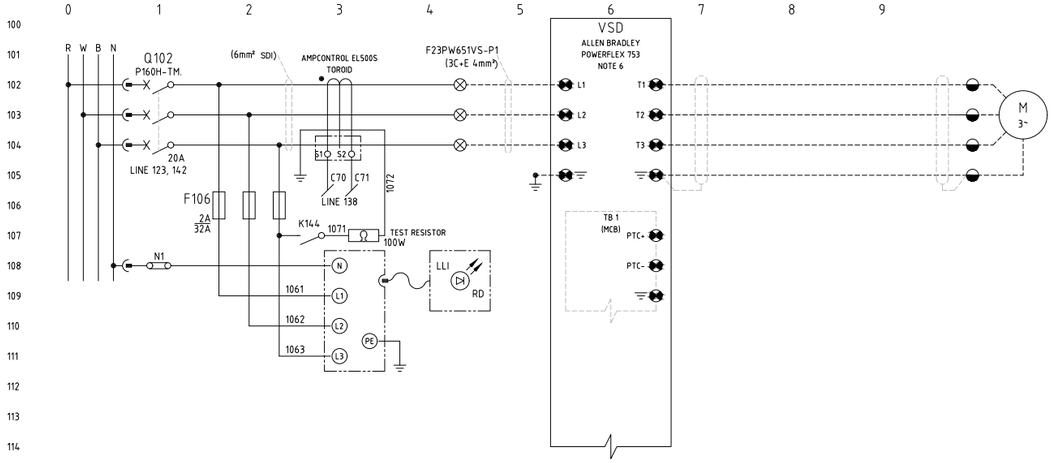


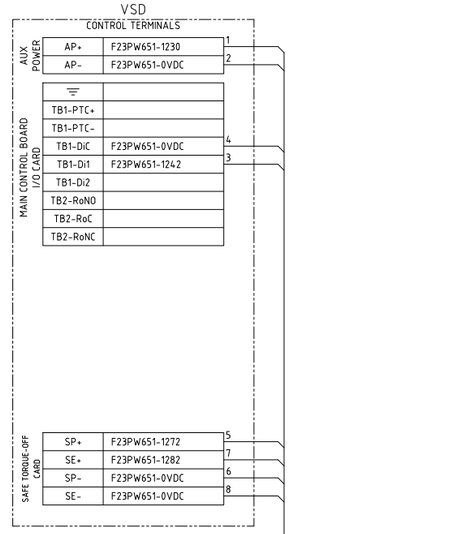

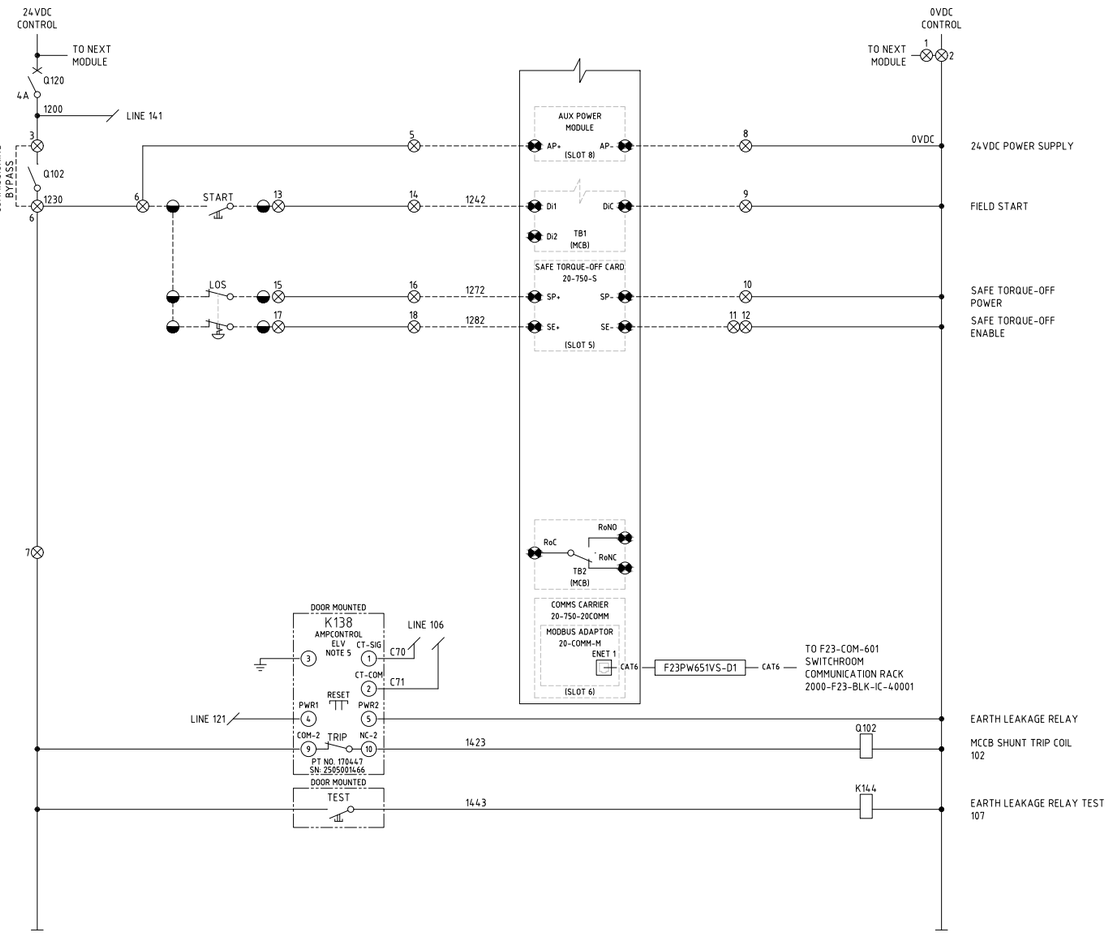

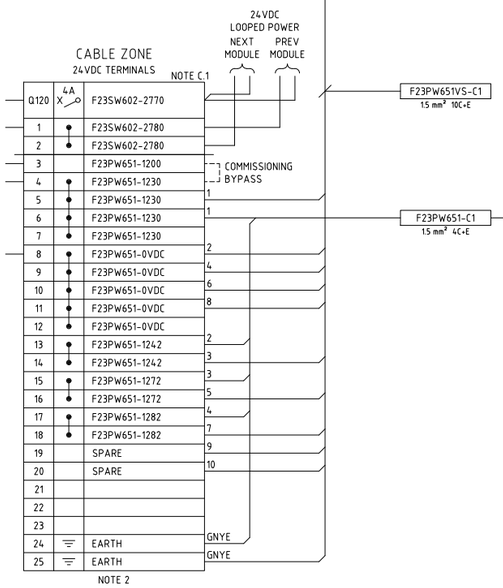

NOTES

1. TERMINALS ON TERMINAL STRIPS ABOVE 50VAC SHALL HAVE A SEPARATE PERSPEX SHROUD AND SHALL BE LABELLED "DANGER xxxVAC".
2. WIRE NUMBER FERRULES ON TERMINAL STRIP SHALL BE PREFIXED WITH EQUIPMENT NUMBER e.g. F23PW651-1200.
3. EACH WIRE SHALL BE IDENTIFIED AT BOTH ENDS WITH FERRULES.
4. THE ELV RELAY REQUIRES A SEPARATELY PURCHASED EL500S TOROID FOR MEASUREMENT OF THE EARTH LEAKAGE CURRENT. EL500S TOROIDS ARE AVAILABLE IN THE FOLLOWING WINDOW SIZES: 25mm, 60mm & 112mm.
   TOROID DETAILS
   PT NO. 115437
   SN: 2503000866
   RATIO: 100/1A
5. EARTH LEAKAGE RELAY (ELV) USER INTERFACE TO BE MOUNTED ON MCC MODULE DOOR.
   RELAY SETTINGS SET TO:
   TRIP LEVEL = "1A" (POSITION 0).
   TRIP DELAY = "100ms" (POSITION 1).
6. VSD SHALL BE SIZE FRAME 2 AND ABOVE.
7. REFER TO CABLE SCHEDULE 2000-F23-LST-EL-40003.


LEGEND

- 00/01/00 — DCS DIGITAL INPUT
- 00/02/00 — DCS DIGITAL OUTPUT
- ⊗ — MCC TERMINAL
- ◓ — VSD TERMINAL
- ◒ — FIELD TERMINAL
- ◑ — DCS OR I/O TERMINAL
- ◧ — MARSHALLING TERMINAL
- (x) — DEVICE TERMINAL
- ⊗cc — INDICATION LAMP, cc = COLOUR

DCS LEGEND



TERMINATION LEGEND

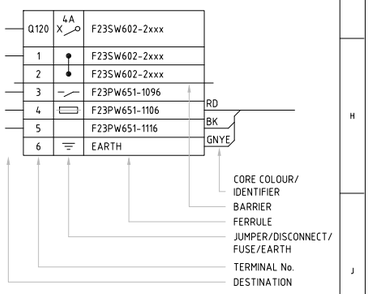

MCC CELL LOCATION 3R-01

AS BUILT

2000-F23-SCM-EL-40020_Rev2

FIM III booster station F23-PW-651 FIM III booster pump 1 seal water pump 1 control schematic diagram