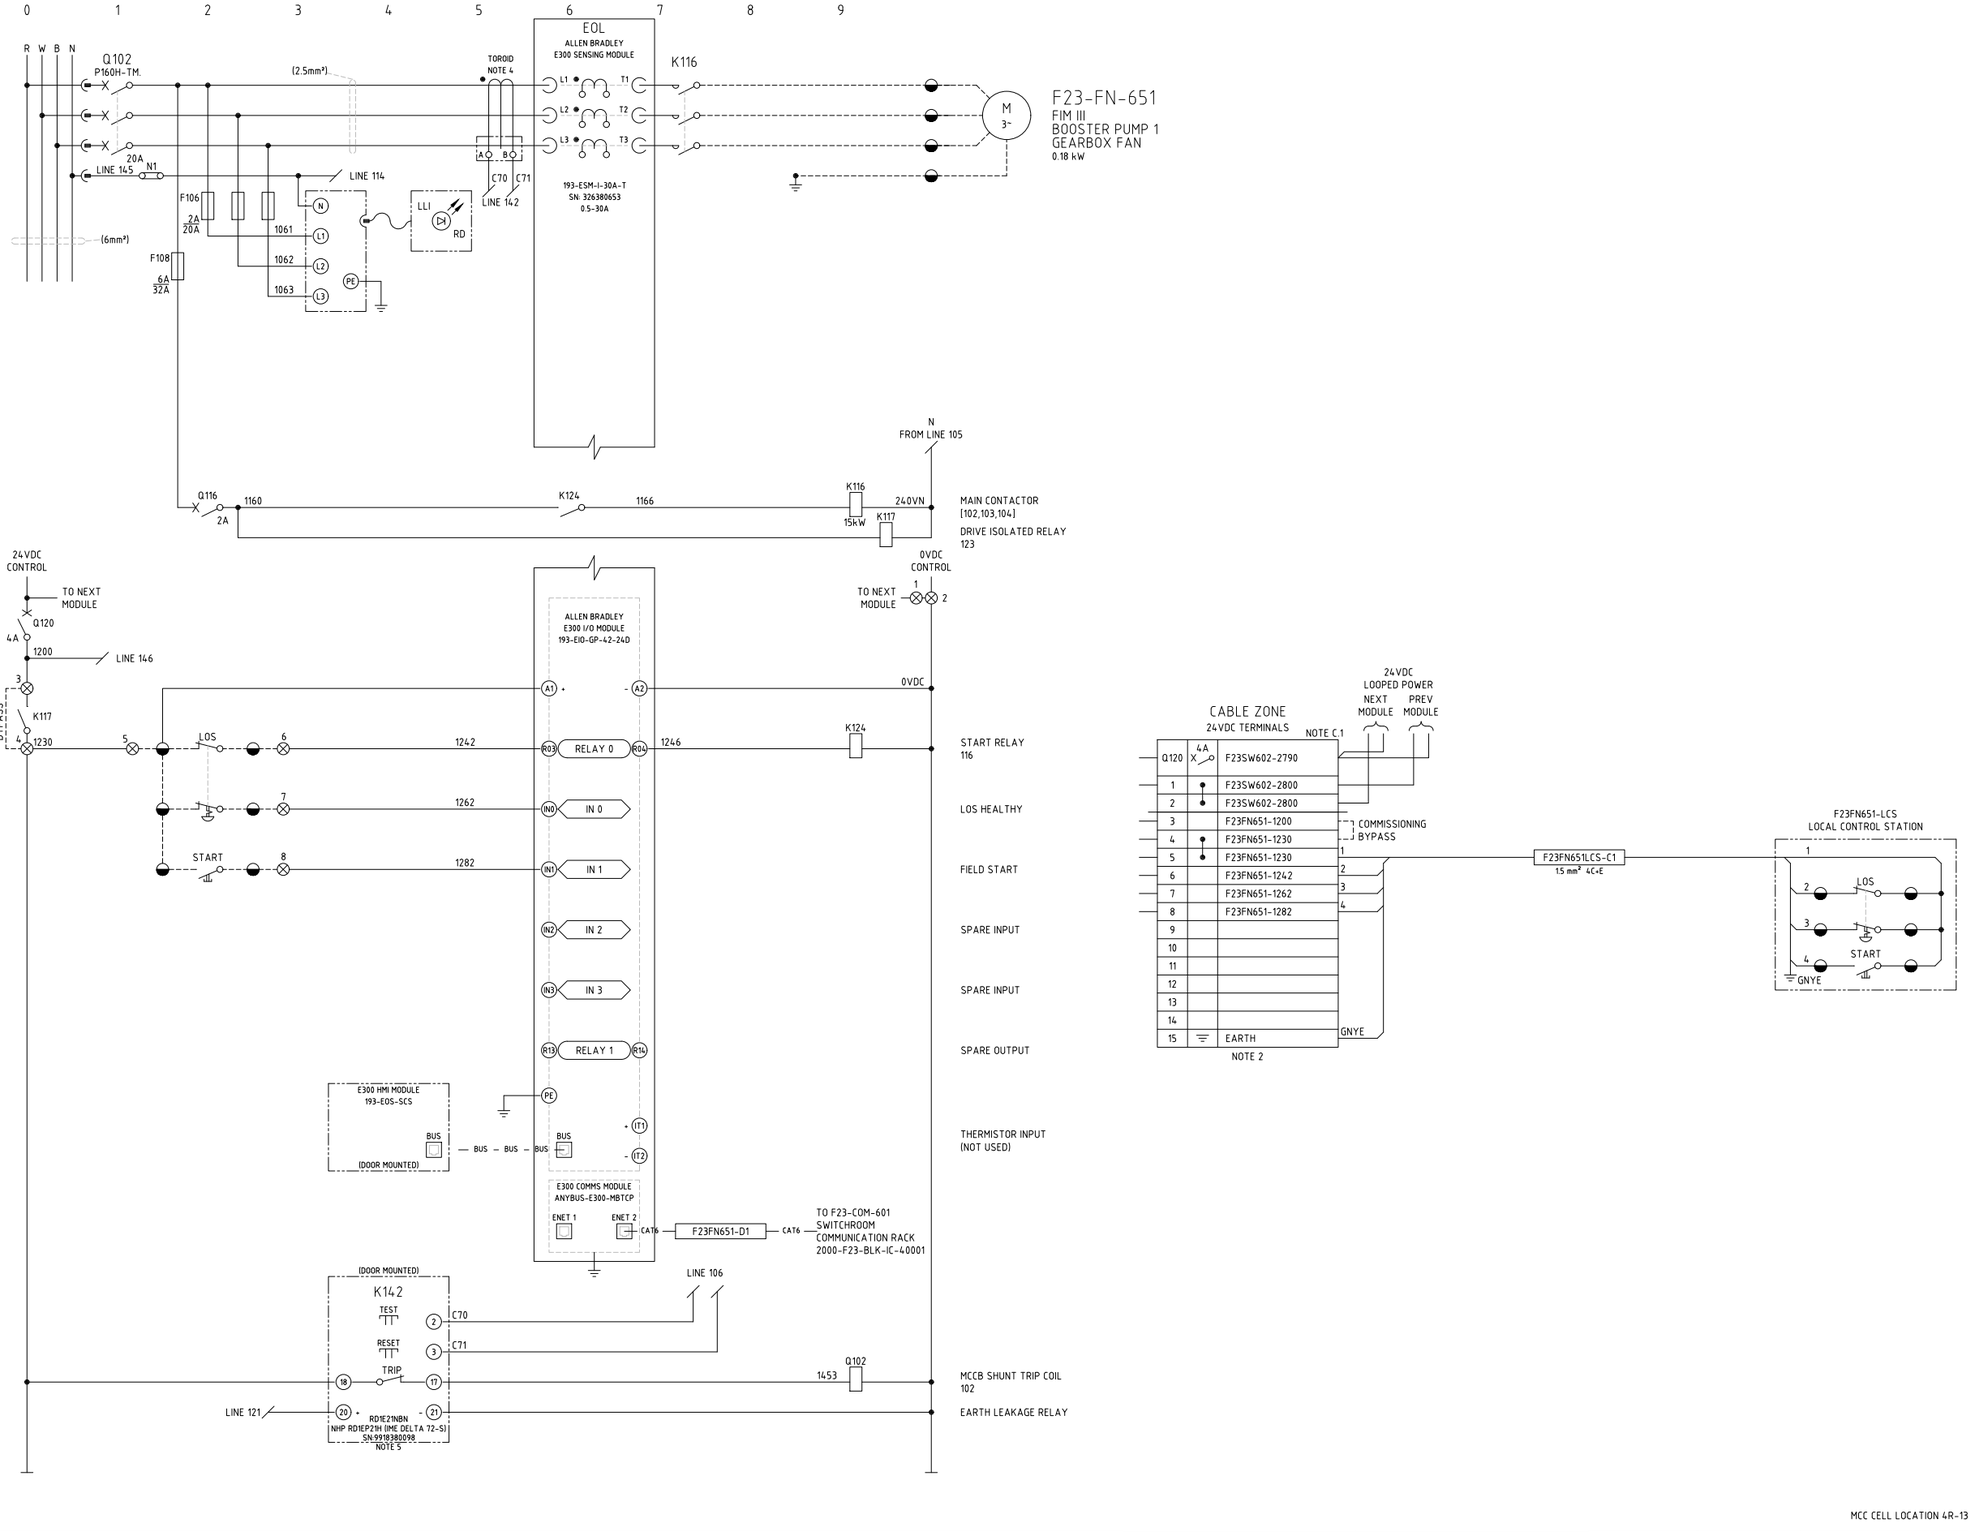



## NOTES

1. TERMINALS ON TERMINAL STRIPS ABOVE 50VAC SHALL HAVE A SEPARATE PERSPEX SHROUD AND SHALL BE LABELLED "DANGER xxxVAC".
2. WIRE NUMBER FERRULES ON TERMINAL STRIP SHALL BE PREFIXED WITH EQUIPMENT NUMBER e.g. F23FN651-1200.
3. EACH WIRE SHALL BE IDENTIFIED AT BOTH ENDS WITH FERRULES.
4. NHP TD6x2 TOROID TO SUIT CABLE DIAMETER.
   TOROID DETAILS
   TDGB2
   SN: 0461520236
   IN:70A
5. EARTH LEAKAGE RELAY USER INTERFACE TO BE MOUNTED ON MCC MODULE DOOR.
   RELAY SETTINGS SET TO:
   IΔn = "1A".
   DELAY = "100ms".
   RANGES = "x1".
   FAILSAFE MODE = "Ne".
   RESET = "MAN".
6. REFER TO CABLE SCHEDULE 2000-F23-LST-EL-40003.

## LEGEND

- 00/01/00 — DCS DIGITAL INPUT
- 00/02/00 — DCS DIGITAL OUTPUT
- ⊗ — MCC TERMINAL
- ⬣ — VSD TERMINAL
- ◒ — FIELD TERMINAL
- ◑ — DCS OR I/O TERMINAL
- ◧ — MARSHALLING TERMINAL
- (x) — DEVICE TERMINAL
- ⊗ cc — INDICATION LAMP, cc = COLOUR

## CONSTRUCTION NOTES

C.1 TO BE DETERMINED BY MCC VENDOR

## TERMINATION LEGEND

| | | |
|---|---|---|
| Q120 | 4A X | F23SW602-2xxx |
| 1 | | F23SW602-2xxx |
| 2 | | F23SW602-2xxx |
| 3 | | F23FN651-1200 |
| 4 | | F23FN651-1230 |
| 5 | | F23FN651-1230 |
| 6 | | EARTH |

RD, BK, GNYE

- CORE COLOUR/ IDENTIFIER
- BARRIER
- FERRULE
- JUMPER/DISCONNECT/ FUSE/EARTH
- TERMINAL No.
- DESTINATION

MCC CELL LOCATION 4R-13

AS BUILT

# 2000-F23-SCM-EL-40028_Rev3

FIM III booster station F23-FN-651 FIM III booster pump 1 gearbox fan control schematic diagram