

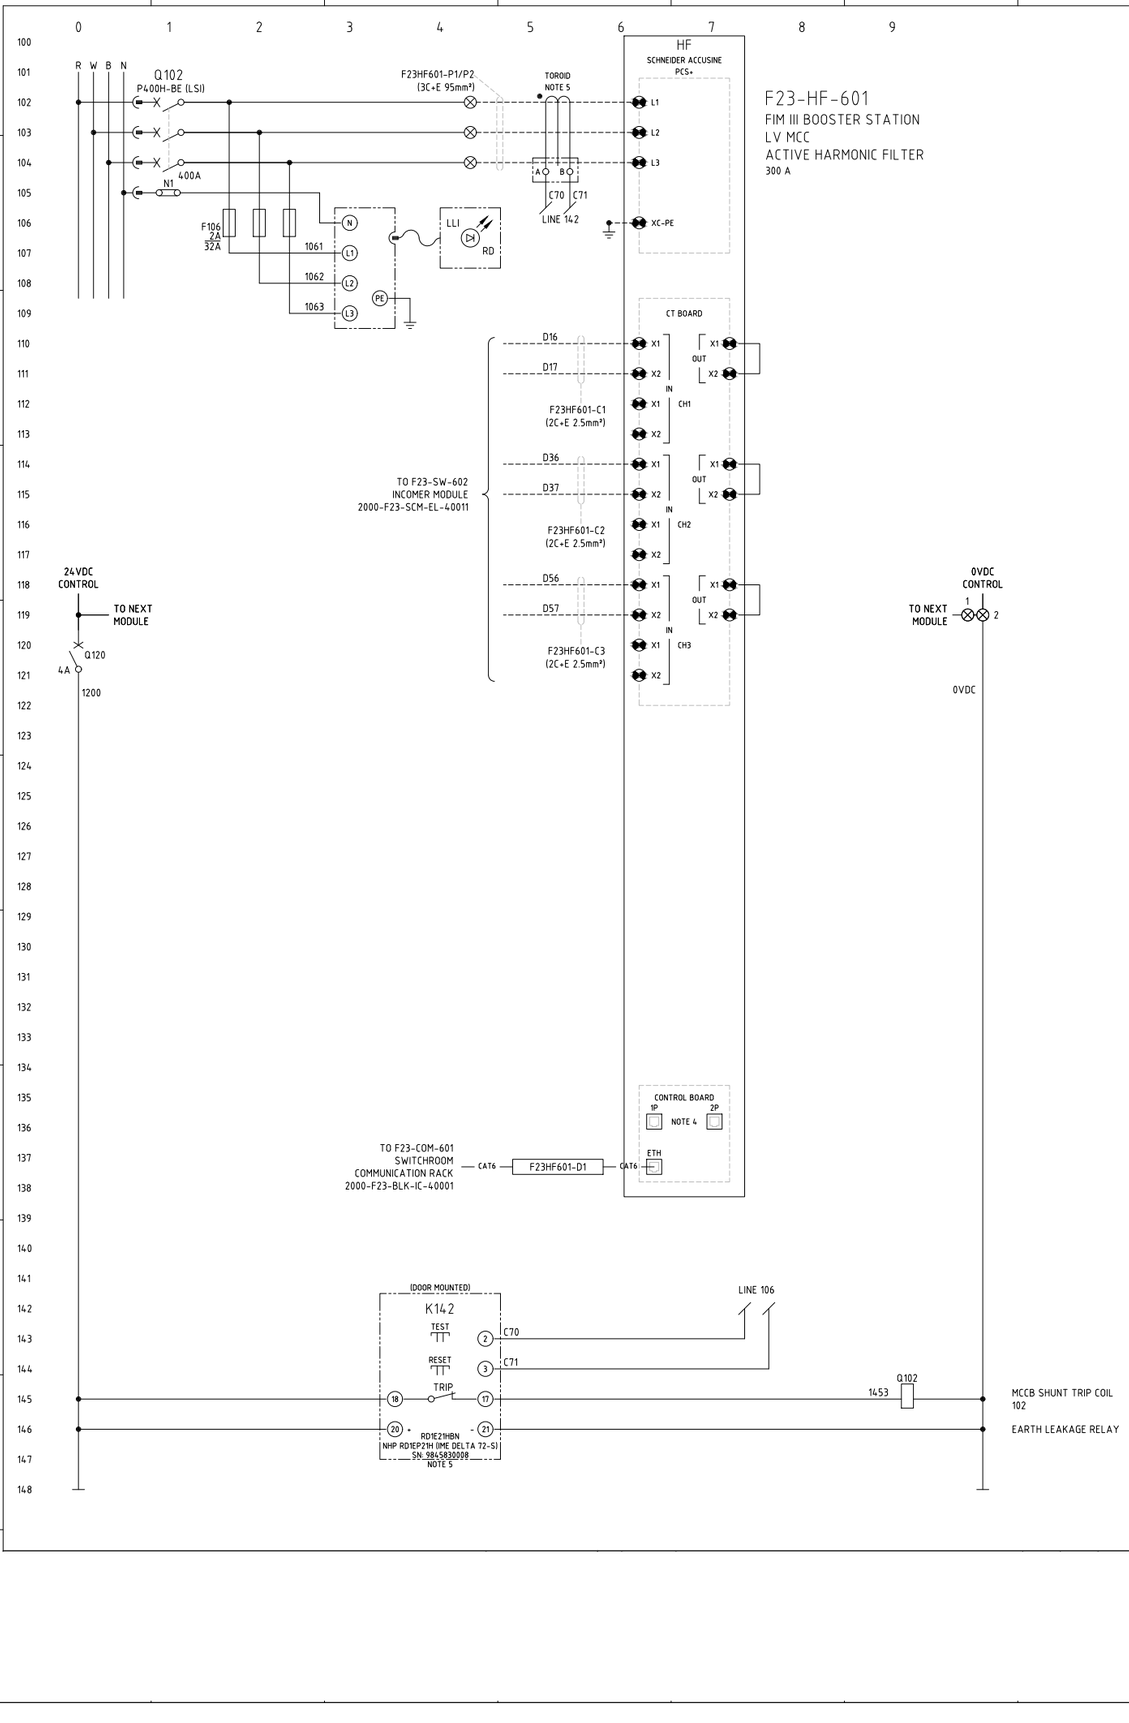


F23-HF-601

FIM III BOOSTER STATION
LV MCC
ACTIVE HARMONIC FILTER
300 A

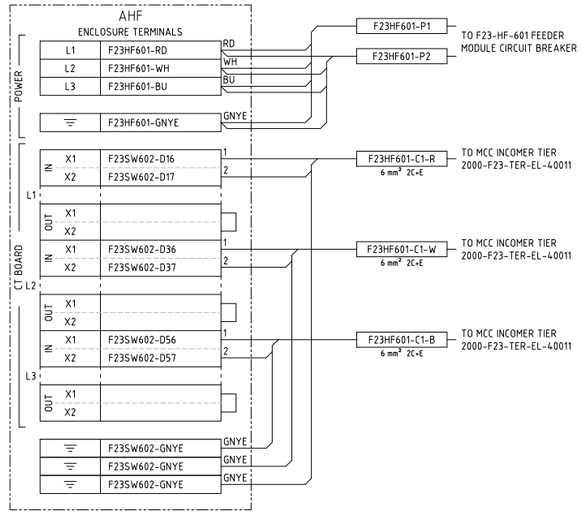


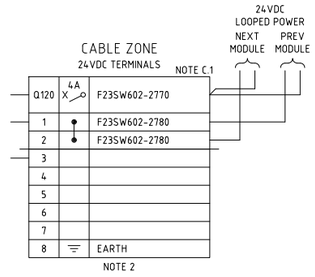

NOTES

1. TERMINALS ON TERMINAL STRIPS ABOVE 50VAC SHALL HAVE A SEPARATE PERSPEX SHROUD AND SHALL BE LABELLED "DANGER xxxVAC".
2. WIRE NUMBER FERRULES ON TERMINAL STRIP SHALL BE PREFIXED WITH EQUIPMENT NUMBER e.g. F23HF601-1200.
3. EACH WIRE SHALL BE IDENTIFIED AT BOTH ENDS WITH FERRULES.
4. P1 & P2 PORTS ARE FACTORY FITTED WITH RJ45 TERMINATOR.
5. NHP TDG×2 TOROID TO SUIT CABLE DIAMETER.
   TOROID DETAILS
   TDGF2
   SN: 0436160660
   IN:400A
6. EARTH LEAKAGE RELAY USER INTERFACE TO BE MOUNTED ON MCC MODULE DOOR.
   RELAY SETTINGS SET TO:
   IΔN = "1A".
   DELAY = "100MS".
   RANGES = "X1".
   FAILSAFE MODE = "NE".
   RESET = "MAN".
7. REFER TO CABLE SCHEDULE 2000-F23-LST-EL-40003.


LEGEND

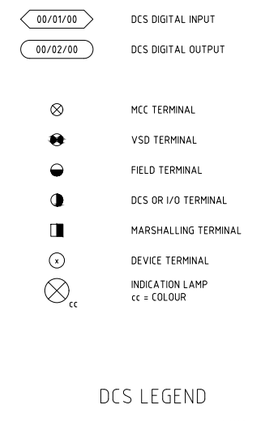

DCS LEGEND



TERMINATION LEGEND

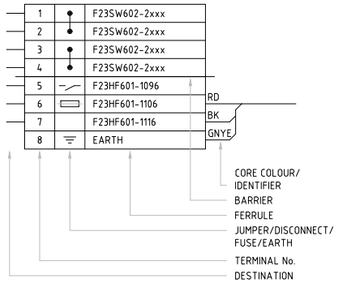

MCC CELL LOCATION 3R-17

AS BUILT

2000-F23-SCM-EL-40031_Rev3

FIM III booster station F23-HF-601 LV MCC active harmonic filter feeder control schematic diagram