
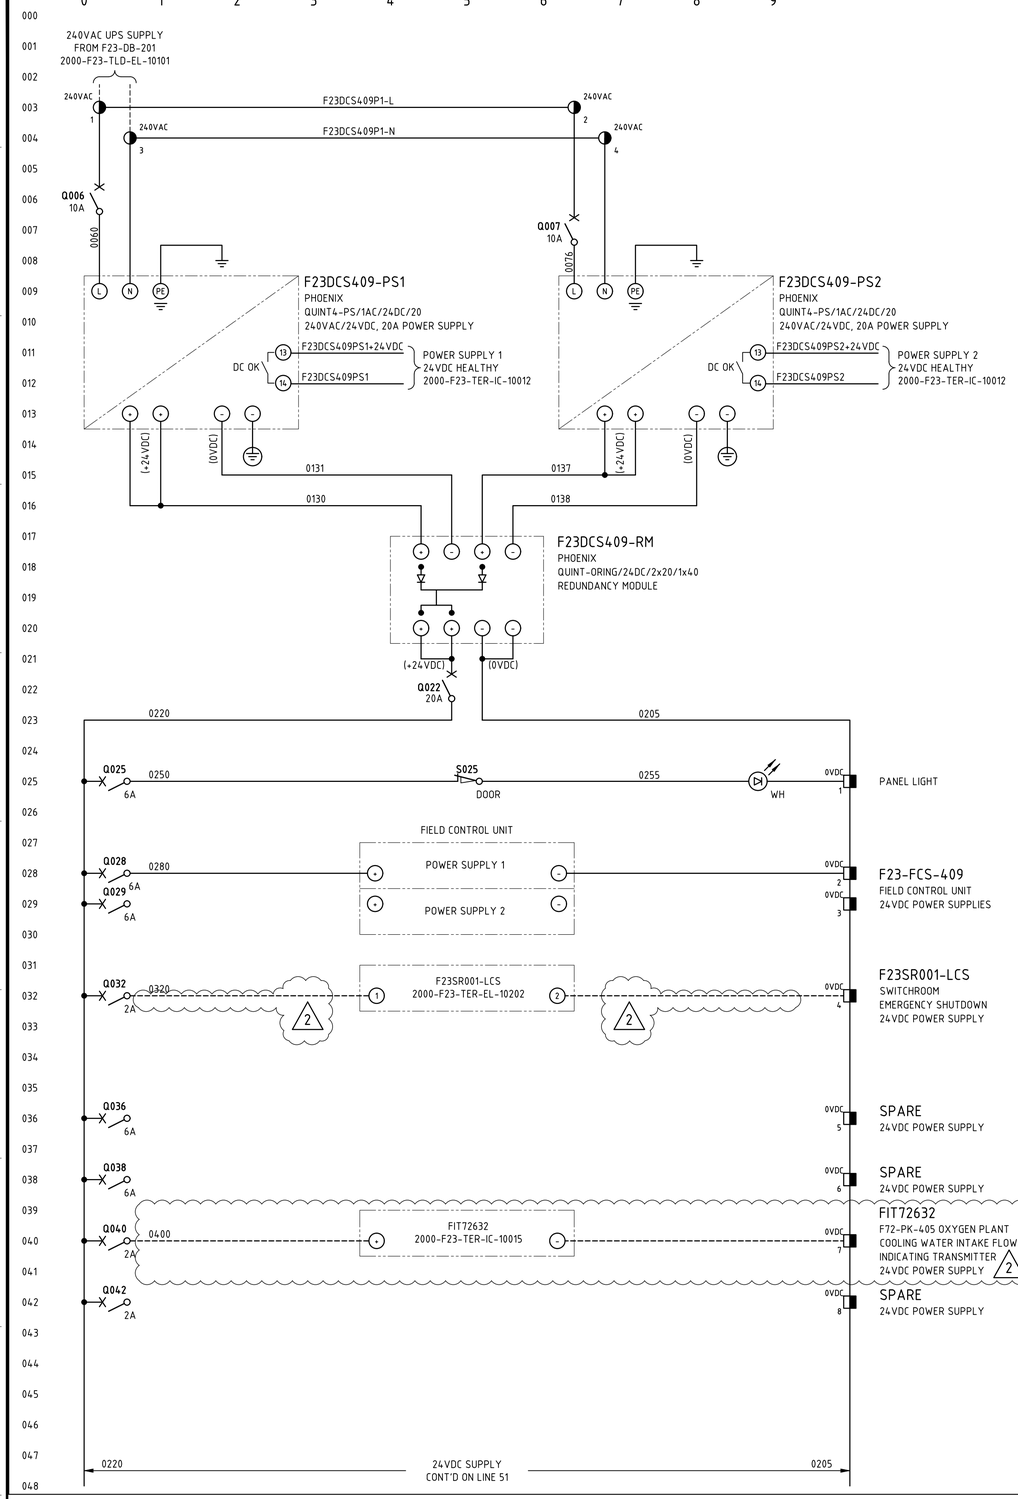


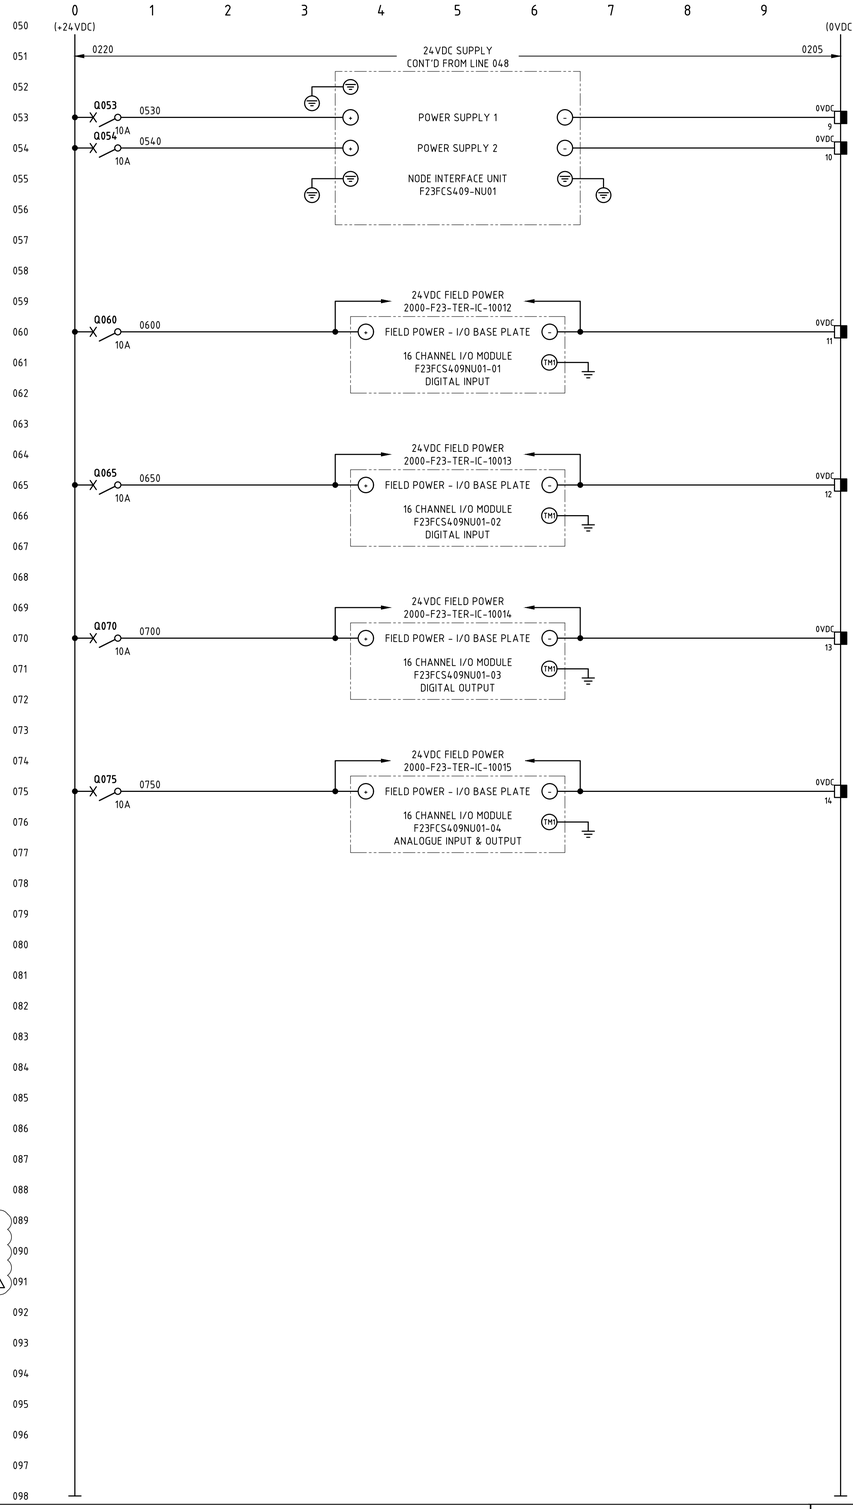

NOTES

1. TERMINALS ON TERMINAL STRIPS ABOVE 50VAC SHALL HAVE A SEPARATE PERSPEX SHROUD AND SHALL BE LABELLED "DANGER xxxVAC".
2. WIRE NUMBER FERRULES ON TERMINAL STRIP SHALL BE PREFIXED WITH EQUIPMENT NUMBER e.g. F23DCS409-xxxx.
3. EACH WIRE SHALL BE IDENTIFIED AT BOTH ENDS WITH FERRULES.
4. FOR NETWORK CONNECTION & BUS CABLING DETAILS REFER TO DCS PANEL COMMUNICATIONS TERMINATION DIAGRAMS.
5. INSTRUMENT EARTH BAR TO BE BONDED TO MAIN EARTH BAR WITH SOLID COPPER LINK.

LEGEND

- FIELD TERMINAL
- DCS OR I/O TERMINAL
- 0VDC TERMINAL FOR 24VDC (2)
- DEVICE TERMINAL (x)
- INDICATION LAMP, cc = COLOUR
- EARTH BAR
- INSTRUMENT EARTH BAR

NIO BASEPLATE

F23FCS409NU01-01

- NETWORKED INPUT/OUTPUT (N-IO) BASEPLATE
- NODE INTERFACE UNIT (N-IU)
- FIELD CONTROL UNIT

AS CONSTRUCTED

CHANGE: ☐ NO CHANGE: ☒

SIGNATURE: *George Forrest*
NAME: GEORGE FORREST
DATE: 2025/11/19

ENGINEER SIGN OFF

SIGNATURE: Sanam Gurung
NAME: SANAM GURUNG
DATE: 2025/11/19

2000-F23-SCM-IC-10011_Rev2A

F23-SR-002 F23-DCS-409 415V switchroom DCS panel schematic diagram

O:\CAD PROJECTS\235 NORTHERN STAR RESOURCES LTD\23517 KCGM GROWTH PROJECT\03 DELIVERABLES\IC\F23 - FINAL TAILINGS HANDLING & STORAGE\2000-F23-SCM-IC-10011.DWG 02OCT25 9:04:AM HOTSEAT04