

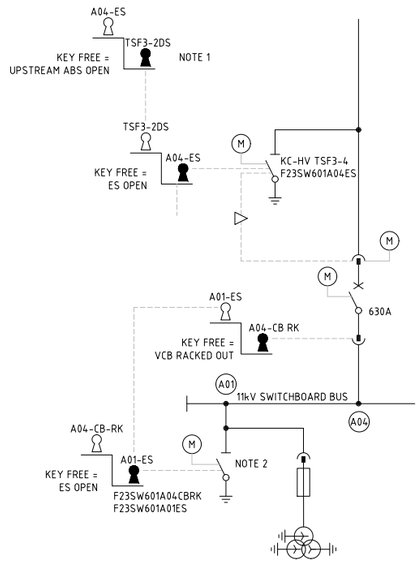



F23-SW-601 11kV INCOMER & BUS
EARTH SWITCH KEY
INTERLOCKING SCHEME
ALL INTERLOCKING IS SINGLE KEY
1 OUT OF 2 INTERLOCKING

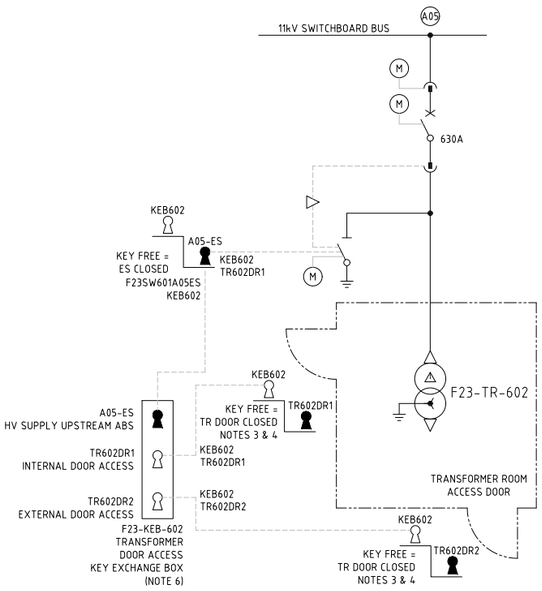


F23-SR-601
FIM III BOOSTER STATION HV /LV SWITCHROOM

11kV FEEDER TO 415V SWITCHROOM
TRANSFORMER ACCESS DOOR
KEY INTERLOCKING SCHEME

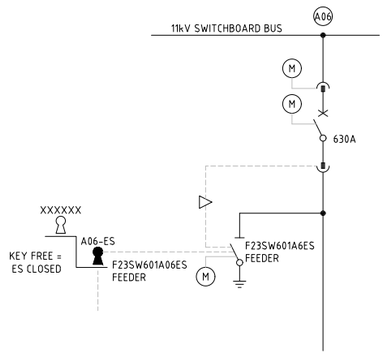


F23-SR-601
FIM III BOOSTER STATION HV /LV SWITCHROOM

11kV FEEDER SPARE


## NOTES

1. UPSTREAM OVERHEAD LINE POLE ,MOUNTED DISCONNECTOR SWITCH KEY INTERLOCKED WITH THE 11kV SWITCHBOARD INCOMER EARTH SWITCH SUCH THAT THE UPSTREAM 33kV DISCONNECTOR SWITCH CAN ONLY BE CLOSED WHEN THE INCOMER EARTH SWITCH IS OPEN.
2. 11kV BUS EARTH SWITCH AND INCOMER CIRCUIT BREAKER SHALL BE KEY INTERLOCKED SUCH THAT BUS EARTH SWITCH CANNOT BE CLOSED WHILE INCOMER CIRCUIT BREAKER IS RACKED IN.
3. 415V MCC TRANSFORMER ROOM ACCESS DOORS SHALL BE FORTRESS KEY INTERLOCKED WITH THE UPSTREAM 11kV FEEDER EARTH SWITCH.
4. TRANSFORMER ENCLOSURE DOOR STATUS SHALL BE MONITORED BY THE DCS. OPENING THE DOOR SHALL RAMP STOP THE RELEVANT SWITCHROOM AREA AND OPEN THE UPSTREAM CIRCUIT BREAKERS.
5. HV VSD ACCESS DOORS SHALL BE FORTRESS KEY INTERLOCKED WITH THE UPSTREAM FEEDER EARTH SWITCH.
6. LOCATE KEY EXCHANGE BOX INSIDE SWITCHROOM ADJACENT TO TRANSFORMER INTERNAL ACCESS DOOR.

## LEGEND


- MECHANICAL OR ELECTRICAL INTERLOCK DEVICE
- KEY FREE
- KEY CAPTIVE
- KEY EXCHANGE BOX

F23-PP-651
FIM III BOOSTER PUMP 1

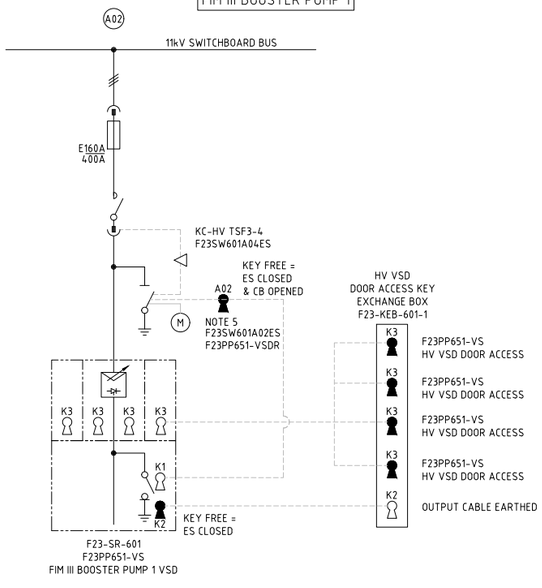


11kV FEEDER TO HV VSD
MAIN PANEL ACCESS DOOR
KEY INTERLOCKING SCHEME

F23-PP-652
FIM III BOOSTER PUMP 2

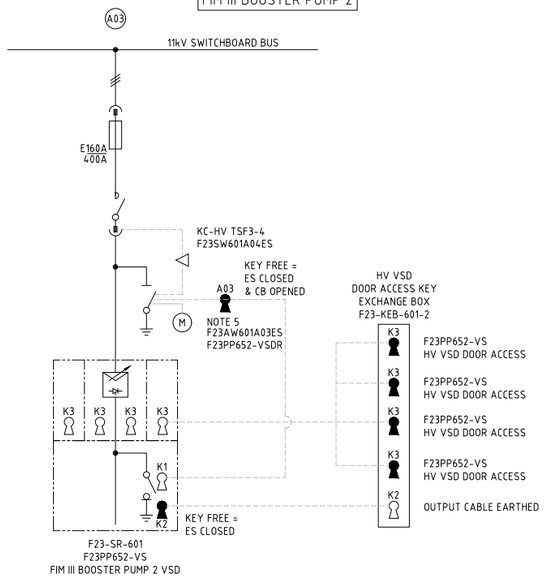


11kV FEEDER TO HV VSD
MAIN PANEL ACCESS DOOR
KEY INTERLOCKING SCHEME

AS BUILT

# 2000-F23-SLD-EL-40002_Rev2

FIM III booster station F23-SW-601 HV switchboard
key interlocking single line diagram