CONTINUED ON DRAWING 25\E\1065-001 2000-F25-SLD-EL-10010

3F 1 — 415V 3 PHASE 50Hz 3150A FORM 3 FAULT LEVEL 50kA FOR 1 sec.

3000/5 3 — AFS — V 0-500V — A 0-3000A — S — kW mA 4-20mA — TO PROCESS CONTROL CUBICLE — 2A/20A S — 415/110V — 2A — VAMP 221 ARC FLASH RELAY — NOTE 1 — INTEGRAL C.B. 3150A — I> I> I> INST — NEUTRAL — EARTH — 200/5 — ROGOWSKI COILS

25-CP-83
MAIN C/B & RECLOSER REMOTE ISOLATION
DWG. 25\E\1086-019

25-TR-31
33kV/415V
2000 kVA
Dyn11

HV EARTH — SUBSTATION MV EARTH BAR — EARTH GRID

4F 1 — 200A / 200A
4F 2 — 200A / 200A
4F 3 — 250A / 250A
4F 4 — 63A / 63A — CA7-43 — CEP7 16-25 — M — 11 kW
4F 5

5F 1 — 415V 3 PHASE 50Hz 200A FORM 3 EMERGENCY SUPPLY BUSBAR FAULT LEVEL 18kA FOR 1 sec. — 200A — M — M — 200A
5F 2 — 16A / 32A — 415/110V — A N — L1(E) N1(E)
5F 3 — 25A / 32A — BYPASS TRANSFORMER — 25-XE-62 — 25-DB-62
5F 4 — 25A / 32A — BYPASS TRANSFORMER — 25-XE-63 — DB No.1
5F 5 — 16A / 32A — DB No.2

12

4R 3 — 25A
4R 4
4R 5
4R 6
4R 7
4R 8
4R 9
4R 10
4R 11
4R 12

CONTINUED ON DRAWING 25\E\1065-001 2000-F25-SLD-EL-10010

5R 1 — 415V 3 PHASE 50Hz 200A FORM 3 EMERGENCY SUPPLY BUSBAR FAULT LEVEL 18kA FOR 1 sec. — 100A / 100A
5R 2 — 80A / 80A — 3TF46 — 3UA58 32-50 — M — 22 kW
5R 3 — 80A / 80A — BYPASS SWITCH
5R 4 — 80A / 80A — BYPASS SWITCH

Approved	X
Approved as Noted	
Not Approved	
For Information Only	

ACCEPTANCE DOES NOT RELIEVE THE SUPPLIER / CONTRACTOR OF ITS RESPONSIBILITY OR LIABILITIES UNDER THE PURCHASE ORDER / CONTRACT

TO SOUTH SWITCHYARD (D2) #6 - 3H RECLOSER REF. DWG. 180\E\3045

BUS TIE INTERLOCK FROM BUS TIE 3250A ISOLATOR REF. DWG. 25\E\1065-001

33kV 3Ph SUPPLY FROM SOUTH SWITCHYARD (D2) #6 - 3H RECLOSER REF. DWG. 180\E\3045

DIST. BOARD 36A 415V NORMAL DB 36A DISTRIBUTION BOARD REF. DWG. 25\E\1068-001

FEED TO FORM 1 & EMERGENCY SECTIONS J & H

25-CM-31B FLOTATION AREA 2 COMPRESSOR

30-PS-33 FLOTATION TAILS WASHDOWN PUMP REF. DWG. 25\E\1074-004

SPACE

415V EMERGENCY SUPPLY FROM SUB STATION No.7 80-SW-01 CB 25-SW-31 GENSET 80-GE-61 REF. DWG. 80\E\1132

110V CONTROL TRANSFORMER REF. DWG. 25\E\1074-001

TO 25-DB-62 REF. DWG.

25-XE-62 BYPASS TRANSFORMER - UPS 1 REF. DWG. 25\E\1070-003

TO DB No.1 REF. DWG. 25\E\1070-001

25-XE-63 BYPASS TRANSFORMER - UPS 2 REF. DWG. 25\E\1070-002

TO DB No.2 REF. DWG.

25-PC-01 SUB 6 FEEDER B

415V FEED FROM TEIR 5F

SPARE — SPACE — SPACE — SPACE — SPACE — SPACE — SPACE — SPACE — SPACE — SPACE

415V FEED FROM TEIR 5F

DIST. BOARD 36B 415V EMERGENCY DB 36B DISTRIBUTION BOARD REF. DWG. 25\E\1069-001

30-TH-31 CONCENTRATE PRE-LEACH THICKENER 2000-F25-SCM-EL-10001

25-XE-64 CONTROL ROOM UPS REF. DWG. 25\E\1090-001

25-DB-12 240VAC CONTROL ROOM DISTRIBUTION BOARD REF. DWG. 25\E\1070-004

25-XE-65 CONTROL ROOM UPS REF. DWG. 25\E\1090-002


25-DB-13 240VAC CONTROL ROOM DISTRIBUTION BOARD REF. DWG. 25\E\1070-005

LEGEND

LOCATION

SUB STATION 6

25-SW-31

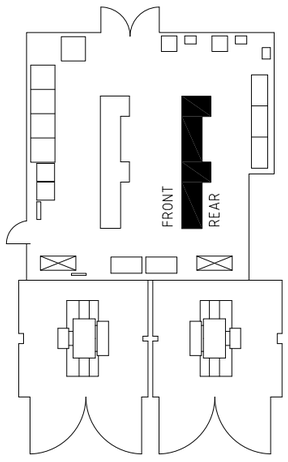

NOTES

1. ALL AFS (ARC FLASH SENSORS) ARE CONNECTED TO THE ARC FLASH RELAY VIA I/O UNITS

LEGEND
- EXISTING
- NON-EXISTENT
- STAGE 1 - NEW
- STAGE 1 - REMOVE
- STAGE 1 - DECOMMISSIONED (OTHERS)
- STAGE 2 - NEW
- STAGE 2 - REMOVE
- STAGE 2 - DECOMMISSIONED (OTHERS)

KCGM GROWTH PROJECT

DRAWING NO. 2000-F25-SLD-EL-10011

REV	DATE	DESCRIPTION	CHECK	TECH APP
0	10/11/25	APPROVED FOR CONSTRUCTION		DM

2000-F25-SLD-EL-10011_Rev0

25-SW-31 sub no. 6 415V MCC 25-SW-31 single line diagram