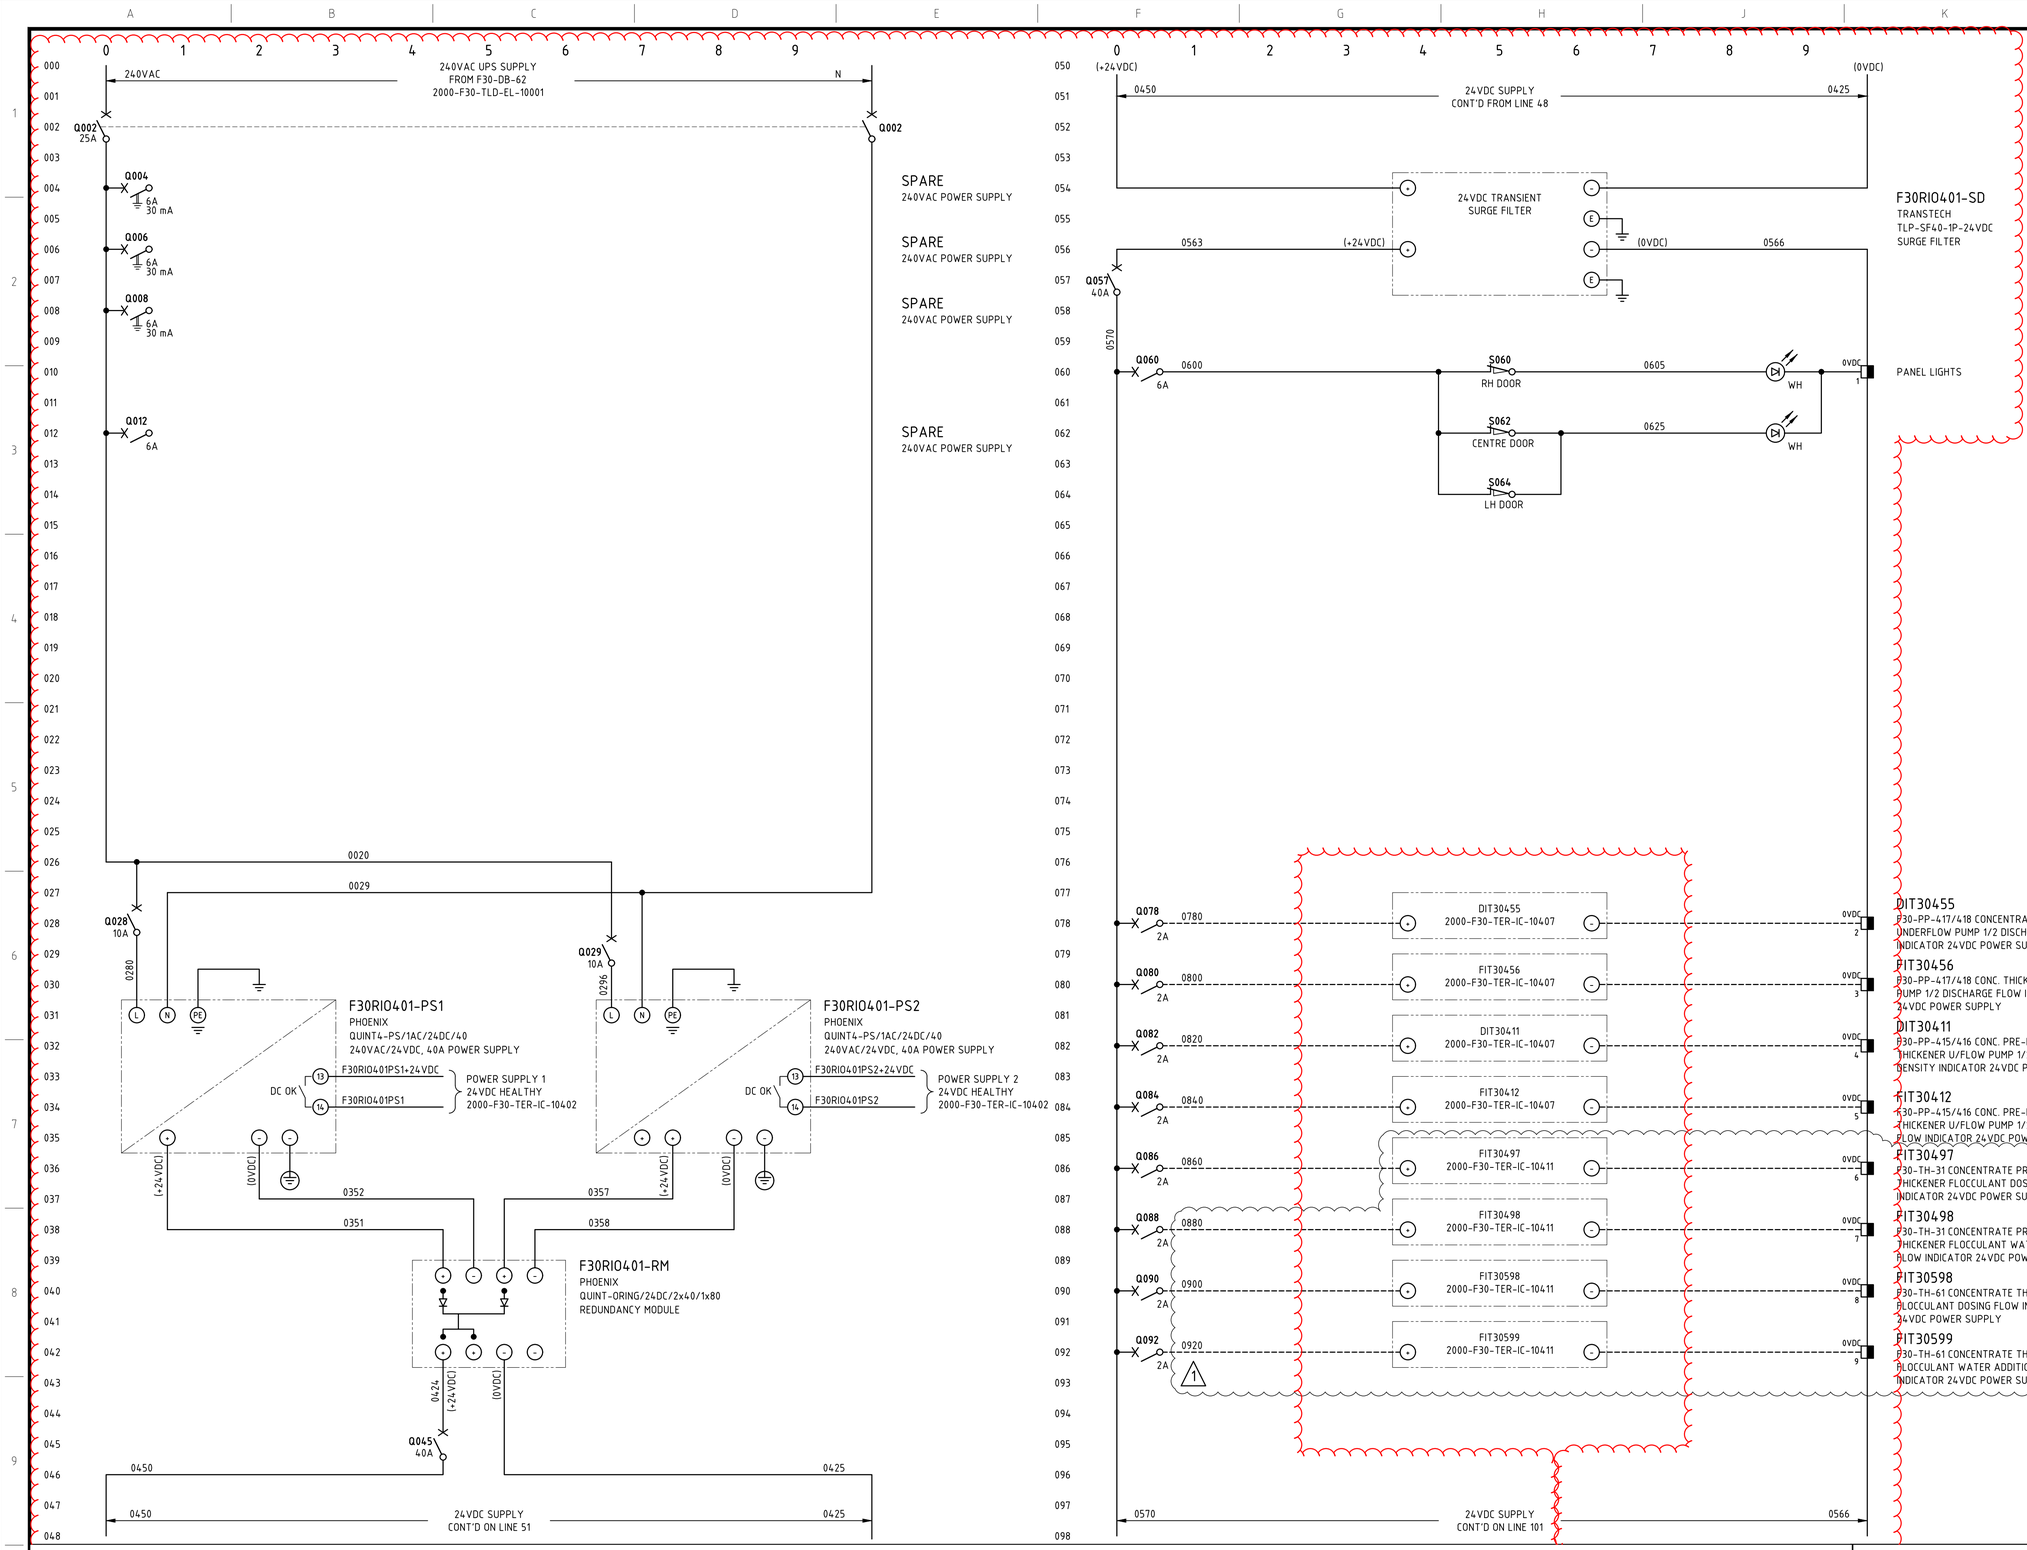


NOTES

1. TERMINALS ON TERMINAL STRIPS ABOVE 50VAC SHALL HAVE A SEPARATE PERSPEX SHROUD AND SHALL BE LABELLED "DANGER xxxVAC".
2. WIRE NUMBER FERRULES ON TERMINAL STRIP SHALL BE PREFIXED WITH EQUIPMENT NUMBER e.g. F30RIO401-xxxx.
3. EACH WIRE SHALL BE IDENTIFIED AT BOTH ENDS WITH FERRULES.
4. FOR NETWORK CONNECTION & BUS CABLING DETAILS REFER TO: RIO PANEL COMMUNICATIONS TERMINATION DIAGRAMS.
5. INSTRUMENT EARTH BAR TO BE BONDED TO MAIN BAR WITH SOLID COPPER LINK.

LEGEND

- FIELD TERMINAL
- DCS OR I/O TERMINAL
- 0VDC TERMINAL FOR 24VDC
- DEVICE TERMINAL
- INDICATION LAMP, cc = COLOUR
- EARTH BAR
- INSTRUMENT EARTH BAR

AS CONSTRUCTED

CHANGE: ☐ NO CHANGE: ☒

SIGNATURE: [redacted]
NAME: Will Herbert
DATE: 05/02/2026

ENGINEER SIGN OFF

SIGNATURE: Sanam Gurung
NAME: Sanam Gurung
DATE: 05/02/2026

2000-F30-SCM-IC-10401_Rev1A

Carbon in leach (CIL3) F30-RIO-401 conc leach & adsorption field n-IO panel schematic diagram sheet 1

O:\CAD PROJECTS\235 NORTHERN STAR RESOURCES LTD\23517 KCGM GROWTH PROJECT\03 DELIVERABLES\CF30 - CIL2_3 & CONCENTRATE THICKENING\2000-F30-SCM-IC-10401.DWG 19NOV25 11:46AM HOTSEAT04