
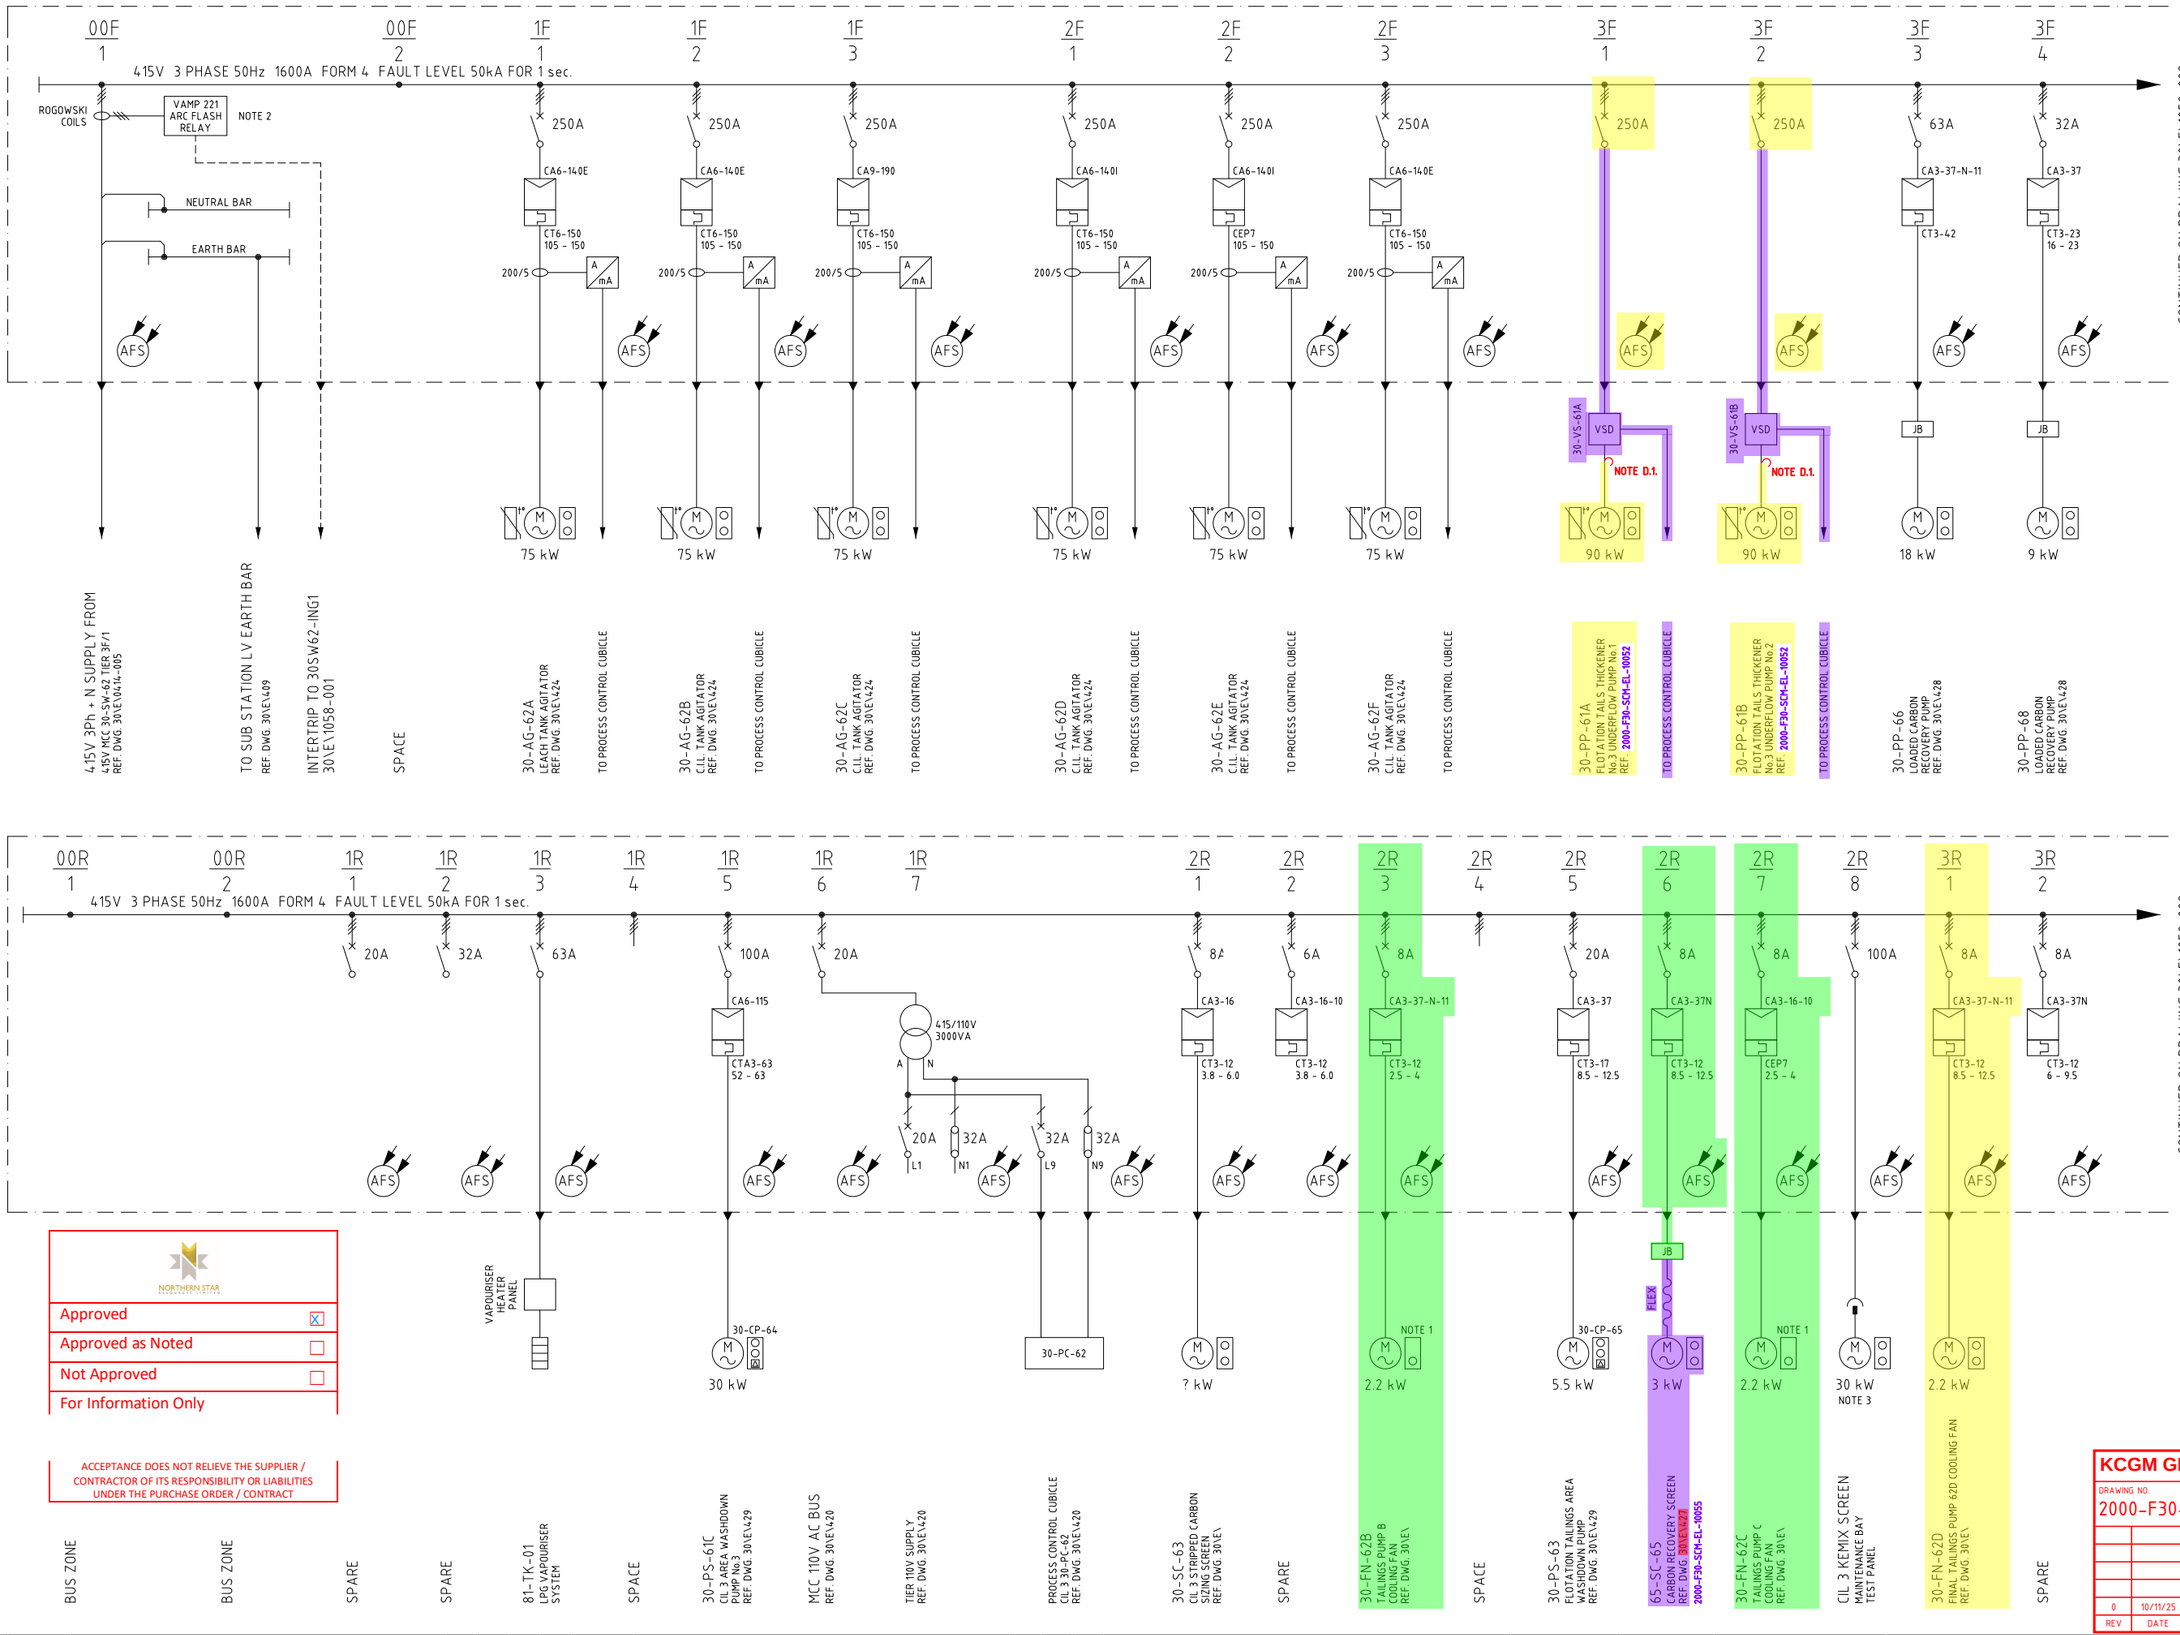


LEGEND

LEGEND
- EXISTING
- NON-EXISTENT
- STAGE 1 - NEW
- STAGE 1 - REMOVE
- STAGE 1 - DECOMMISSIONED (OTHERS)
- STAGE 2 - NEW
- STAGE 2 - REMOVE
- STAGE 2 - DECOMMISSIONED (OTHERS)

LOCATION

SUB STATION 68
30-SW-63

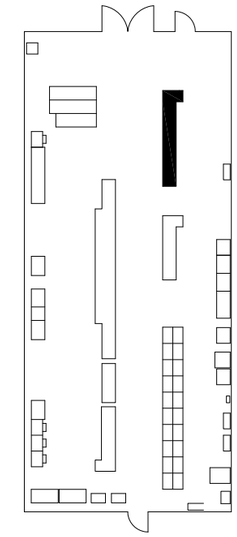

NOTES

1. 30-FN-62B & 62C START/STOP IS INTERLOCKED WITH TAILINGS PUMPS 30-PP-62B & C RESPECTIVELY
2. ALL AFS (ARC FLASH SENSORS) ARE CONNECTED TO THE ARC FLASH RELAY VIA I/O UNITS
3. 30-SC-62B,C,D,E,F ROTATE THROUGH WHEN MAINTENANCE REQUIRED

NORTHERN STAR RESOURCES LIMITED

Approved	☒
Approved as Noted	☐
Not Approved	☐
For Information Only	

ACCEPTANCE DOES NOT RELIEVE THE SUPPLIER / CONTRACTOR OF ITS RESPONSIBILITY OR LIABILITIES UNDER THE PURCHASE ORDER / CONTRACT

KCGM GROWTH PROJECT DEMOLITION NOTES

D.1. VSD OUTGOING FIELD CABLES CABLES TO BE DISCONNECTED AND MADE SAFE AT BOTH ENDS.

KCGM GROWTH PROJECT

DRAWING NO.
2000-F30-SLD-EL-10103

REV	DATE	DESCRIPTION	CHECK	TECH APP
0	10/11/25	APPROVED FOR CONSTRUCTION		DM

2000-F30-SLD-EL-10103_Rev0

SUBSTATION No.68 MCC 30-SW-63 - SINGLE LINE DIAGRAM