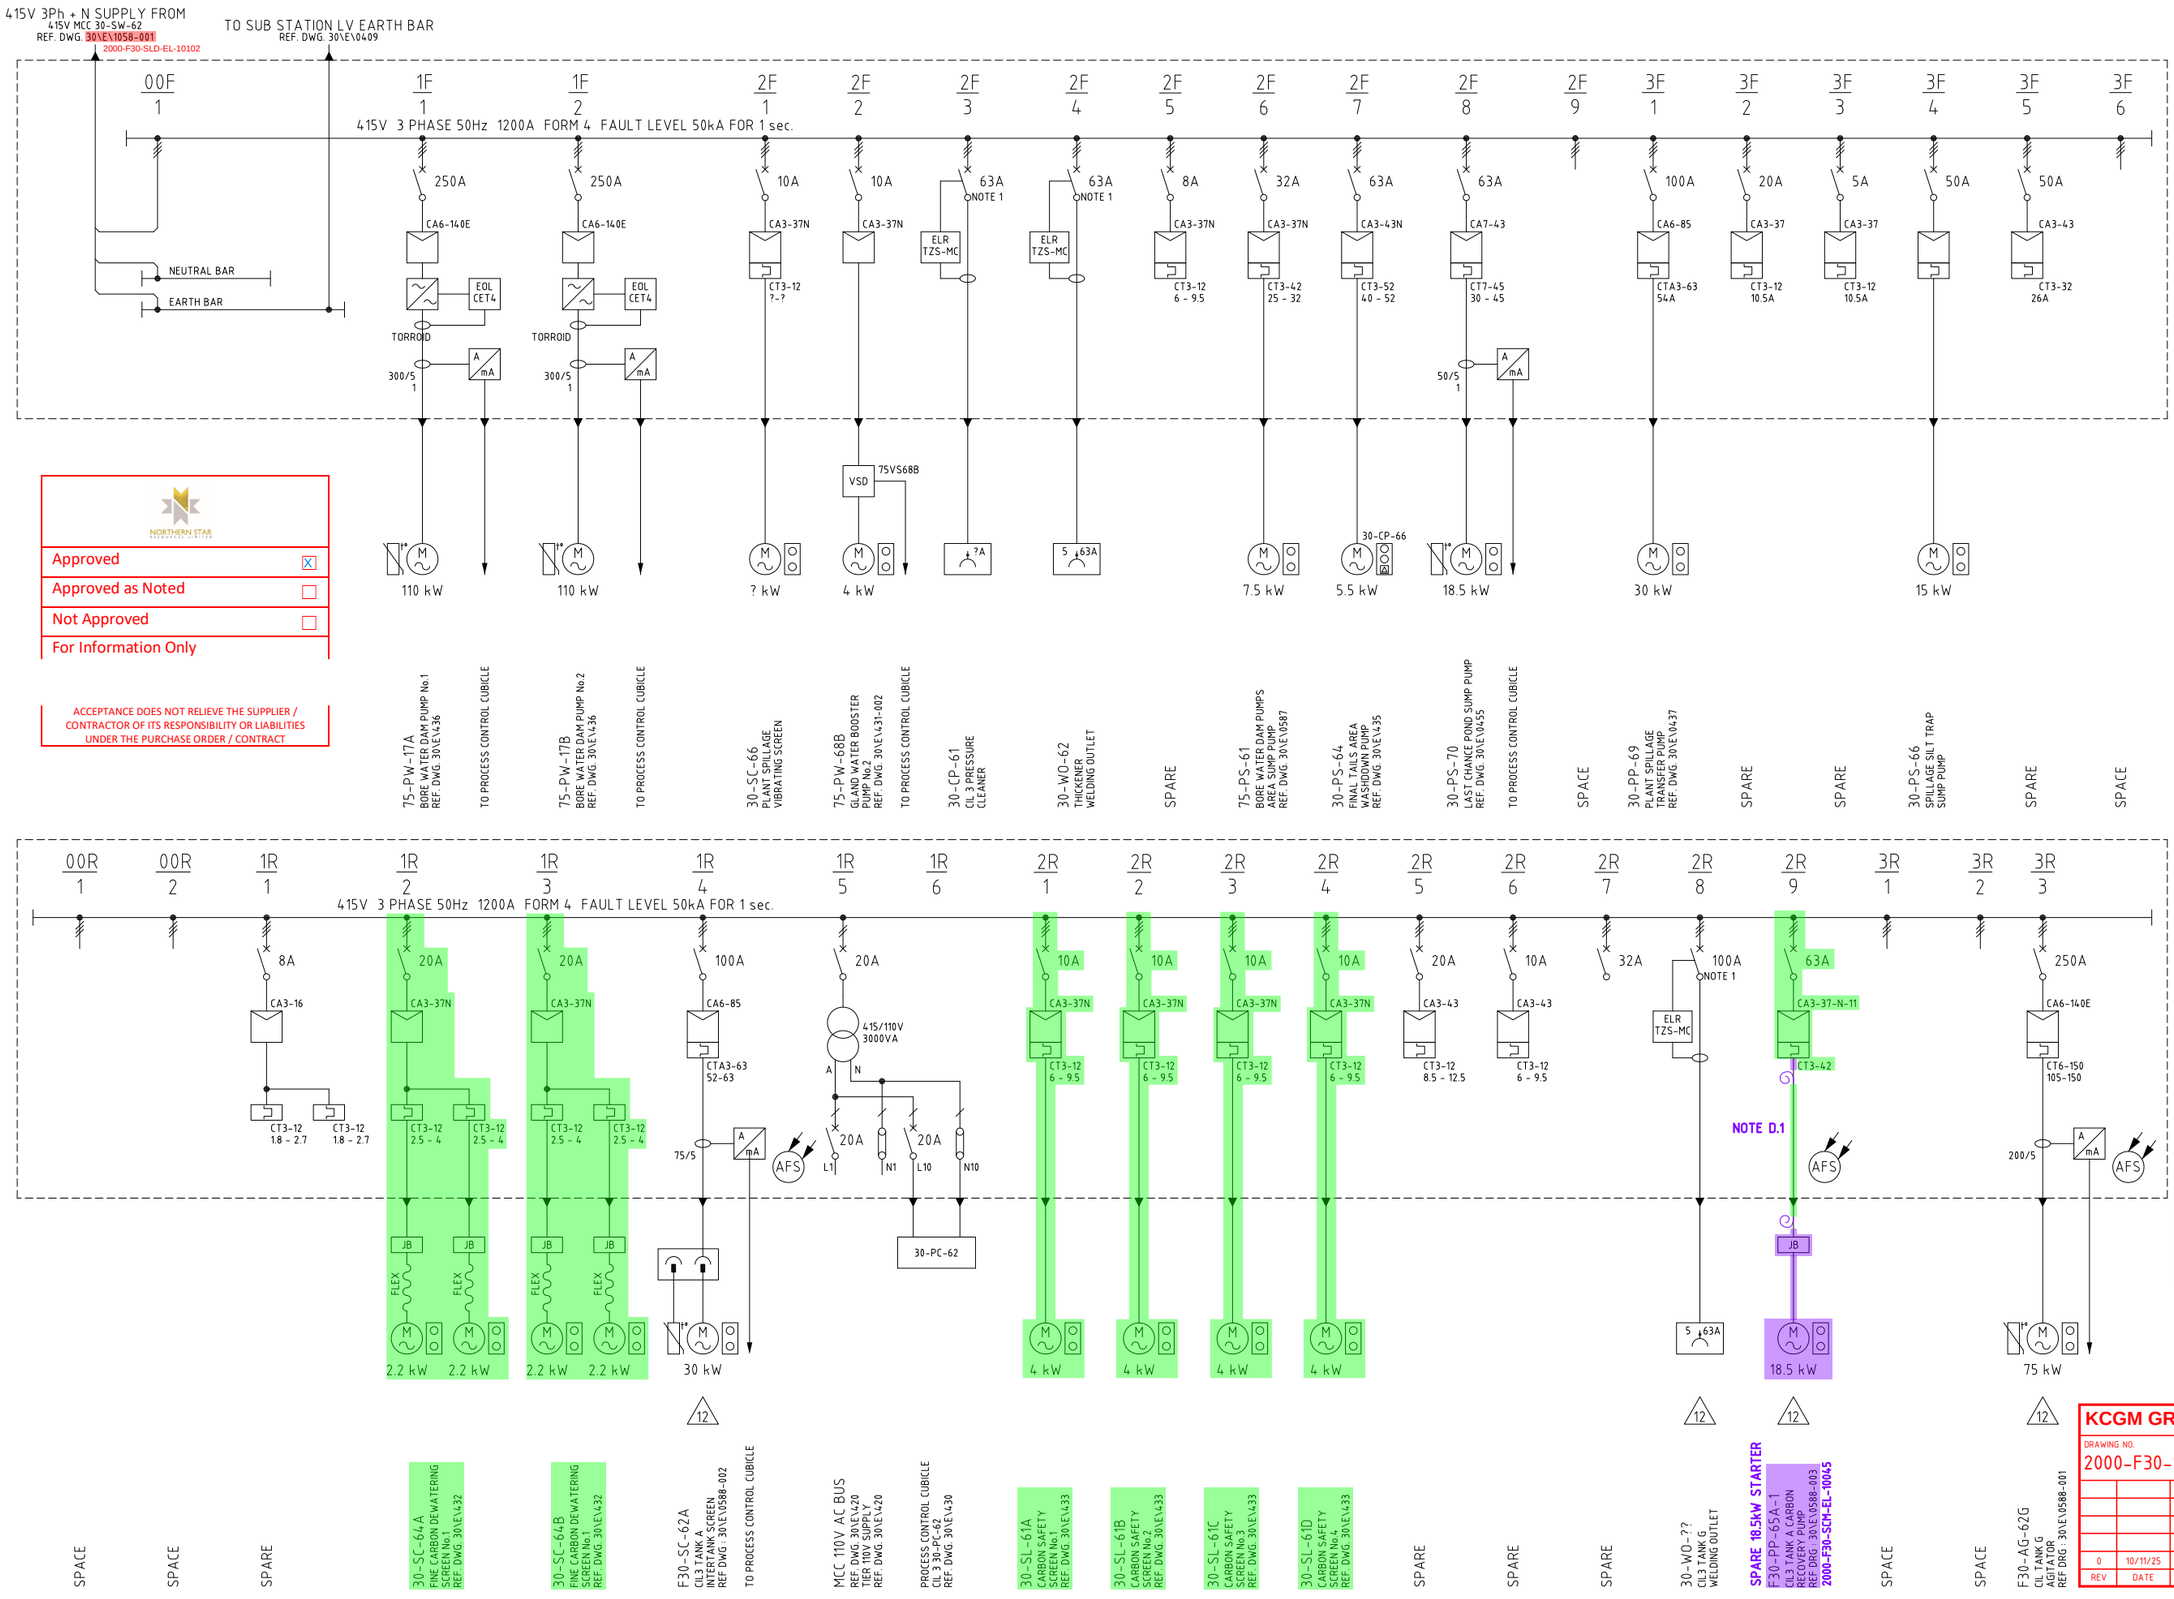



Approved	X
Approved as Noted	
Not Approved	
For Information Only	

ACCEPTANCE DOES NOT RELIEVE THE SUPPLIER / CONTRACTOR OF ITS RESPONSIBILITY OR LIABILITIES UNDER THE PURCHASE ORDER / CONTRACT

LEGEND

LOCATION

SUB STATION 68
30-SW-64

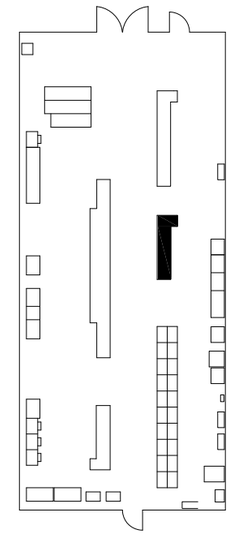

NOTES

1. EARTH LEAKAGE CIRCUIT BREAKERS SHALL HAVE 300mA SENSITIVITY FOR WELDING OUTLETS.

KCGM GROWTH PROJECT DEMOLITION NOTES

D.1. F30-PP-65A-1 CABLING TO BE DISCONNECTED AND MADE SAFE AT BOTH ENDS.

LEGEND
- STAGE 1 - NEW
- STAGE 1 - REMOVE
- STAGE 1 - DECOMMISSIONED (OTHERS)
- STAGE 2 - NEW
- STAGE 2 - REMOVE
- STAGE 2 - DECOMMISSIONED (OTHERS)

KCGM GROWTH PROJECT

DRAWING NO.
2000-F30-SLD-EL-10105

REV	DATE	DESCRIPTION	CHECK	TECH APP
0	10/11/25	APPROVED FOR CONSTRUCTION		

SUPERCEDES 30\E\0410

2000-F30-SLD-EL-10105_Rev0

SUBSTATION No.68 MCC 30-SW-64 - SINGLE LINE DIAGRAM
SHEET 1