CONTINUED ON DRAWING 30\E\1321-002

CONTINUED ON DRAWING 30\E\1321-004

5F 1 | 5F 2 | 5F 3 | 5F 4 | 5F 5 | 6F 1 | 6F 2 | 6F 3 | 6F 4 | 7F 1 | 7F 2

415V 3 PHASE 50Hz 3150A FORM 4 FAULT LEVEL 50kA FOR 1 sec.

	200A/250A	200A/250A	250A/250A		400A	50A	32A	32A	A/250A	32A
	CA6-140EI	CA6-140EI	CA6-140EI		CA5-450	CA343N-11	CA337N-11	CA3-37	CA6-170-EI	CA337N-11
	EOL	EOL	EOL		EDL CET4	CT3-42 32-42	CT3-23 16-23	CT3-23 16-23	EOL	CT3-23 16-23
	CEF1-12	CEF1-12	CEF1-12		CWE4-630				CEF1-12	
	150/5	150/5	150/5		630/4	75/5	75/5	75/5	200/5	75/5
	75 kW	75 kW	75 kW		185 kW	15 kW	11 kW	11 kW	90 kW	11 kW
SPARE	30-AG-32D LEACH TANK AGITATOR REF. DWG 30\E\1341-002	30-AG-32E LEACH TANK AGITATOR REF. DWG 30\E\1341-002	30-AG-32F LEACH TANK AGITATOR REF. DWG 30\E\1341-002	SIZE 0.5 SPACE	75-PW-63B CYANIDE WATER PUMP No.2 REF. DWG 30\E\1341-005	30-PP-32 CARBON TRANSFER PUMP	30-PP-35A CARBON ADVANCE PUMP REF. DWG 30\E\1341-008	30-PP-35B CARBON ADVANCE PUMP REF. DWG 30\E\1341-008	75-PW-71A FLUIDISNG WATER PUMP REF. DWG 30\G\1352-002	30-PP-35C CARBON ADVANCE PUMP REF. DWG 30\E\1341-008
	TO PROCESS CONTROL CUBICLE	TO PROCESS CONTROL CUBICLE	TO PROCESS CONTROL CUBICLE		TO PROCESS CONTROL CUBICLE		TO PROCESS CONTROL CUBICLE	TO PROCESS CONTROL CUBICLE	TO PROCESS CONTROL CUBICLE	TO PROCESS CONTROL CUBICLE

6R 1 | 6R 2 | 6R 3 | 6R 4 | 7R 1 | 7R 2 | 7R 3 | 7R 4 | 7R 5

415V 3 PHASE 50Hz 3150A FORM 4 FAULT LEVEL 50kA FOR 1 sec.

	400A	A/A	8A	125A	100A	100A	100A	100A	100A
	CA5-450		CA3-9	CA6-105	75/5 1 CA6-85	75/5 1 CA6-85	75/5 1 CA6-85	75/5 1 CA6-85	75/5 1 CA6-85
	EDL CET4		CT3-12 4-6	CT6-110 85-110	NOTE C.1. CTA3-63 52-63	NOTE C.1. CTA3-63 52-63	NOTE C.1. CTA3-63 52-63	NOTE C.1. CTA3-63 52-63	NOTE C.1. CTA3-63 52-63
	CWE4-630								
	630/4								
	185 kW	18 kW	2.2 kW	55 kW	30 kW	30 kW	30 kW	30 kW	30 kW
	75-PW-63A CYANIDE WATER PUMP No.1 REF. DWG 30\E\1341-005	30-CR-31 CIL 3 OVERHEAD GANTRY CRANE	30-SC-37 CIL 2 BARON CARBON SIZING SCREEN REF. DWG 30\E\1341-006	75-PW-65 THICKENER PILL PUMP REF. DWG 30\E\1341-007	30-SC-34B CIL2 INTERSTAGE SCREEN 2000-F30-SCM-EL-10202	30-SC-34C CIL2 INTERSTAGE SCREEN 2000-F30-SCM-EL-10202	30-SC-34D CIL2 INTERSTAGE SCREEN 2000-F30-SCM-EL-10202	30-SC-34E CIL2 INTERSTAGE SCREEN 2000-F30-SCM-EL-10202	30-SC-34F CIL2 INTERSTAGE SCREEN 2000-F30-SCM-EL-10202
	TO PROCESS CONTROL CUBICLE				TO PROCESS CONTROL CUBICLE	TO PROCESS CONTROL CUBICLE	TO PROCESS CONTROL CUBICLE	TO PROCESS CONTROL CUBICLE	TO PROCESS CONTROL CUBICLE

LEGEND


NORTHERN STAR RESOURCES LIMITED

Approved	X
Approved as Noted	
Not Approved	
For Information Only	

ACCEPTANCE DOES NOT RELIEVE THE SUPPLIER / CONTRACTOR OF ITS RESPONSIBILITY OR LIABILITIES UNDER THE PURCHASE ORDER / CONTRACT

LOCATION

SUB STATION 38
30-SW-31

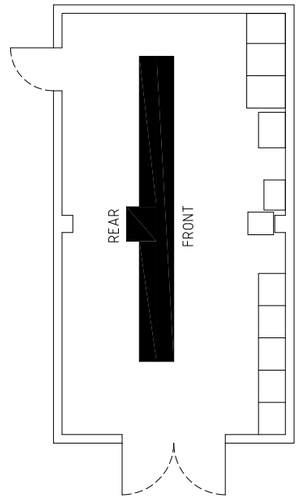

NOTES

1. WHERE DRIVES & FEEDERS REQUIRE 2 OFF CIRCUIT BREAKER AUXILLARIES THEN AN ADDITIONAL POLE SPACE IS REQUIRED.
   No. OF POLES USED SHOWN IN BRACKETS.
2. FUSES TO BE RATED FOR TYPE 2 SHORT CIRCUIT CO-ORDINATION.
3. ALL AFS (ARC FLASH SENSORS) ARE CONNECTED TO THE ARC FLASH RELAY VIA I/O UNITS

KCGM GROWTH PROJECT CONSTRUCTION NOTES

C.1. INSTALLED CABLES TO BE DISCONNECTED AND MADE SAFE AT BOTH ENDS.

LEGEND

- EXISTING
- NON-EXISTENT
- STAGE 1 - NEW
- STAGE 1 - REMOVE
- STAGE 1 - DECOMMISSIONED (OTHERS)
- STAGE 2 - NEW
- STAGE 2 - REMOVE
- STAGE 2 - DECOMMISSIONED (OTHERS)

KCGM GROWTH PROJECT

DRAWING NO.
2000-F30-SLD-EL-10201

REV	DATE	DESCRIPTION	CHECK	TECH APP
0	10/11/25	APPROVED FOR CONSTRUCTION		DM

SUPERSEDES 30\E\1036-003

2000-F30-SLD-EL-10201_Rev0

Leach adsorption & thickening substation no. 38 MCC 30-SW-31 single line diagram