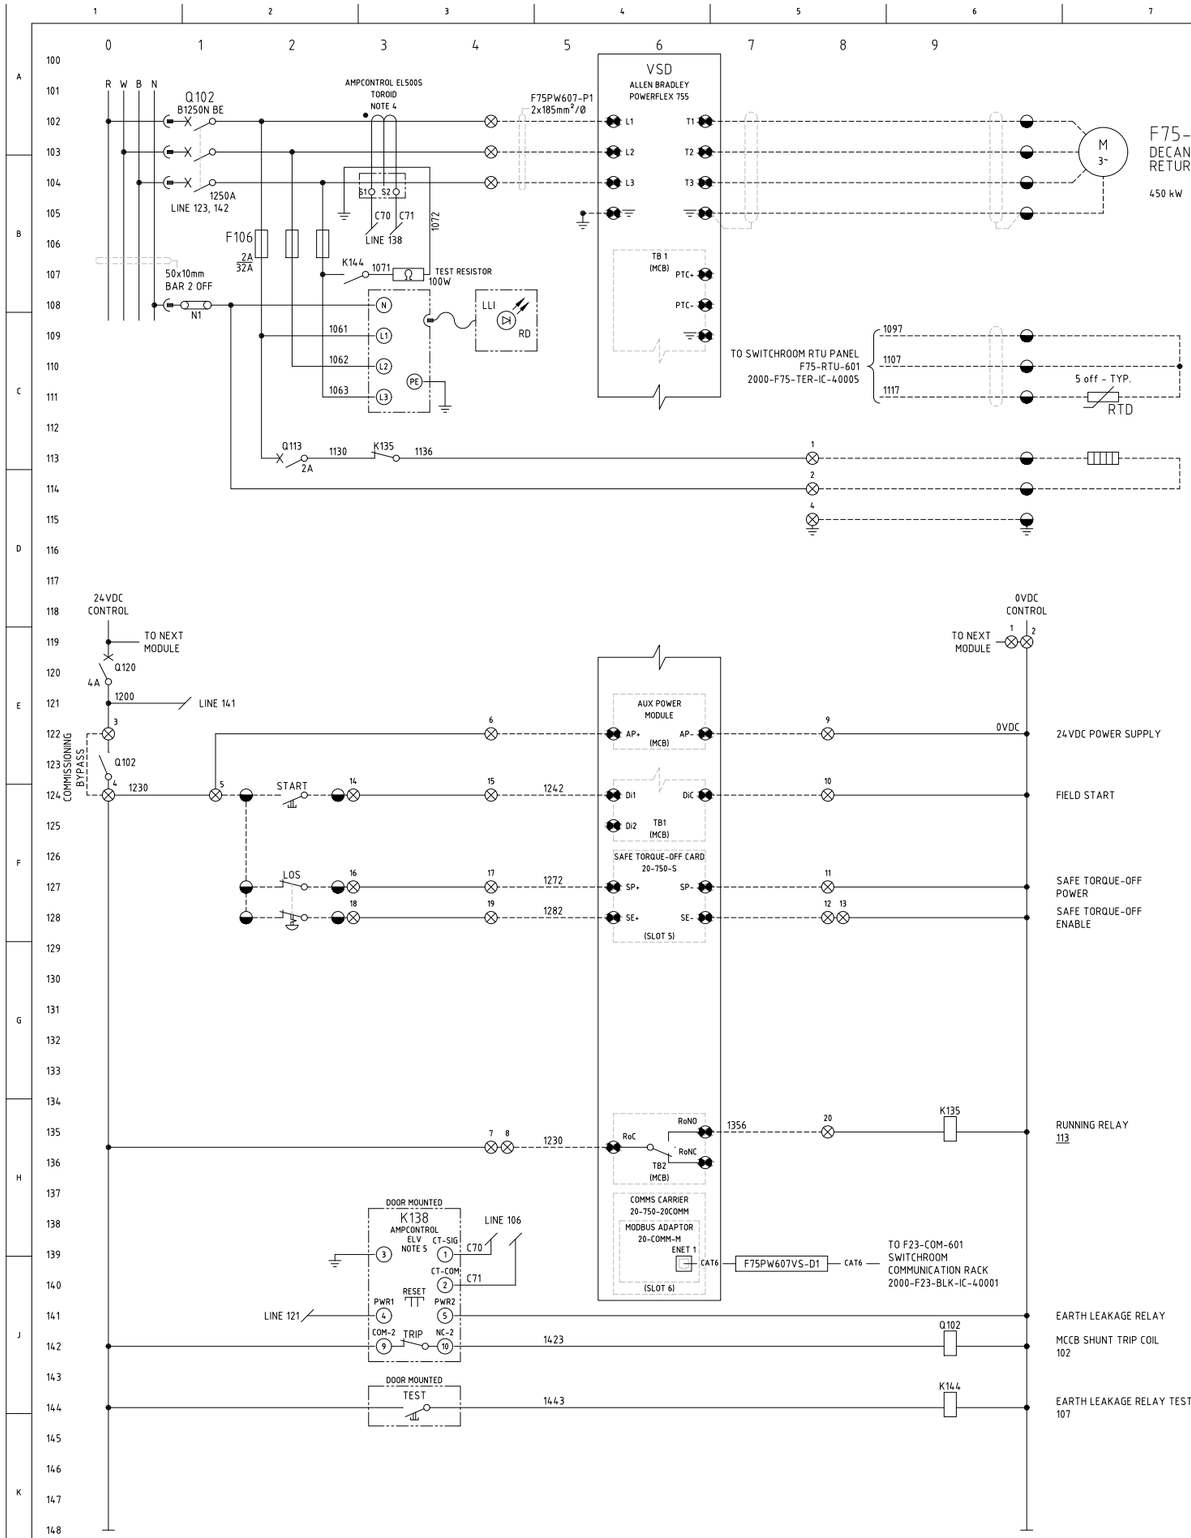



NOTES

1. TERMINALS ON TERMINAL STRIPS ABOVE 50VAC SHALL HAVE A SEPARATE PERSPEX SHROUD AND SHALL BE LABELLED "DANGER xxxVAC".
2. WIRE NUMBER FERRULES ON TERMINAL STRIP SHALL BE PREFIXED WITH EQUIPMENT NUMBER e.g. F75PW607-1200.
3. EACH WIRE SHALL BE IDENTIFIED AT BOTH ENDS WITH FERRULES.
4. THE ELV RELAY REQUIRES A SEPARATELY PURCHASED EL500S TOROID FOR MEASUREMENT OF THE EARTH LEAKAGE CURRENT. EL500S TOROIDS ARE AVAILABLE IN THE FOLLOWING WINDOW SIZES: 25mm, 60mm & 112mm. AMPCONTROL (177655) 100/1
5. EARTH LEAKAGE RELAY (ELV) USER INTERFACE TO BE MOUNTED ON MCC MODULE DOOR. RELAY SETTINGS SET TO: TRIP LEVEL = "1A" (POSITION 0). TRIP DELAY = "100ms" (POSITION 1). AMPCONTROL (170447).
6. 240VAC TERMINALS FOR THE HEATER CIRCUITS SHALL BE LOCATED IN THE MCC DRIVE MODULE.
7. REFER TO CABLE SCHEDULE 2000-F23-LST-EL-40003.
8. 24VDC TERMINATED TO P13 TERMINALS AT BOTTOM OF MAIN CARD AUX AT TOP IS SPARE.


LEGEND

- 00/01/00 — DCS DIGITAL INPUT
- 00/02/00 — DCS DIGITAL OUTPUT
- MCC TERMINAL
- VSD TERMINAL
- FIELD TERMINAL
- DCS OR I/O TERMINAL
- MARSHALLING TERMINAL
- DEVICE TERMINAL
- INDICATION LAMP (cc = COLOUR)

DCS LEGEND

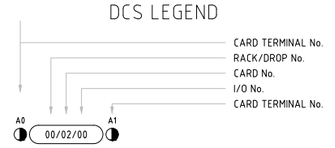

TERMINATION LEGEND

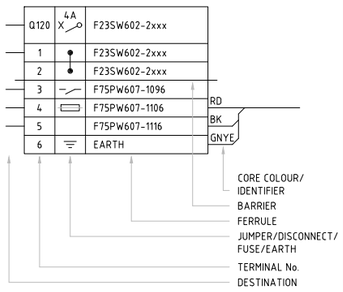

MCC CELL LOCATION 2F-01

AS BUILT

2000-F75-SCM-EL-40002_Rev2

FIM III booster station F75-PW-607 decant dam 4 return pump 2 control schematic diagram