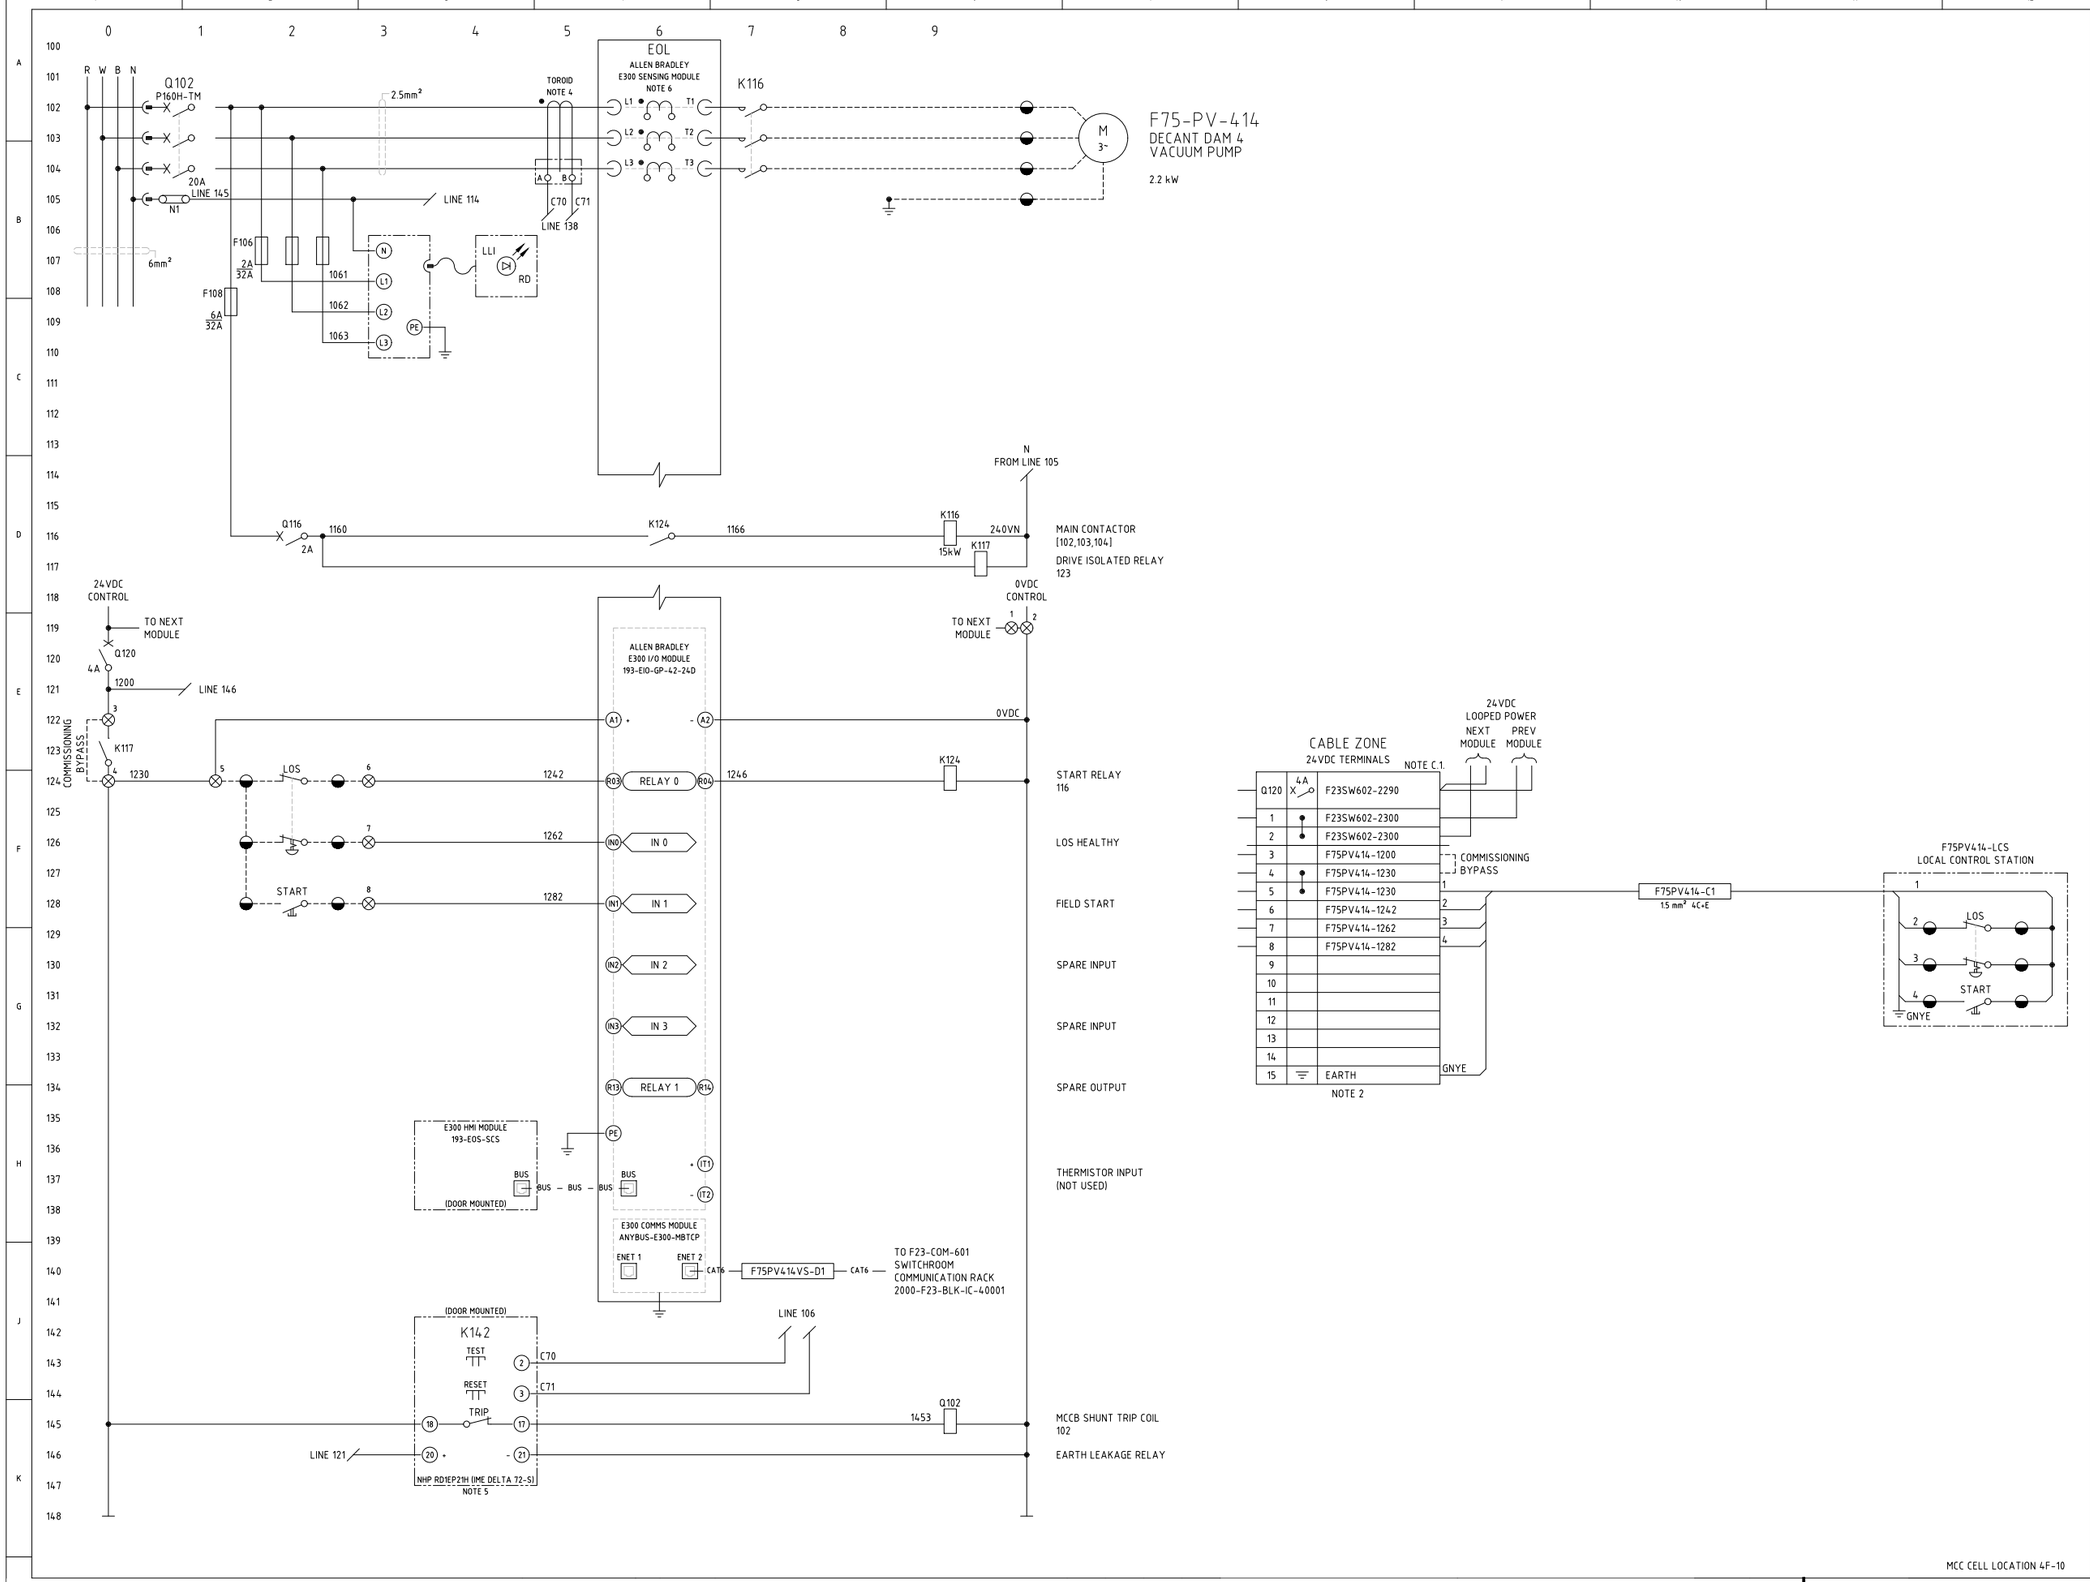


CABLE ZONE
24VDC TERMINALS
NOTE C.1.

Q.120	4A	F23SW602-2290
1		F23SW602-2300
2		F23SW602-2300
3		F75PV414-1200
4		F75PV414-1230
5		F75PV414-1230
6		F75PV414-1242
7		F75PV414-1262
8		F75PV414-1282
9		
10		
11		
12		
13		
14		
15		EARTH

NOTE 2

24VDC LOOPED POWER
NEXT MODULE
PREV MODULE

COMMISSIONING BYPASS

F75PV414-C1
1.5 mm² 4C+E

F75PV414-LCS
LOCAL CONTROL STATION

MCC CELL LOCATION 4F-10

NOTES

1. TERMINALS ON TERMINAL STRIPS ABOVE 50VAC SHALL HAVE A SEPARATE PERSPEX SHROUD AND SHALL BE LABELLED "DANGER xxxVAC".
2. WIRE NUMBER FERRULES ON TERMINAL STRIP SHALL BE PREFIXED WITH EQUIPMENT NUMBER e.g. F23PV414-1200.
3. EACH WIRE SHALL BE IDENTIFIED AT BOTH ENDS WITH FERRULES.
4. THE ELV RELAY REQUIRES A SEPARATELY PURCHASED EL500S TOROID FOR MEASUREMENT OF THE EARTH LEAKAGE CURRENT. EL500S TOROIDS ARE AVAILABLE IN THE FOLLOWING WINDOW SIZES: 25mm, 60mm & 112mm. (TDGB2) In:70A
5. EARTH LEAKAGE RELAY (ELV) USER INTERFACE TO BE MOUNTED ON MCC MODULE DOOR.
   RELAY SETTINGS SET TO:
   TRIP LEVEL ="1A" (POSITION 0).
   TRIP DELAY = "100ms" (POSITION 1).
6. E300 SENSING MODULE FOR VOLTAGE/ CURRENT/ GROUND FAULT (VIG RANGE) TO SUIT MOTOR KW DUTY. (193-ESM-I-30A-T) 0.5-30A
7. REFER TO CABLE SCHEDULE 2000-F23-LST-EL-40003.

LEGEND

- 00/01/00 — DCS DIGITAL INPUT
- 00/02/00 — DCS DIGITAL OUTPUT
- ⊗ — MCC TERMINAL
- ◓ — VSD TERMINAL
- ◒ — FIELD TERMINAL
- ◑ — DCS OR I/O TERMINAL
- ◧ — MARSHALLING TERMINAL
- (x) — DEVICE TERMINAL
- ⊗ cc — INDICATION LAMP, cc = COLOUR

DCS LEGEND



TERMINATION LEGEND

Q.120	4A	F23SW602-2xxx
1		F23SW602-2xxx
2		F23SW602-2xxx
3		F75PV414-1096
4		F75PV414-1106
5		F75PV414-1116
6		EARTH

RD
BK
GNYE

CORE COLOUR/ IDENTIFIER
BARRIER
FERRULE
JUMPER/DISCONNECT/ FUSE/EARTH
TERMINAL No.
DESTINATION

AS BUILT

2000-F75-SCM-EL-40004_Rev2

FIM III booster station F75-PV-414 decant dam 4 vacuum pump control schematic diagram