
CONTINUED ON SHT 2
2000-F13-SLD-EL-10702

F13-SR-005
415V MILL CHILLERS & REAGENTS SWITCHROOM

F13-SW-020
MILL CHILLERS & REAGENTS 415V MOTOR CONTROL CENTRE

CONTINUED ON SHT 4
2000-F13-SLD-EL-10704

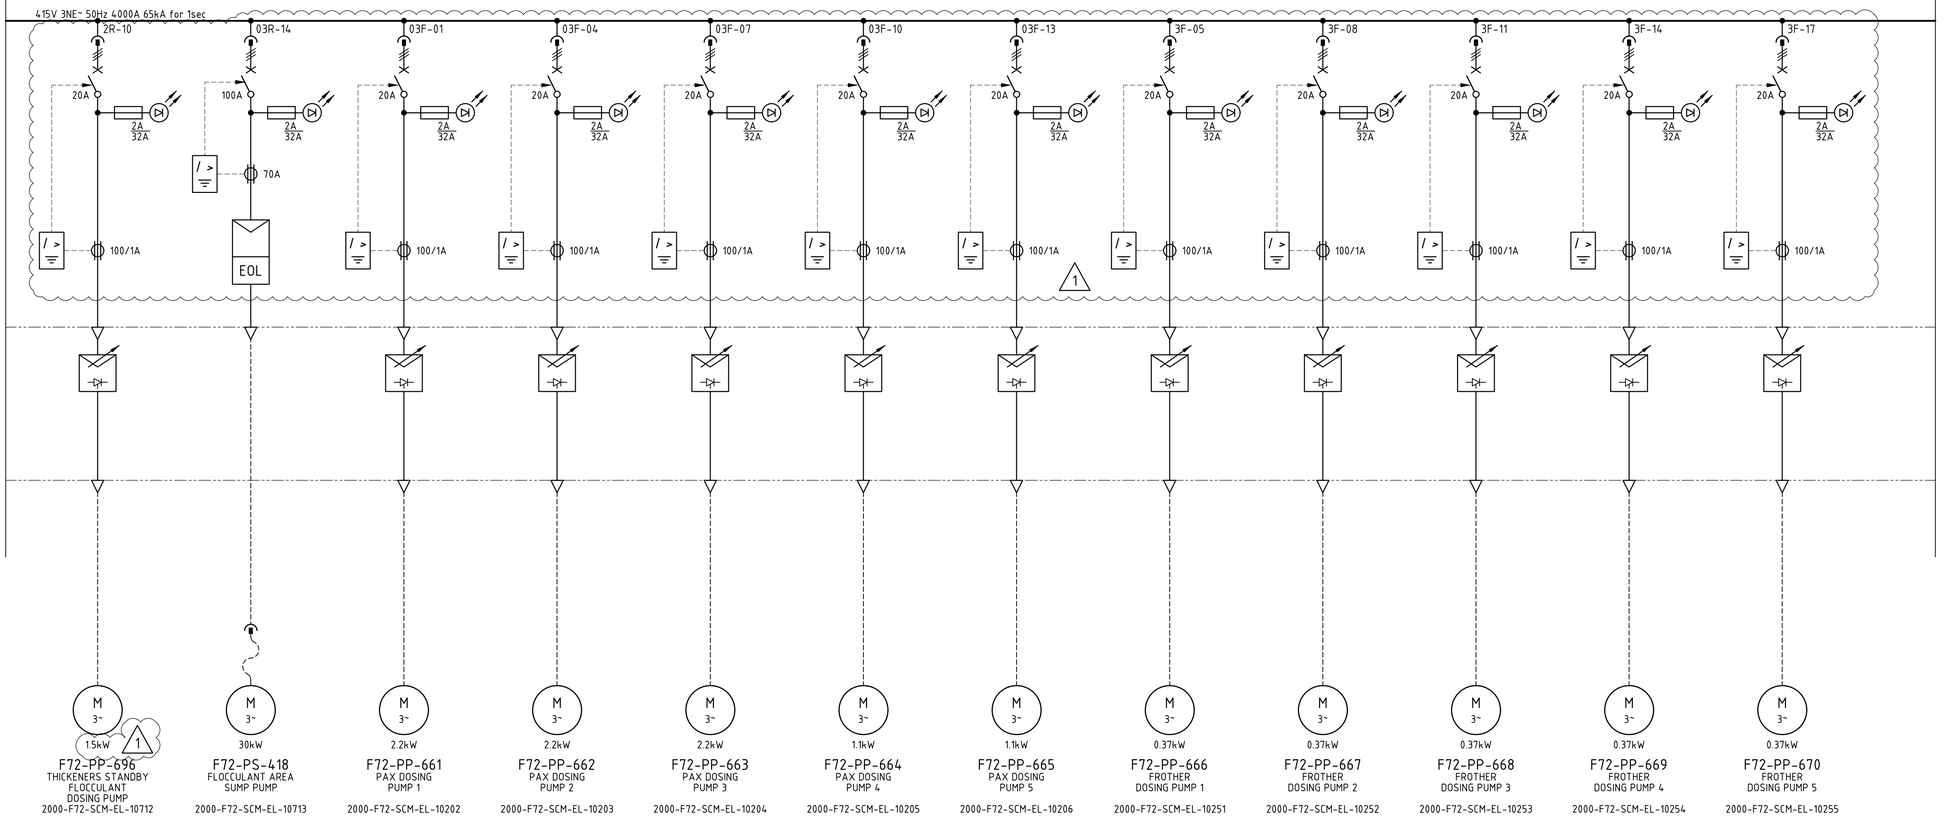


## NOTES

1. REFER TO SHEET 1.

## LEGEND

1. REFER TO SHEET 1.

| | | | | | | | | | |
|---|---|---|---|---|---|---|---|---|---|
| | | | | | | | | | |
| 2000-F13-SCM-EL-10703 | F13-SW-020 415V MCC ARC FLASH SYSTEM SCHEMATIC DIAGRAM | | | | | | | | |
| 2000-F13-SCM-EL-10702 | F13-SW-020 415V MCC 24VDC DISTRIBUTION SCHEMATIC DIAGRAM | | | | | | | | |
| 2000-F13-SCM-EL-10701 | F13-SW-020 415V MCC INCOMER SCHEMATIC DIAGRAM | | | | | | | | |
| 2000-F13-DRG-EL-10121 | F13-SR-005 415V SWITCHROOM ELECTRICAL EQUIPMENT LAYOUT | | | | | | | | |
| 2000-F13-BLK-EL-10341 | F13-SR-005 415V SWITCHROOM AND REMOTE I/O COMMUNICATIONS BLOCK DIAGRAM | | | | | | | | |
| 2000-F13-SLD-EL-10701 | F13-SW-020 415V MCC SINGLE LINE DIAGRAM SHEET 1 | | | | | | | | |
| 2000-F00-SLD-EL-10002 | F00-SW-010 33kV SWITCHBOARD SINGLE LINE DIAGRAM SHEET 1 OF 5 | 1 | 29MAY25 | FAT REDLINES INCORPORATED | [redacted] | | | | |
| 2000-F00-STD-EL-10001 | GENERAL NOTES AND STANDARD DRAWINGS INDEX | 0 | 25MAR24 | APPROVED FOR CONSTRUCTION | | | | | |
| DRG No. | REFERENCES | REV | DATE | DESCRIPTION | DRAW | CHECK | DESIGN | TECH APP | PROJ APP |

NORTHERN STAR RESOURCES LIMITED

INFORMATION AND REPRESENTATIONS ON THIS DRAWING ARE THE INTELLECTUAL PROPERTY OF PRIMERO UNLESS SPECIFICALLY IDENTIFIED OTHERWISE. ALL RIGHTS INCLUDING USE RESERVED

PRIMERO
primero.com.au | DESIGN | CONSTRUCT | OPERATE

PRIMERO PROJECT NUMBER: 23517

| | |
|---|---|
| Approved | X |
| Approved as Noted | |
| Not Approved | |
| For Information Only | |

Signed [redacted] Date 24.06.2025

ACCEPTANCE DOES NOT RELIEVE THE SUPPLIER / CONTRACTOR OF ITS RESPONSIBILITY OR LIABILITIES UNDER THE PURCHASE ORDER / CONTRACT

PROJECT: NORTHERN STAR RESOURCES LTD
KCGM GROWTH PROJECT

TITLE: MILLING & CLASSIFICATION
F13-SW-020 415V MCC
SINGLE LINE DIAGRAM SHEET 3

| SHEET | SCALE | DRG No. | REVISION |
|---|---|---|---|
| A1 | NONE | 2000-F13-SLD-EL-10703 | 1 |

O:\CAD PROJECTS\235 NORTHERN STAR RESOURCES LTD\23517 KCGM GROWTH PROJECT\03 DELIVERABLES\EL\F13 - MILLING & CLASSIFICATION\2000-F13-SLD-EL-10703.DWG 30MAY25 8:08AM SANDRA CULL