
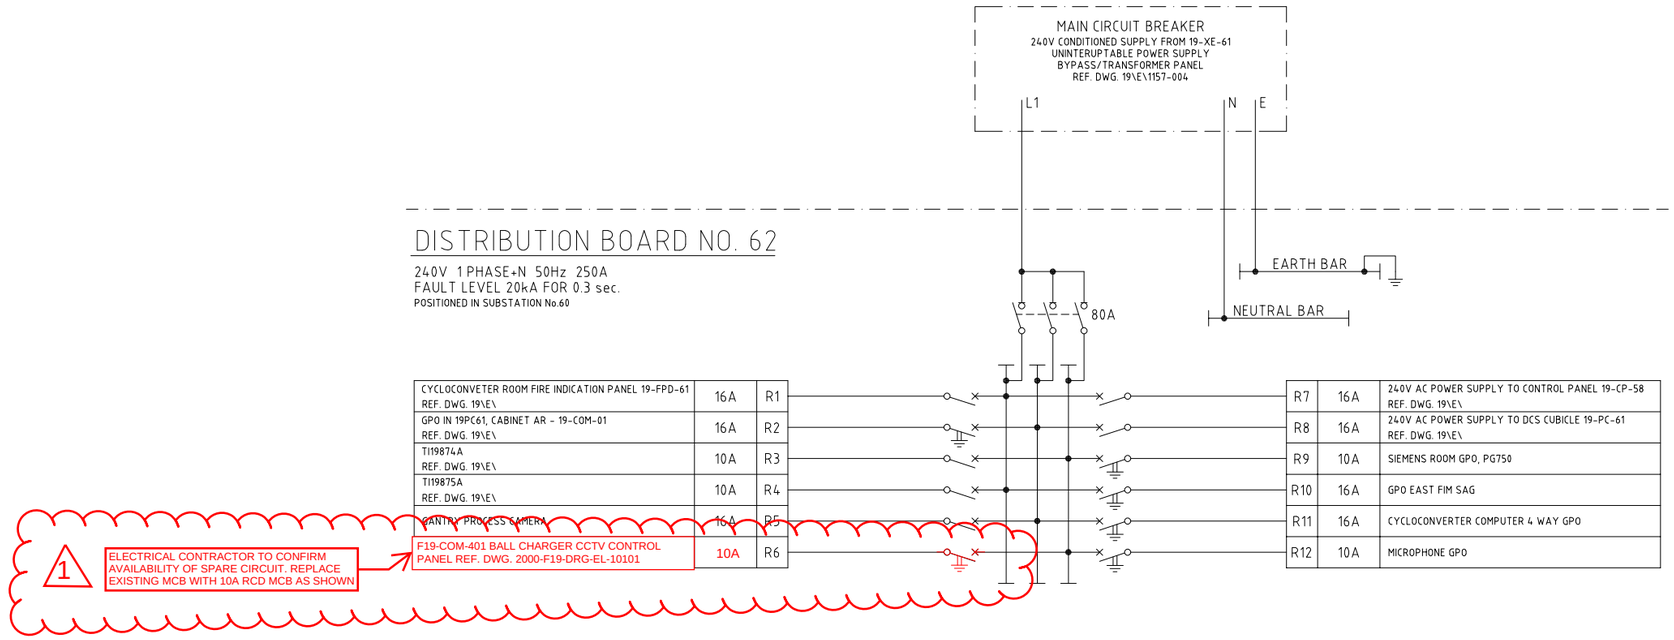


LEGEND

- CIRCUIT BREAKER
- ISOLATOR
- CIRCUIT BREAKER RCD 30mA

LOCATION

SUB STATION 60
19-DB-62

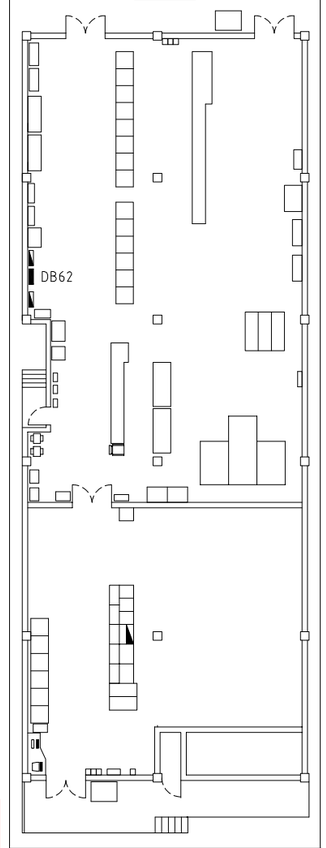

NOTES

PRIMERO
primero.com.au | DESIGN | CONSTRUCT | OPERATE

KCGM GROWTH PROJECT

DRAWING NO.
2000-F19-TLD-EL-10002

REV.: 1

DESIGN APPR.:

DATE: 09/11/23

						4C	01/10/19	RE-ISSUED FOR CONSTRUCTION	PGI	PDW	DP	SUB STATION No.60 DCS CUBICLE 19-PC-51 AND 19-PC-61 MARSHALLING TERM.	19\ E\ 1167-1168	SCALE	NTS	
						4B	25/02/19	ISSUED FOR CONSTRUCTION	RH	DC	DC	SUB STATION No.60 MCC 19-SW-61, 63 CABLE ZONE TERMINATIONS	19\ E\ 1163-1164	DRAWN	G.SOFIELD	10/10/97
						4A	20/02/19	IFR - SIEMENS UPGRADE PROJECT	RH	DC	DC	SUB STATION No.60 POWER SCHEMATICS	19\ E\ 1160	DESIGNED	G.SOFIELD	10/10/97
						3	23-4-04	AS BUILT APRIL 2004	BJ DB			SUB STATION No.60 MCC 19-SW-51, 61, 62, 63 SINGLE LINE DIAGRAMS	19\ E\ 1155-1159	CHECKED	G.SOFIELD	10/10/97
6	25/03/22	SUBSTATION LAYOUT UPDATED	RH	RH	RH	2	11/97	FIMISTON SAG LOAD CELL	CV			SUB STATION No.60 MCC 19-SW-51, 61, 62, 63 DRIVE PANEL LAYOUT	19\ E\ 1150-1153	APPROVED	A.BRADY	10/10/97
5	22/03/22	REVISION 4 SIERIES NOT IMPLEMENTED - ASBUILT	RH	GEC	JMR	1	10/97	'AS BUILT' FIMISTON PLANT 1997 CONTRACT# 700746	G.S	G.S	A.B	SUB STATION No.60 MCC AND GENERAL EQUIPMENT LAYOUT	19\ E\ 1050	PROJ.APP	A.BRADY	10/10/97
MK	DATE	REVISION	BY	CKD	APP	MK	DATE	REVISION	BY	CKD	APP	REFERENCE DRAWINGS	DWG NO.	PROJ. FILE #.		

FIMISTON PLANT
MILLING AND CLASSIFICATION
240V INSTRUMENT DISTRIBUTION BOARD No.62
POWER SCHEMATIC

SIZE	DRAWING NUMBER	REV
A1	19\E\1160-002	6

KALGOORLIE CONSOLIDATED GOLD MINES PTY. LTD. ACN 009 377 619