
Docusign Envelope ID: D3EAC8FF-146A-4610-AFF4-26203B4BB02C

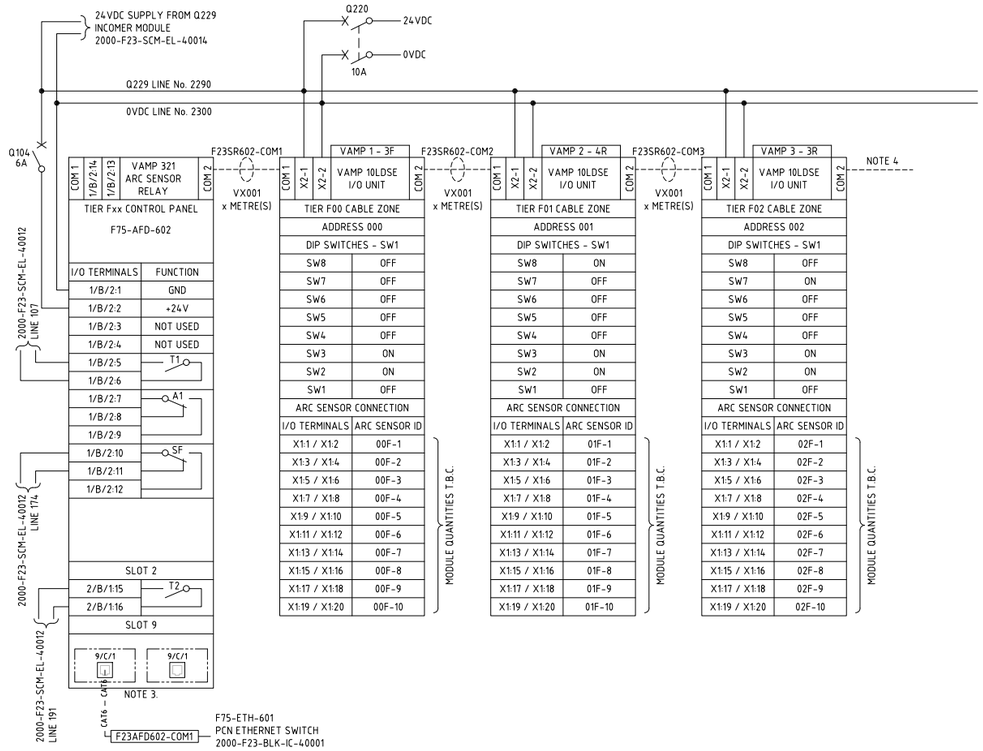


## NOTES

1. CABLE NUMBER FOR ARC FLASH SENSOR VA1DA SHALL BE THE EQUIPMENT NUMBER FOLLOWED BY C FOR CONTROL AND A SEQUENTIAL NUMBER e.g. F23SW602-COMx.
2. EACH CABLE SHALL BE IDENTIFIED AT BOTH ENDS WITH CABLE NUMBER.
3. VAMP 321 ARC FAULT PROTECTION RELAY SHALL BE MOUNTED TO THE DOOR OF THE PANEL INCOMER CONTROL CUBICLE.
4. VAM 10LDSE INTERFACE SHALL BE MOUNTED ON THE CABLE ZONE DOOR.
5. MAXIMUM 16 VAM10LDSE I/O UNITS IN SERIES.
6. MAXIMUM LENGTH OF VX001 CABLE BETWEEN 2 UNITS (I/O UNITS OR VAMP321 UNIT) IS 30m & TOTAL LENGTH OF THE BUS CABLE FROM THE START TO THE END OF 100m SHALL NOT BE EXCEEDED.

## LEGEND

FxxSRxxx-COMx — CABLE MARKER LABEL

24VDC SUPPLY CABLE

COMMUNICATION CABLE

| DIP SWITCHES KEY VAMP 10LDSE | | |
|---|---|---|
| | ON | OFF |
| SW8 | 1 | 0 |
| SW7 | 2 | 0 |
| SW6 | 4 | 0 |
| SW5 | 8 | 0 |
| SW4 | 16 | 0 |
| SW3 | L> | L> + I> |
| SW2 | LATCH | NON LATCHING |
| SW1 | L> INT | L> EXT |

L = LIGHT / I = CURRENT

AS BUILT

| REFERENCES | DWG No | REV | DATE | REVISION | DRN | CHK | TECH APP | PROJ APP |
|---|---|---|---|---|---|---|---|---|
| FIM III BOOSTER STATION CONTROL SYSTEM & COMMUNICATIONS BLOCK DIAGRAM | 2000-F23-BLK-IC-40001 | | | | MZ | JC | | MB |
| F23-SW-602 LV MOTOR CONTROL CENTRE 24VDC DISTRIBUTION SCHEMATIC DIAGRAM | 2000-F23-SCM-EL-40014 | 1 | 13.MAR.26 | AS BUILT FOR FIM III TSF | MZ | EA | MC | MBB |
| F23-SW-602 LV MOTOR CONTROL CENTRE INCOMER SCHEMATIC DIAGRAM SHEET 2 | 2000-F23-SCM-EL-40012 | 0 | 24.MAR.25 | APPROVED FOR CONSTRUCTION | PM | KVN | DK | TH |

NORTHERN STAR RESOURCES LIMITED

DRA PACIFIC (PTY) LIMITED

| | | |
|---|---|---|
| DRAWN | [redacted] | 11.NOV.2024 |
| CHECKED | J.Y.WEE | 11.[redacted].2024 |
| DESIGNED | [redacted] | 11.NOV.2024 |
| TECH APP | [redacted] | 09.DEC.2024 |
| PROJ APP | [redacted] | 21.MAR.2025 |
| CLIENT APP | | |

PROJECT: KCGM
FIM TSF PROJECT
[redacted] FIM III BOOSTER STATION
F23-SW-602 LV MOTOR CONTROL CENTRE
ARC FLASH CONNECTION DIAGRAM

[redacted]1 | SCALE NTS | DRG No. 2000-F23-SCM-EL-40013 | REV 1