
Docusign Envelope ID: D3EAC8FF-146A-4610-AFF4-26203B4BB02C

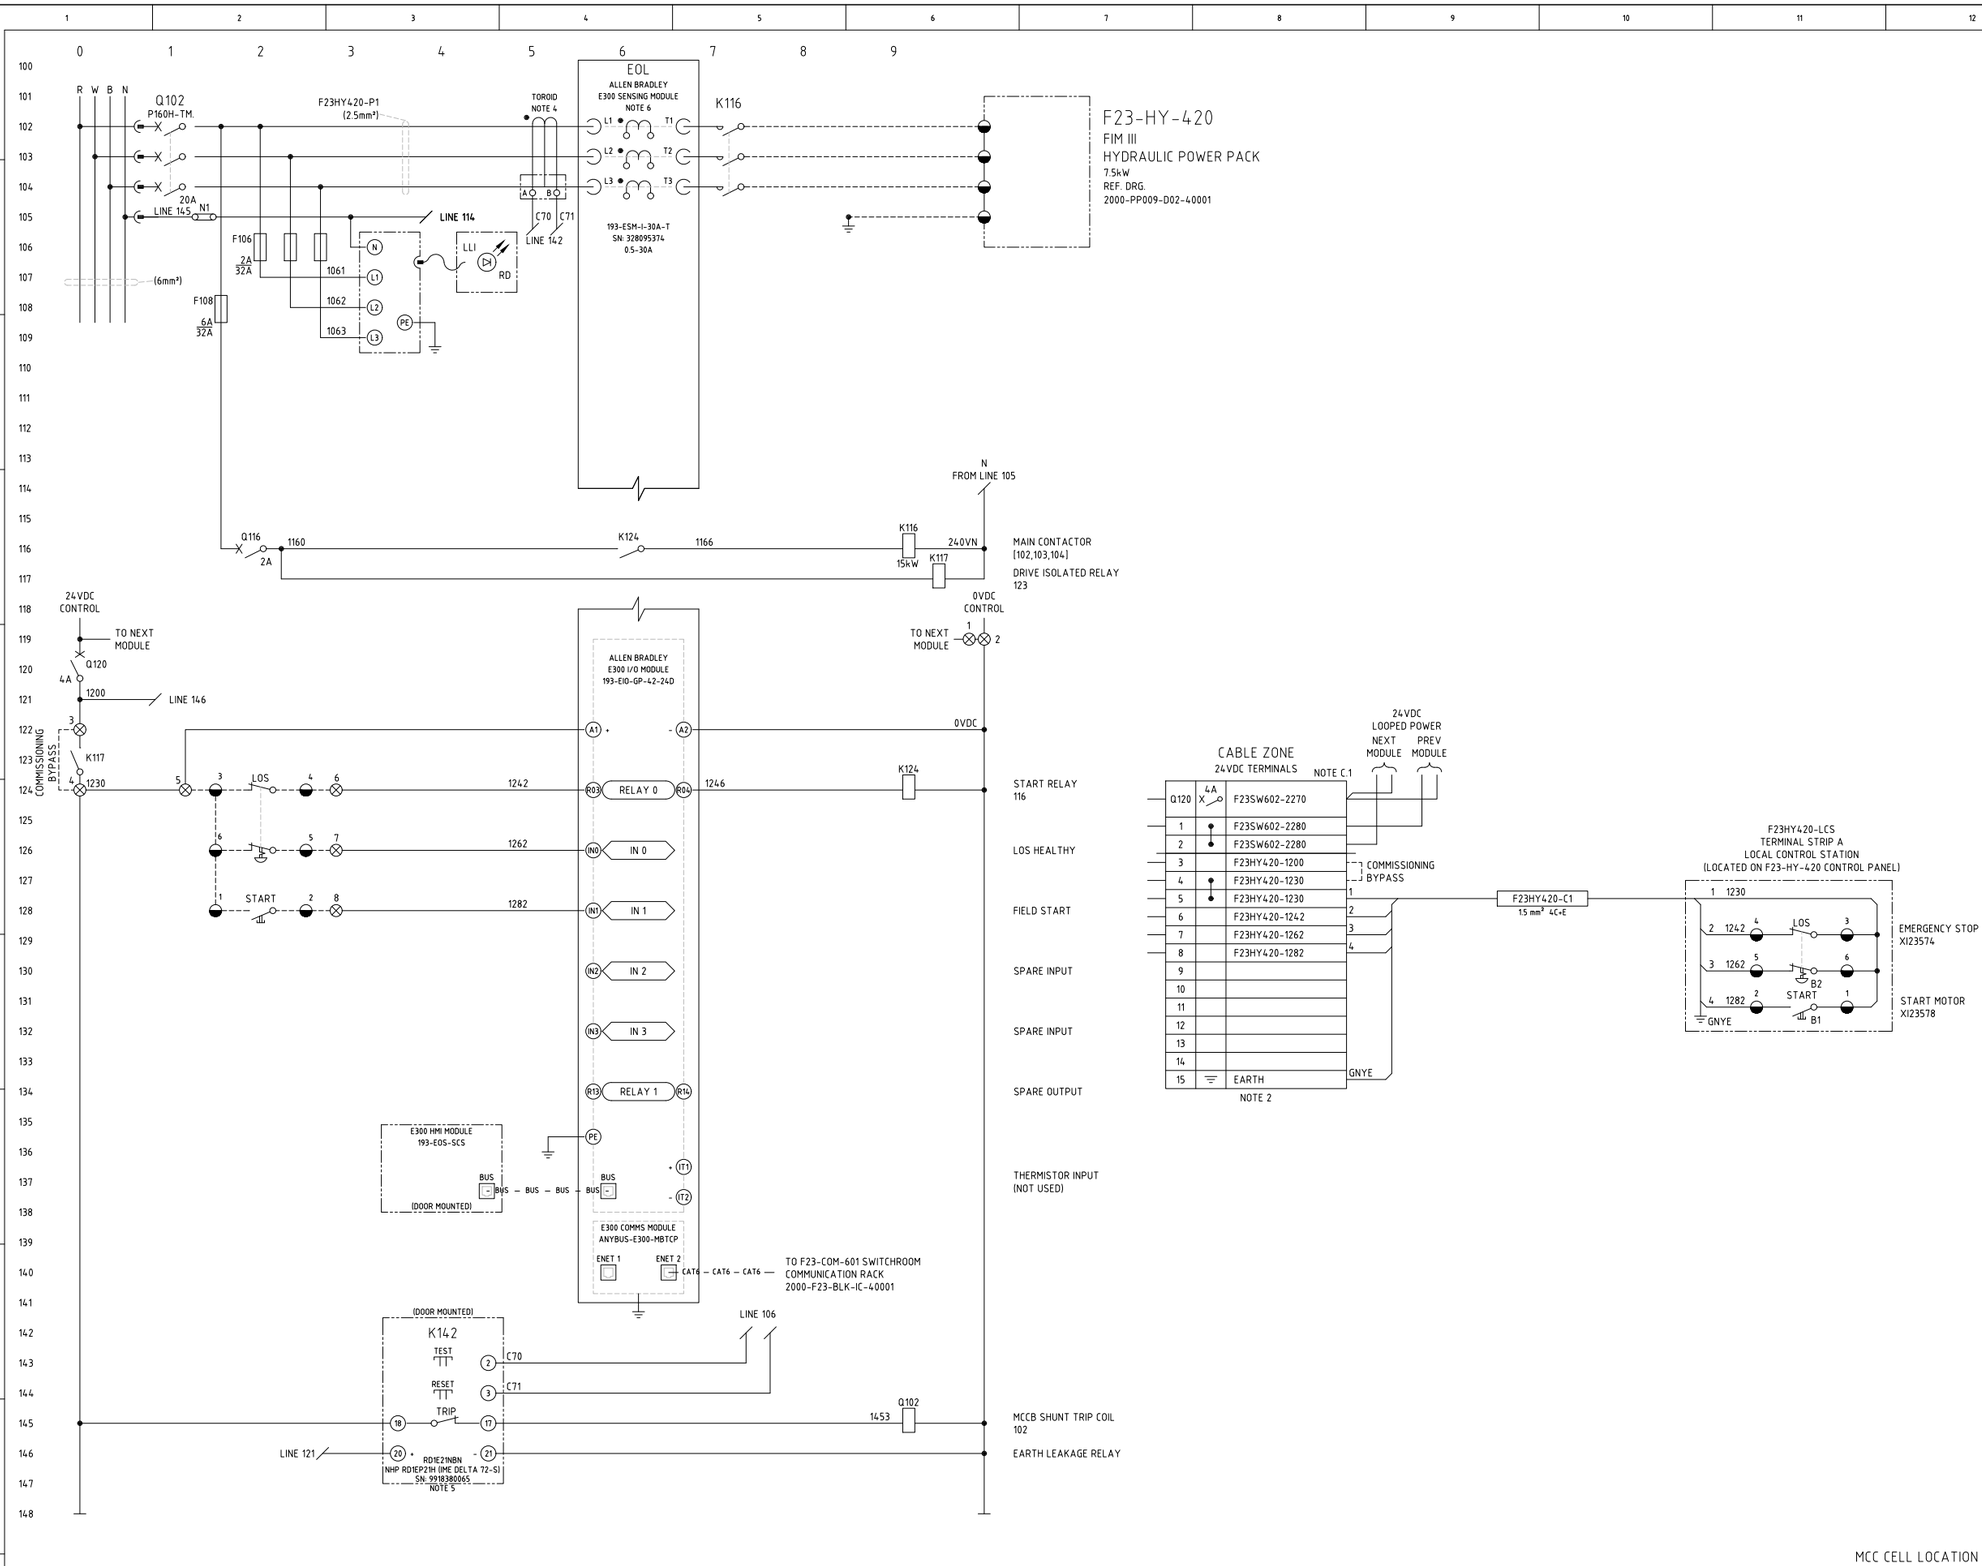


NOTES

1. TERMINALS ON TERMINAL STRIPS ABOVE 50VAC SHALL HAVE A SEPARATE PERSPEX SHROUD AND SHALL BE LABELLED "DANGER xxxVAC".
2. WIRE NUMBER FERRULES ON TERMINAL STRIP SHALL BE PREFIXED WITH EQUIPMENT NUMBER e.g. F23HY420-1200.
3. EACH WIRE SHALL BE IDENTIFIED AT BOTH ENDS WITH FERRULES.
4. NHP TDG×2 TOROID TO SUIT CABLE DIAMETER.
   TOROID DETAILS
   TOGB2
   SN: 0411850216
5. EARTH LEAKAGE RELAY USER INTERFACE TO BE MOUNTED ON MCC MODULE DOOR.
   RELAY SETTINGS SET TO:
   IΔn ="1A".
   DELAY = "100ms".
   RANGES = "x1".
   FAILSAFE MODE = "Ne".
   RESET = "MAN".
6. E300 SENSING MODULE FOR VOLTAGE/ CURRENT/ GROUND FAULT (VIG RANGE) TO SUIT MOTOR kW DUTY.
7. REFER TO CABLE SCHEDULE 2000-F23-LST-EL-40003.


LEGEND

- 00/01/00 — DCS DIGITAL INPUT
- 00/02/00 — DCS DIGITAL OUTPUT
- ⊗ — MCC TERMINAL
- ◓ — VSD TERMINAL
- ◒ — FIELD TERMINAL
- ◑ — DCS OR I/O TERMINAL
- ◧ — MARSHALLING TERMINAL
- (x) — DEVICE TERMINAL
- ⊗ cc — INDICATION LAMP, cc = COLOUR

DCS LEGEND

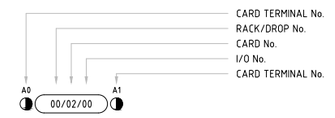

TERMINATION LEGEND

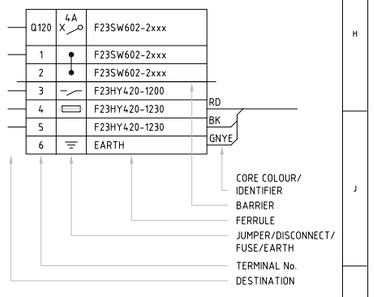

MCC CELL LOCATION 3F-13

AS BUILT

REFERENCES	DWG No	REV	DATE	REVISION	DRN	CHK	TECH APP	APP
		4	13.MAR.26	AS BUILT FOR FIM III TSF	[redacted]	[redacted]	MC	MBB
		3	10.DEC.25	RE-APPROVED FOR CONSTRUCTION	[redacted]	[redacted]	KV	
		2	07.JUL.25	RE-APPROVED FOR CONSTRUCTION	[redacted]	KVN	K[redacted]	
F23-SW-602 LV MOTOR CONTROL CENTRE SINGLE LINE DIAGRAM SHT 2 OF 2	2000-F23-SLD-EL-40012	1	17.MAR.25	RE-APPROVED FOR CONSTRUCTION	[redacted]	KVN	K[redacted]	
GENERAL NOTES AND STANDARD DRAWINGS INDEX	2000-F00-STD-EL-10001	0	17.JAN.25	APPROVED FOR CONSTRUCTION	[redacted]	[redacted]	K[redacted]	

NORTHERN STAR RESOURCES LIMITED

DRA PACIFIC (PTY) LIMITED

[redacted]	J.[redacted]	02.DEC.2024
CHECKED	[redacted]	19.DEC.2024
DESIGNED	[redacted]	20.NOV.2024
TECH APP	[redacted]	20[redacted].2024
[redacted]APP	T.[redacted]	17.JAN.2025
CLIENT APP		

PROJECT: KCGM
FIM TSF PROJECT

TITLE: FIM III BOOSTER STATION
F23-HY-420 FIM III HYDRAULIC POWER PACK
CONTROL SCHEMATIC DIAGRAM

[redacted] SCALE NTS DRG No. 2000-F23-SCM-EL-40025 REV 4