
Docusign Envelope ID: D3EAC8FF-146A-4610-AFF4-26203B4BB02C

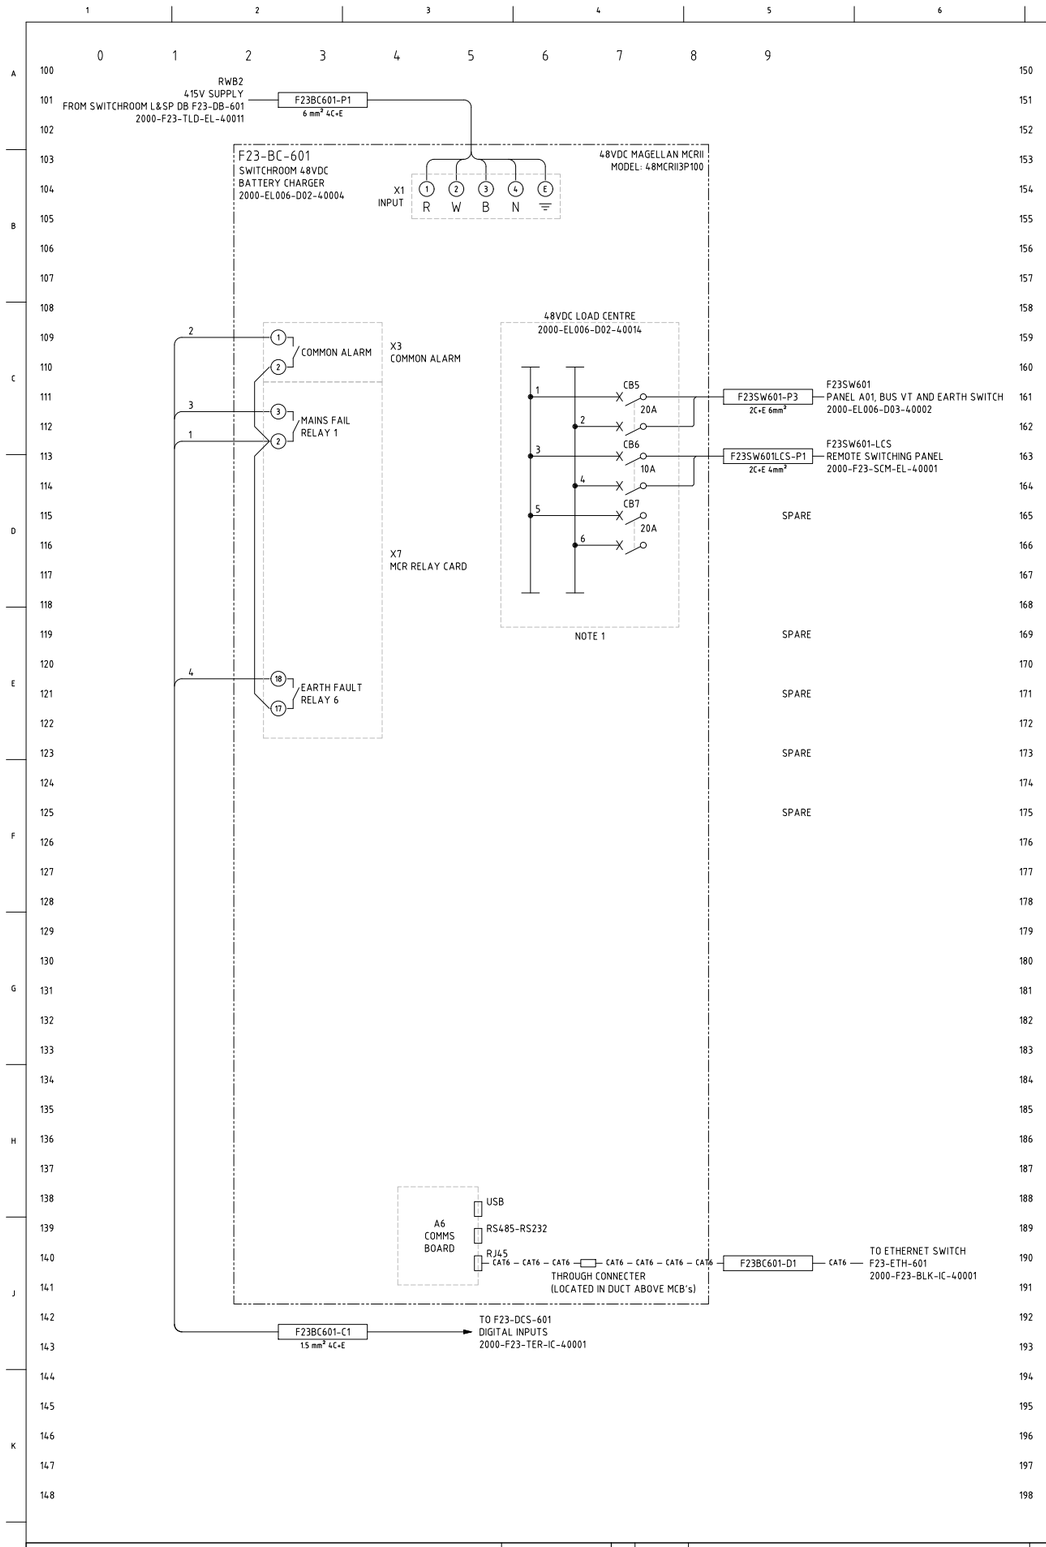

NOTES

1. ALL SPARE SPACE SHALL BE FILLED WITH DUMMY CIRCUIT BREAKERS, ESCUTCHEON POLE FILLERS SHALL NOT BE ACCEPTABLE.
2. EQUIPOTENTIAL BONDING CONDUCTOR SHALL BE INSTALLED FROM DB EARTH BAR TO SWITCHROOM EARTH BAR OR NEAREST EARTHED STRUCTURE VIA 35mm² Cu GNYE/PVC OR AS PER CABLE SCHEDULE.
3. AS-BUILT CIRCUIT SCHEDULE SHALL BE KEPT INTERNAL TO DISTRIBUTION BOARD AT ALL TIMES.
4. MINIMUM 20% SPARE CIRCUIT BREAKERS AND ADDITIONAL 20% SPARE SPACE SHALL BE PROVIDED FOR FUTURE LOADS.
5. REFER TO CABLE SCHEDULE 2000-F23-LST-EL-40003.

LEGEND

- MCC TERMINAL
- VSD TERMINAL
- FIELD TERMINAL
- PLC OR I/O TERMINAL
- MARSHALLING TERMINAL
- DISTRIBUTION BOARD TERMINAL
- DEVICE TERMINAL
- INDICATION LAMP (cc = COLOUR)
- DUMMY CIRCUIT BREAKER NOTE 1

AS BUILT

REFERENCES	DWG No	REV	DATE	REVISION	DRN	CHK	TECH APP	APP
		2	20.MAR.26	AS BUILT FOR FIM III TSF	MZ	EA		MB
F23-DB-601 HV/LV SWITCHROOM AND AREA L&SP DB THREE-LINE DIAGRAM	2000-F23-TLD-EL-40011	1	13.NOV.25	RE-ISSUED FOR CONSTRUCTION	ET			
GENERAL NOTES AND STANDARD DRAWING INDEX	2000-F00-SLD-EL-10001	0	17.JAN.25	ISSUED FOR CONSTRUCTION	TG			

NORTHERN STAR RESOURCES LIMITED

DRA PACIFIC (PTY) LIMITED
Level 8/256 Adelaide Terrace, Perth WA 6000
Tel: (08) 6163 5900
Level 4/145 Eagle Street, Brisbane Qld 4000
Tel: (07) 3236 4157

[redacted]	[redacted]	20.NOV.2024
CHECKED	[redacted]	19.DEC.2024
DESIGNED	[redacted]	20.NOV.2024
TECH APP	[redacted]	20.DEC.2024
[redacted]APP	[redacted]	17.JAN.2025
CLIENT APP		

PROJECT: KCGM
FIM TSF PROJECT

TITLE: FIM III BOOSTER STATION
F23-BC-601 HV/LV SWITCHROOM 48VDC BATTERY CHARGER
THREE-LINE DIAGRAM

[redacted] SCALE NTS | DRG No. 2000-F23-TLD-EL-40001 | REV 2