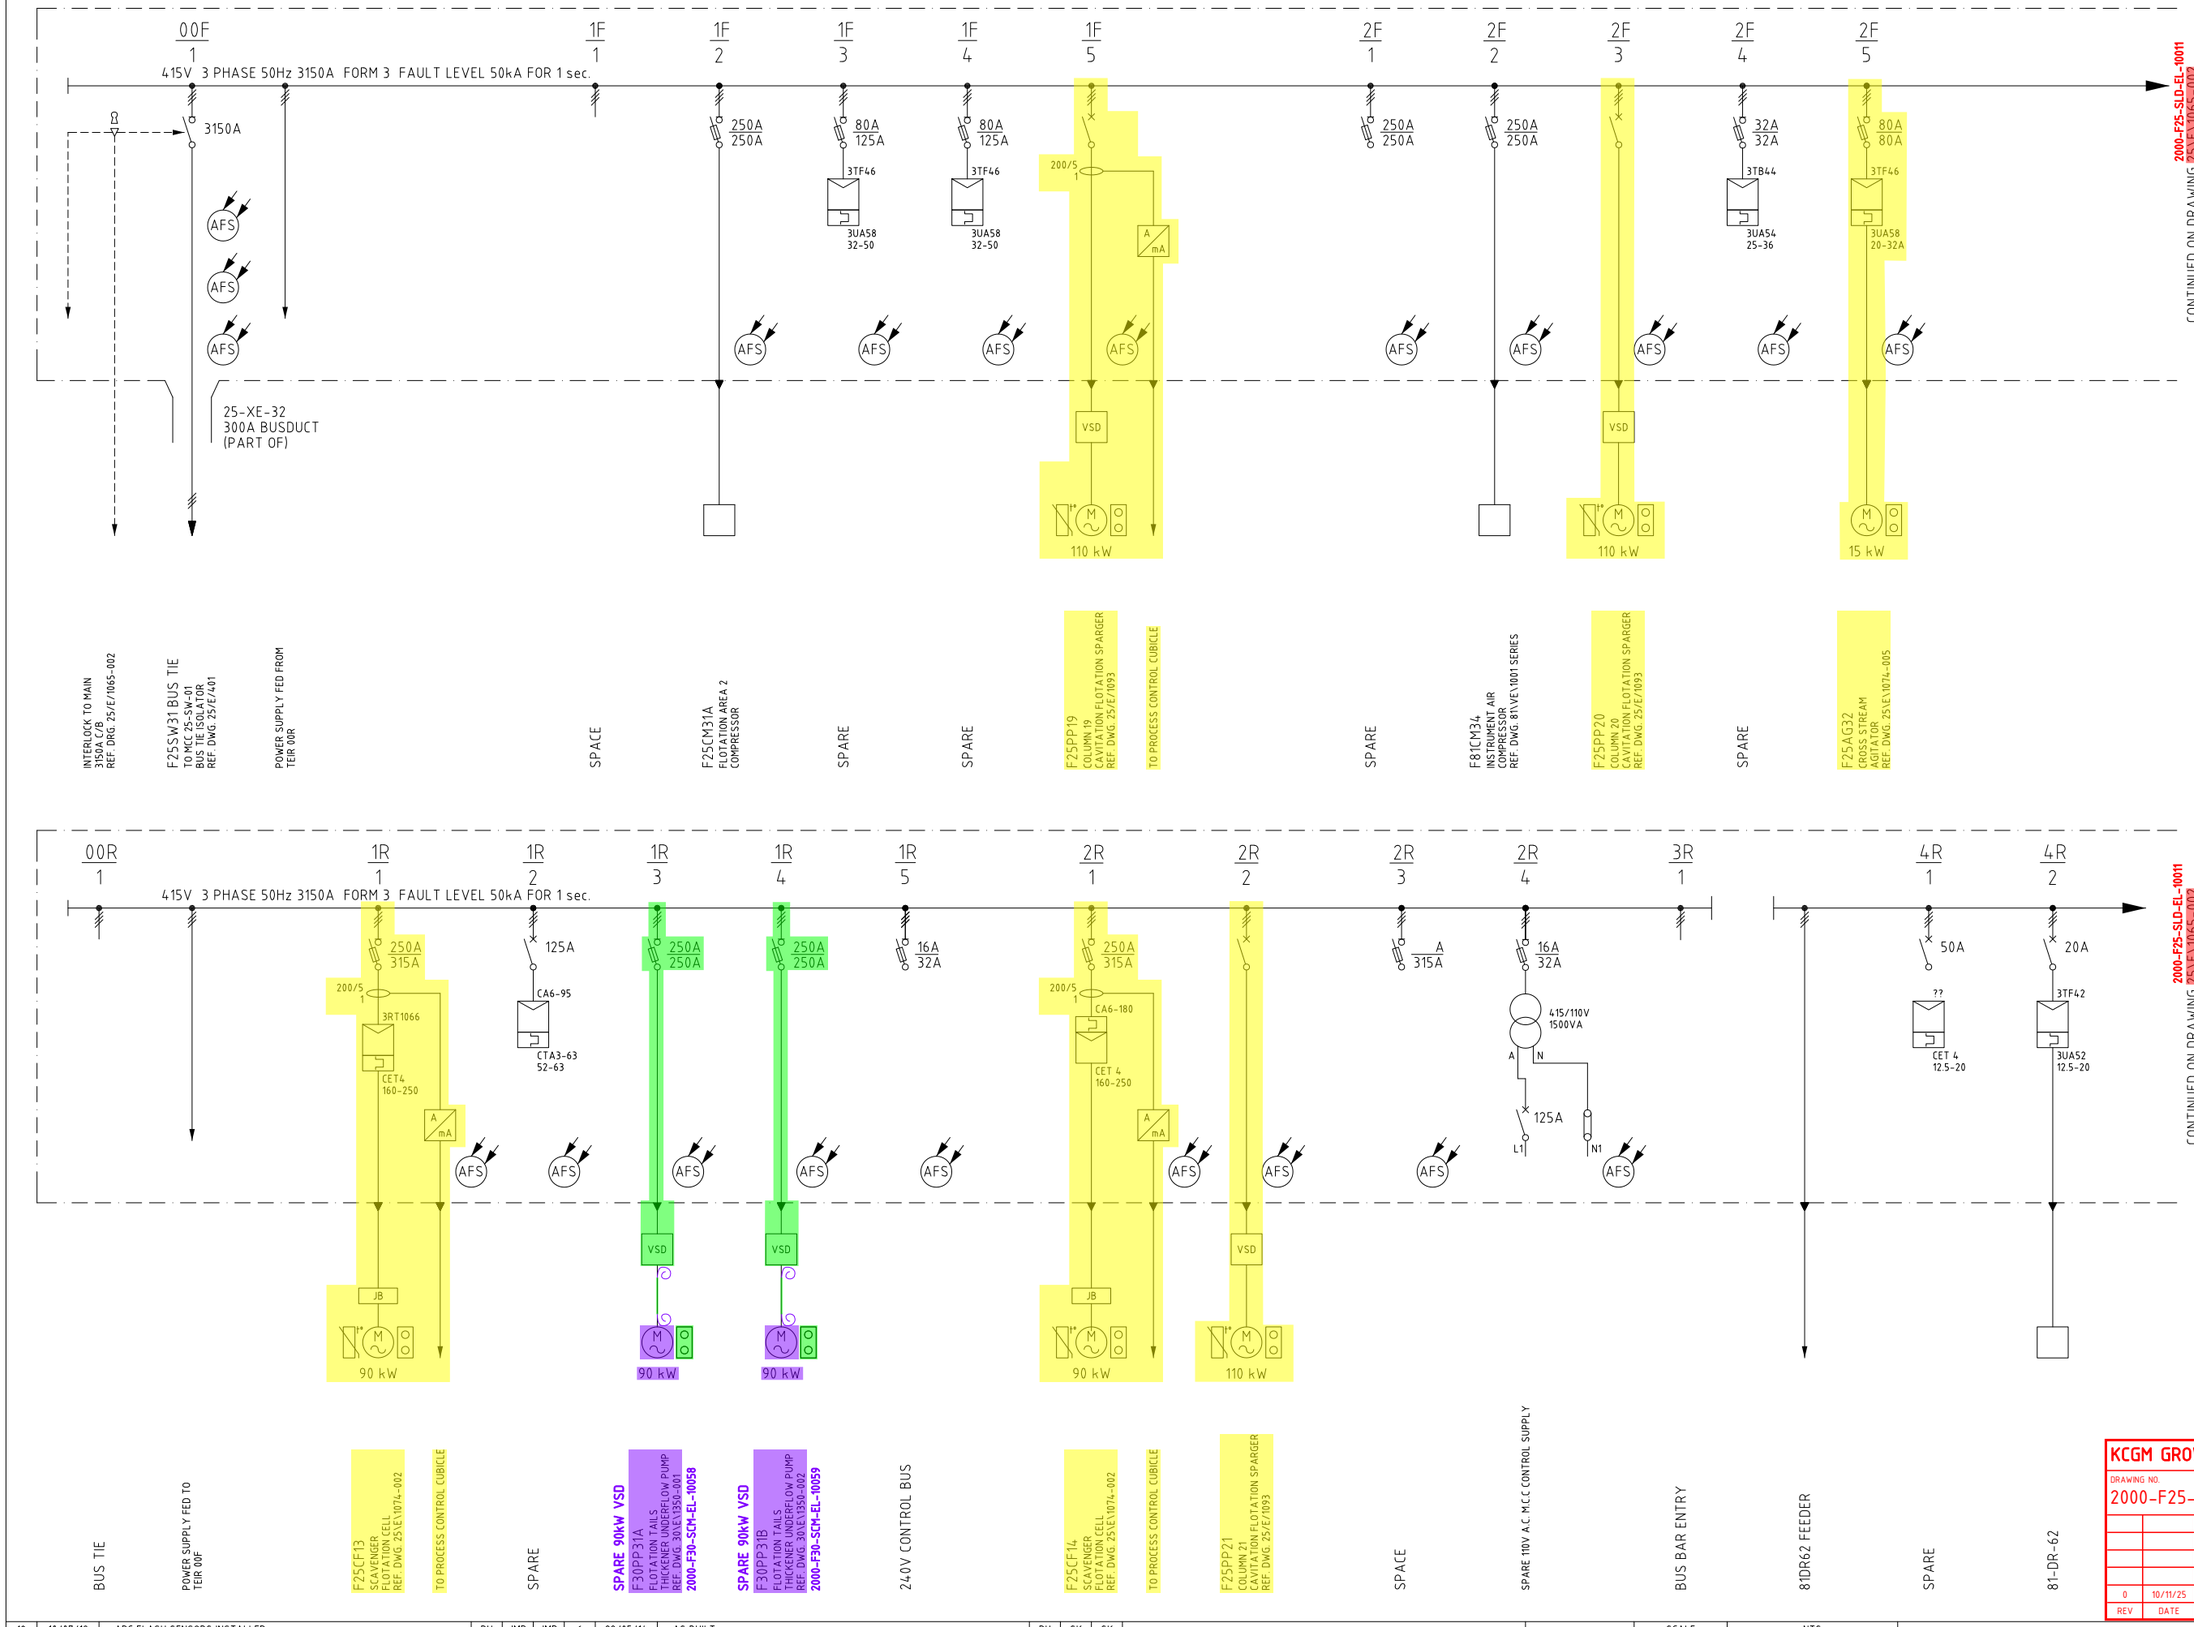


LEGEND

NORTHERN STAR RESOURCES LIMITED

Approved	X
Approved as Noted	
Not Approved	
For Information Only	


Signed: C Laird — Date: 20/11/2025

ACCEPTANCE DOES NOT RELIEVE THE SUPPLIER / CONTRACTOR OF ITS RESPONSIBILITY OR LIABILITIES UNDER THE PURCHASE ORDER / CONTRACT

LOCATION

SUB STATION 6

25-SW-31

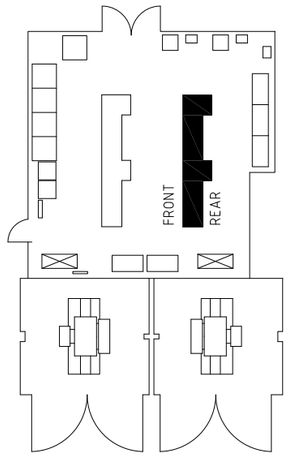

NOTES

1. ALL AFS (ARC FLASH SENSORS) ARE CONNECTED TO THE ARC FLASH RELAY VIA I/O UNITS

LEGEND

- EXISTING
- NON-EXISTENT
- STAGE 1 - NEW
- STAGE 1 - REMOVE
- STAGE 1 - DECOMMISSIONED (OTHERS)
- STAGE 2 - NEW
- STAGE 2 - REMOVE
- STAGE 2 - DECOMMISSIONED (OTHERS)

KCGM GROWTH PROJECT

DRAWING NO. 2000-F25-SLD-EL-10010

REV	DATE	DESCRIPTION	CHECK	TECH APP
0	10/11/25	APPROVED FOR CONSTRUCTION		DM

MK	DATE	REVISION	BY	CKD	APP
12	10/07/18	ARC FLASH SENSORS INSTALLED	RH	JMR	JMR
11	11/04/16	AS BUILT		SK	
10	02/09/15	AS BUILT		SK	
9	30/10/14	FLOTATION COLUMN 19,20 & 21 CAVITATION SPARGER PUMPS INFO UPDATED		SK	
8	21/10/14	25CM31B RELOCATED FROM 2F/1 TO 4F/3 DURING SHUTDOWN		SK	
7	08/07/14	FLOTATION COLUMN 19,20 & 21 CAVITATION SPARGER PUMPS INSTALLED		SK	
6	22/05/14	AS BUILT		SK	
5	27/09/12	GENERAL INFORMATION UPDATED		RH	
16	07/11/22	30PP31A & 31B DRAWING NUMBERS UPDATED		MB	
15	11/07/22	81CM34 REF. DWG. ADDED		JM	
14	08/10/19	2019 S.L.D. UPDATE PROJECT "AS BUILT"		RH	
13	08/08/19	2019 S.L.D. UPDATE PROJECT "AS BUILT"- FIELD REVIEW		RH	

REFERENCE DRAWINGS — DWG NO.

SCALE	NTS	
DRAWN		01/10/00
DESIGNED	KCGM	01/10/00
CHECKED	KCGM	01/10/00
APPROVED	KCGM	01/10/00
PROJ.APP	KCGM	01/10/00
PROJ. FILE #.		

FIMISTON PLANT
FLOTATION
SUBSTATION No.6 415V MCC 25SW31
SINGLE LINE DIAGRAM

SIZE	DRAWING NUMBER	REV
A1	25\E\1065-001	16

KALGOORLIE CONSOLIDATED GOLD MINES PTY. LTD. ABN 009 377 619 003