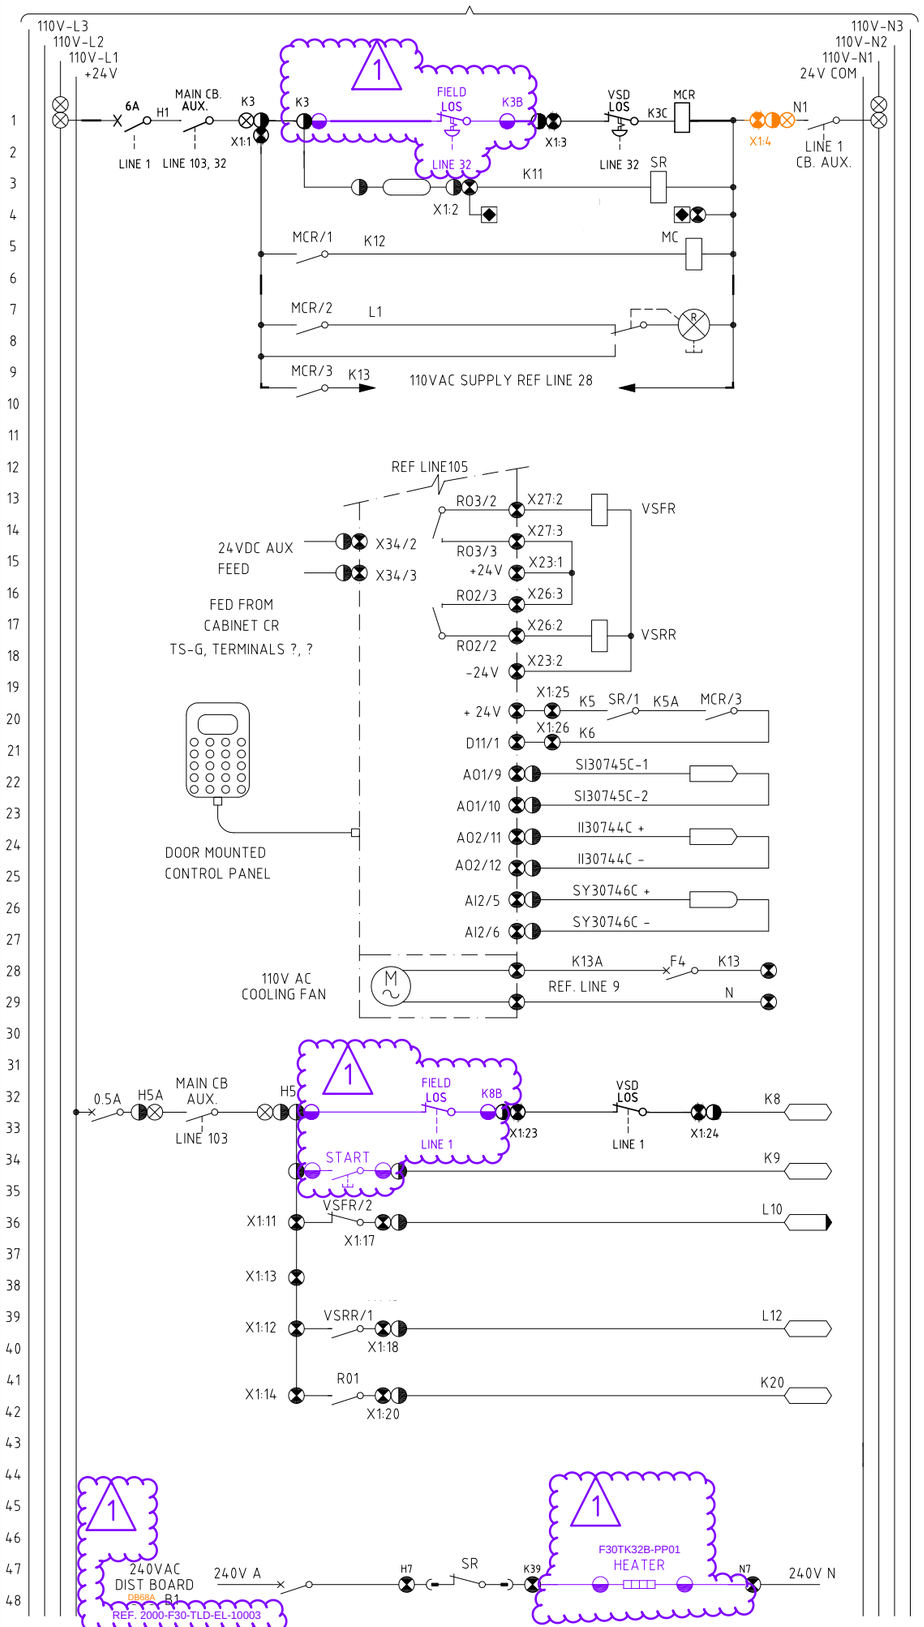


MAIN CONTACTOR RELAY

DCS START RELAY

MAIN CONTACTOR

VSD POWER AVAILABLE

VSD COOLING FAN SUPPLY

VSD FAULT RELAY

VSD RUN RELAY

START COMMAND

REMOTE SPEED INPUT

REMOTE CURRENT INPUT

REMOTE SPEED OUTPUT

STOP INPUT


FIELD START INPUT

FAULT INPUT

RUN INPUT

VSD READY

MOTOR HEATER

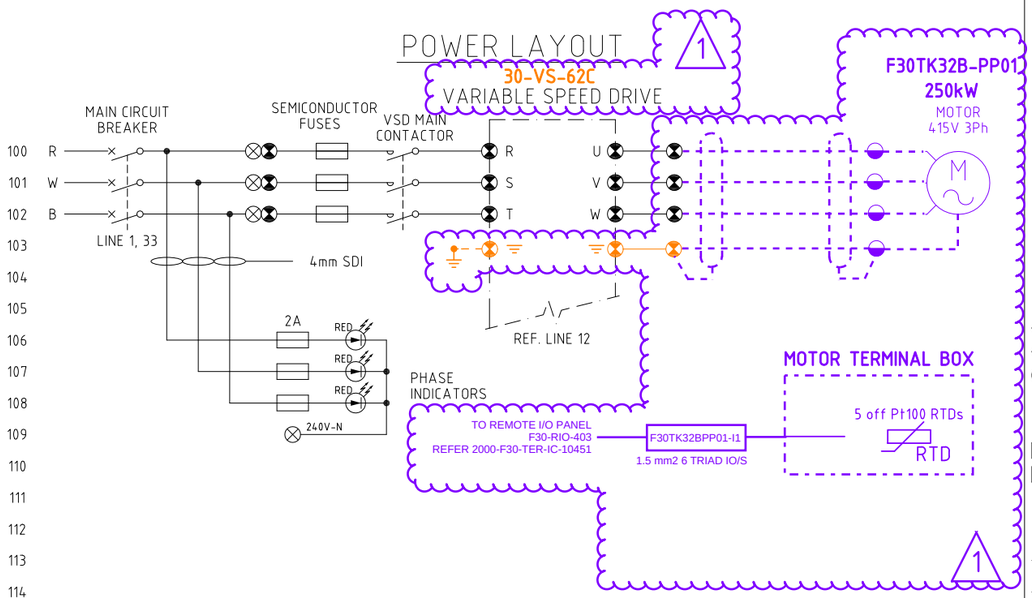

KCGM GROWTH PROJECT CONSTRUCTION NOTES

C.1. REFER PREVIOUS REVISION FOR DECOMMISSIONING DRAWING.

LEGEND

- EXISTING
- NON-EXISTENT
- STAGE 1 - NEW
- STAGE 1 - REMOVE
- STAGE 1 - DECOMMISSIONED (OTHERS)
- STAGE 2 - NEW
- STAGE 2 - REMOVE
- STAGE 2 - DECOMMISSIONED (OTHERS)

KCGM GROWTH PROJECT

DRAWING NO. 2000-F30-SCM-EL-10009

REV	DATE	DESCRIPTION	CHECK	TECH APP
1	08/08/25	DRIVE CHANGES ADDED	RF	MB/DM
0	08/08/25	APPROVED FOR CONSTRUCTION	RF	MB/DM

EQUIPMENT NUMBER	DESCRIPTION	MODULE NUMBER	FERRULE PREFIX	DCS START OUTPUT	DCS STOP INPUT	DCS START INPUT	DCS FAULT INPUT	[redacted]
F30TK32B-PP01	CIL2 OXYGEN INJECTION PUMP 2	05F/1	F30TK32B	%Y055315	%Y054408	%Y054409	%Y054410	%Y054411

EQUIPMENT NUMBER	DESCRIPTION	VSD READY INPUT	REMOTE SPEED SET OUTPUT	MOTOR CURRENT SIGNAL INPUT	DCS SPEED SIGNAL INPUT	24V C.B No.		
F30TK32B-PP01	CIL2 OXYGEN INJECTION PUMP 2	%Y054414	REF. LOOP DWG 2000-F30-SCM-IC-10451	REF. LOOP DWG 2000-F30-SCM-IC-10450	REF. LOOP DWG 2000-F30-SCM-IC-10452	A12		

LEGEND

TERMINALS

- MOTOR CONTROL CENTRE (MCC)
- FIELD
- PROCESS CONTROL CUBICLE
- LINE CONDITIONER
- SOFT STARTER TERMINAL
- VARIABLE SPEED DRIVE
- DISTRIBUTION BOARD
- HV MOTOR CONTROL CENTRE
- MISC. ELECTRICAL DEVICE REFER NOTES FOR SPECIFIC DESC.

DIGITAL FUNCTIONS

- DCS INPUT
- DCS INPUT WITH ALARM FUNCTION
- DCS OUTPUT

ANALOGUE FUNCTION

- 4-20mA INPUT
- 4-20mA OUTPUT

ANCILLARY EQUIPMENT

- CIRCUIT BREAKER
- COMBINATION FUSE SWITCH
- ISOLATOR
- PUSH BUTTON
- LOS (LOCK OFF STOP)
- PULL WIRE SWITCH
- NORMALLY CLOSED CONTACT
- LIMIT SWITCH
- CONTACTOR CONTACT
- NORMALLY OPEN CONTACT
- TIMER CONTACT
- FUNCTION CONTACT
  - P - PRESSURE
  - T° - TEMPERATURE
  - F - FLOW
  - L - FLOAT
- SIREN
- HORN
- RELAY
- LINK
- THERMISTOR
- INDICATION LAMP R - RED, G - GREEN, A - AMBER

VOLTAGES ON CONTROL BUS

- +24V - 24V DC DCS SUPPLY BUS
- 110V-L1 - 110V AC MCC CONTROL BUS
- 110V-L2 - 110V AC CONDITIONED BUS
- 110V-L3 - 110V AC NON CONDITIONED BUS
- 110V-L1E - 110V [redacted] EMERGENCY CONROL BUS
- 240V-L4 - 240V AC CONTROL BUS

NOTES

1. ALL WIRES EXCEPT CONTROL SUPPLIES & THOSE WITHIN FORM 4 MODULES SHALL BE FERRULED WITH PREFIX LISTED IN ABOVE TABLE.

MK	DATE	REVISION	BY	CKD	APP
1	7-12-05	AS BUILT 2005	[redacted]	DB	
0	10-11-05	ISSUED FOR CONSTRUCTION	BJ	DB	

REFERENCE DRAWINGS	DWG NO.
SUBSTATION 68 CONTROL PANEL 30CP62C FIELD TERMINATION SHEET 21	30-E-1051_021
SUBSTATION 68 DCS 30PC62 MARSHALLING TERMINATIONS	30-E-550 - 579
SUBSTATION 68 MCC 30SW61, 62, 63, 64 DRIVE PANEL LAYOUT	30-E-1040 - 1043
SUBSTATION 68 MCC AND GENERAL EQUIPMENT LAYOUT	30-E-1039

SCALE	NTS	
DRAWN	[redacted]	5-7-05
DESIGNED		5-7-05
CHECKED	[redacted]	5-7-05
APPROVED		
PROJ.APP		
PROJ. FILE #.		

FIMISTON PLANT
CARBON IN LEACH (C.I.L 3)
SUB STATION No.68 30-VS-62C VSD
CONTROL SCHEMATIC

SIZE	DRAWING NUMBER	REV
A1	30\E\0418	1

KALGOORLIE CONSOLIDATED GOLD MINES PTY. LTD. ACN 009 377 619