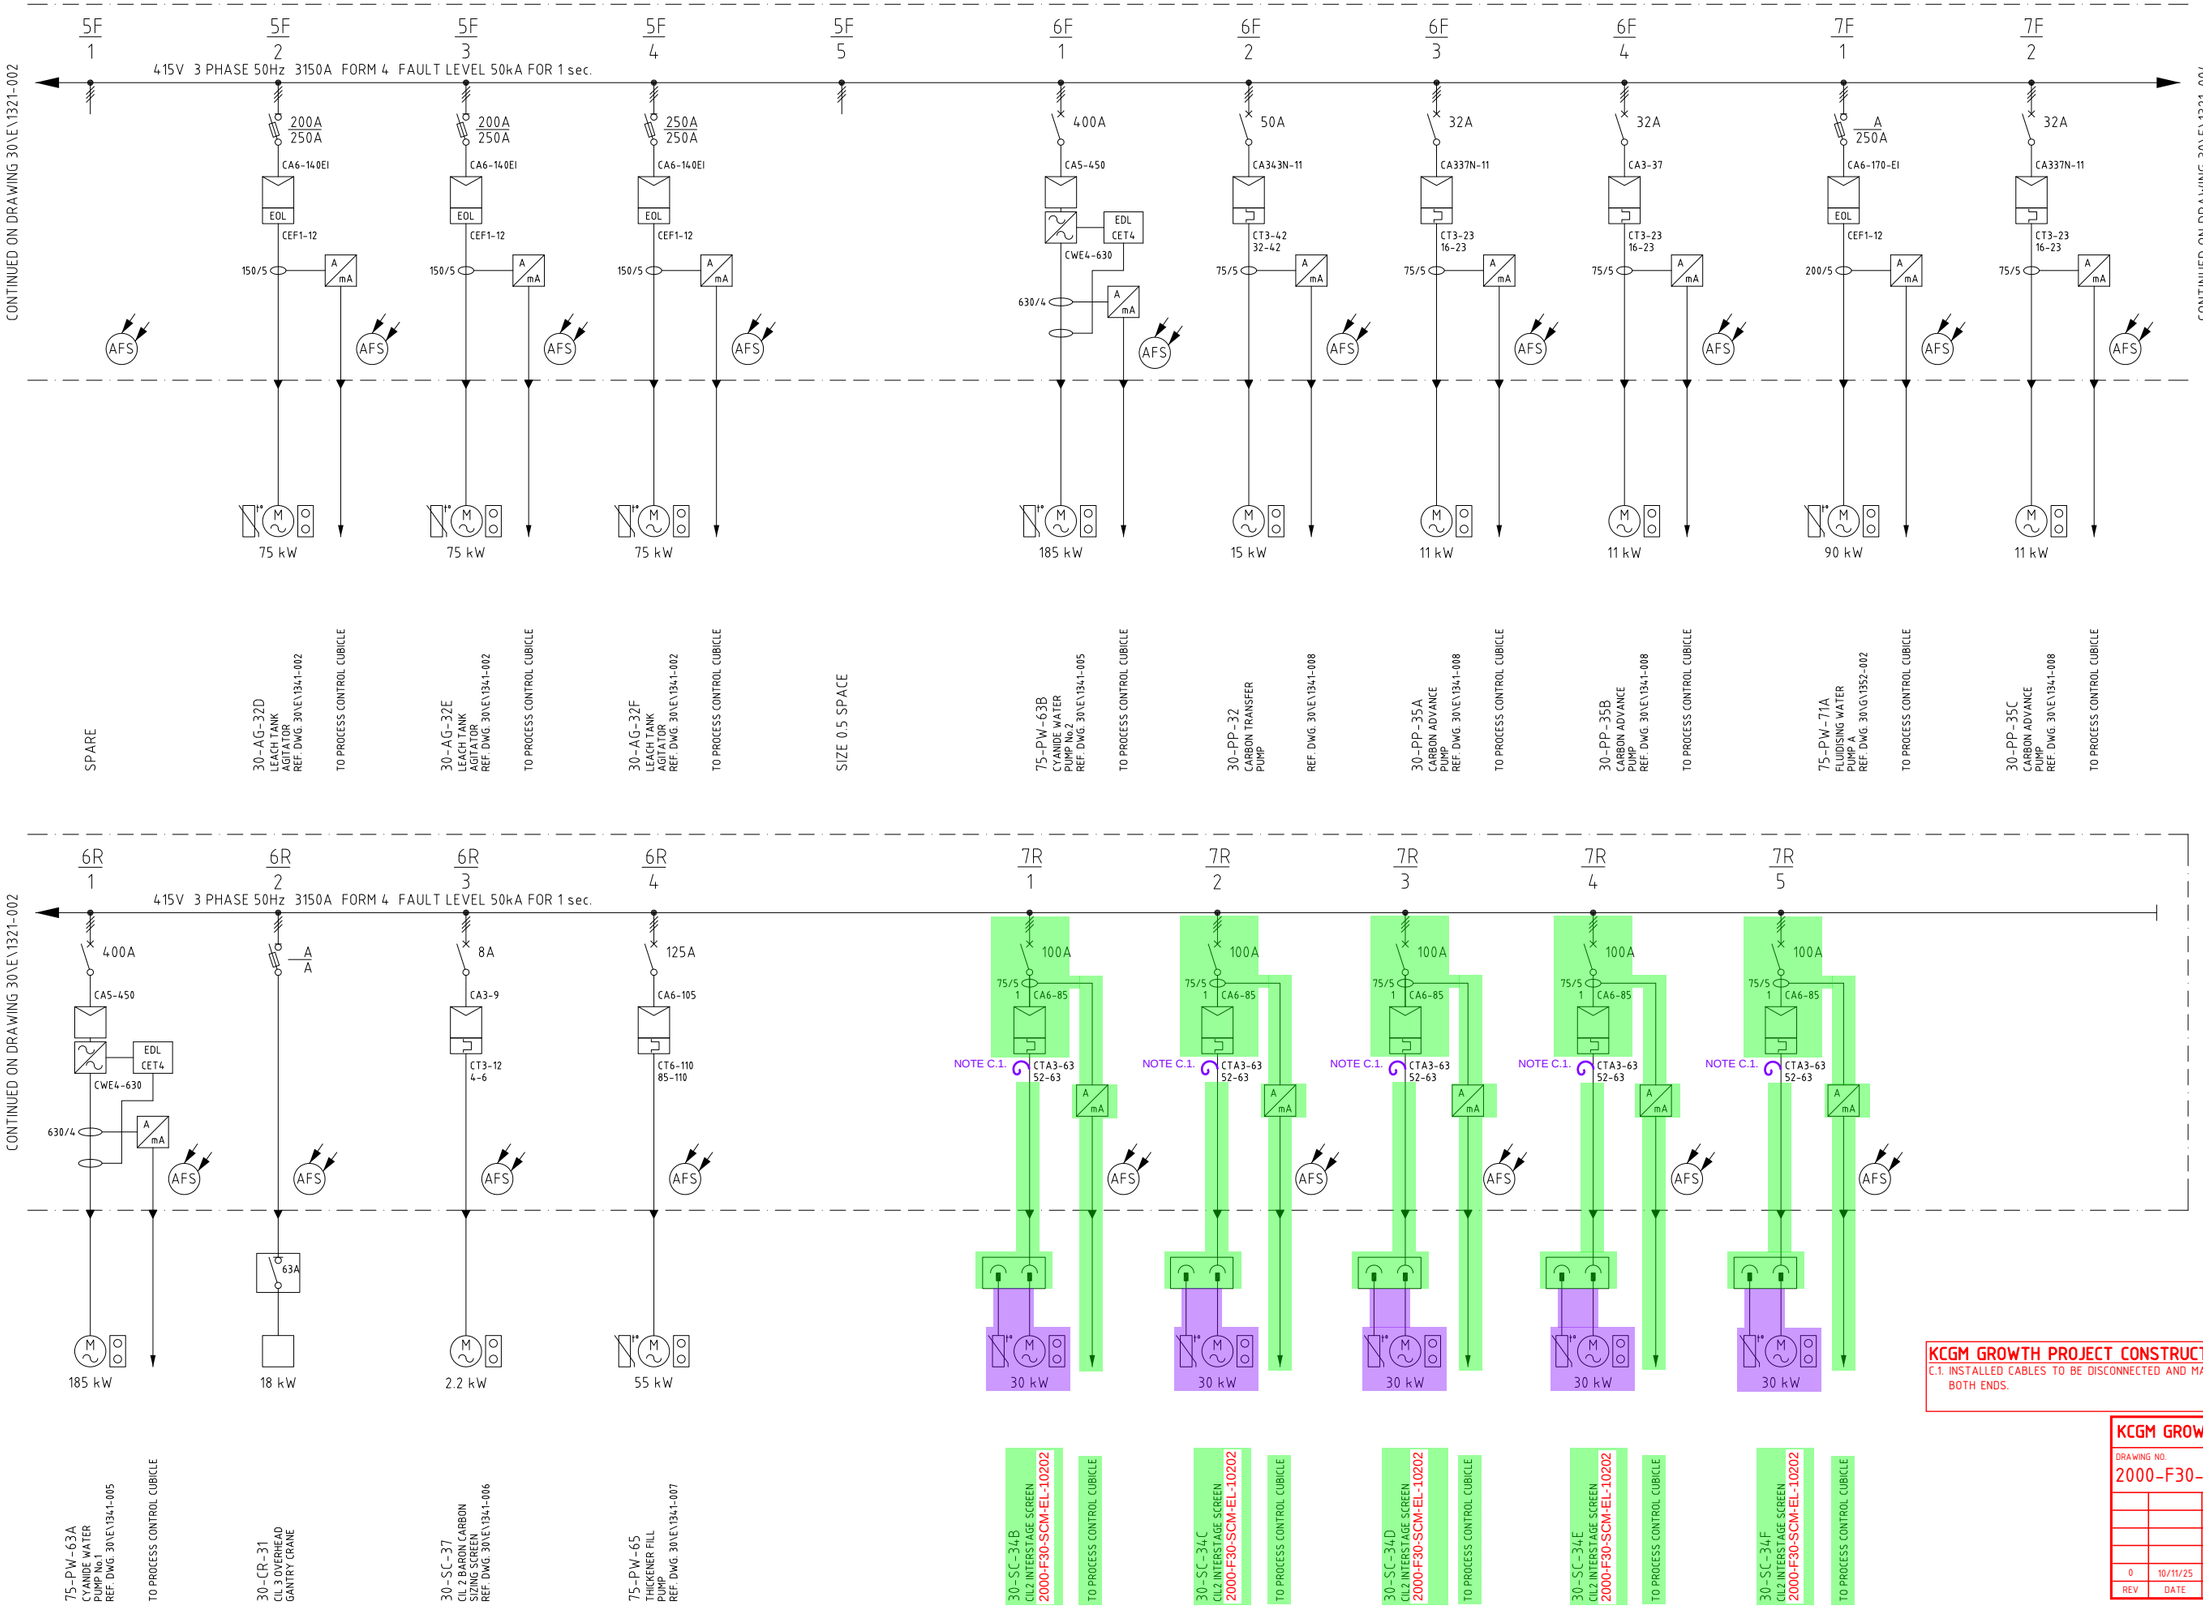



## LEGEND

NORTHERN STAR RESOURCES LIMITED


| | |
|---|---|
| Approved | X |
| Approved as Noted | |
| Not Approved | |
| For Information Only | |

Signed: C Laird — Date: 20/11/2025

ACCEPTANCE DOES NOT RELIEVE THE SUPPLIER / CONTRACTOR OF ITS RESPONSIBILITY OR LIABILITIES UNDER THE PURCHASE ORDER / CONTRACT

## LOCATION

SUB STATION 38
30-SW-31

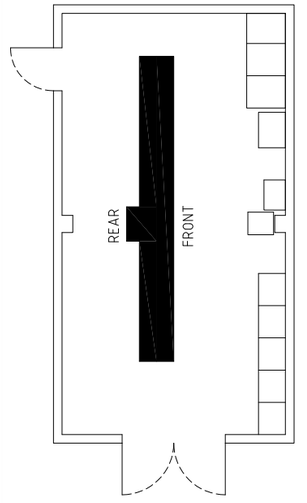


## NOTES

1. WHERE DRIVES & FEEDERS REQUIRE 2 OFF CIRCUIT BREAKER AUXILLARIES THEN AN ADDITIONAL POLE SPACE IS REQUIRED.
   No. OF POLES USED SHOWN IN BRACKETS.
2. FUSES TO BE RATED FOR TYPE 2 SHORT CIRCUIT CO-ORDINATION.
3. ALL AFS (ARC FLASH SENSORS) ARE CONNECTED TO THE ARC FLASH RELAY VIA I/O UNITS

**KCGM GROWTH PROJECT CONSTRUCTION NOTES**

C.1. INSTALLED CABLES TO BE DISCONNECTED AND MADE SAFE AT BOTH ENDS.

LEGEND

- EXISTING
- NON-EXISTENT
- STAGE 1 - NEW
- STAGE 1 - REMOVE
- STAGE 1 - DECOMMISSIONED (OTHERS)
- STAGE 2 - NEW
- STAGE 2 - REMOVE
- STAGE 2 - DECOMMISSIONED (OTHERS)

**KCGM GROWTH PROJECT**

DRAWING NO.
2000-F30-SLD-EL-10201

| REV | DATE | DESCRIPTION | CHECK | TECH APP |
|---|---|---|---|---|
| 0 | 10/11/25 | APPROVED FOR CONSTRUCTION | | DM |

SUPERSEDES 30\E\1036-003

| MK | DATE | REVISION | BY | CKD | APP |
|---|---|---|---|---|---|
| 7A | 22/08/19 | 2019 S.L.D. UPDATE PROJECT "AS BUILT"- FIELD REVIEW | [redacted] | RH | [redacted] |
| 6 | 24/07/18 | ARC FLASH SENSORS INSTALLED | RH | JMR | JMR |
| 5 | 29/12/04 | 75-PW-72A DETAILS ADDED | [redacted] | | |
| 4 | 07/04/04 | GRAVITY CCT PROJECT - ISSUED FOR CONSTRUCTION | [redacted] | DBG | [redacted] |
| 3 | 17/03/04 | GRAVITY CCT PROJECT - ISSUED FOR MCC CONSTRUCTION | [redacted] | DBG | |
| 2 | 03/03/04 | ISSUED FOR TENDER | [redacted] | MGM | [redacted] |
| 1 | 01/09/01 | ASBUILD MODIFICATIONS ADDED | [redacted] | AB | |

REFERENCE DRAWINGS

DWG NO.

| | | |
|---|---|---|
| SCALE | NTS | |
| DRAWN | [redacted] | 01/09/01 |
| DESIGNED | KCGM | 01/09/01 |
| CHECKED | KCGM | 01/09/01 |
| APPROVED | KCGM | 01/09/01 |
| PROJ.APP | KCGM | 01/09/01 |
| PROJ. FILE #. | | |

FIMISTON PLANT
LEACH ADSORPTION & THICKENING
SUBSTATION No. 38 MCC 30-SW-31
SINGLE LINE DIAGRAM

| SIZE | DRAWING NUMBER | REV |
|---|---|---|
| A1 | 30\E\1321-003 | 7A |

KALGOORLIE CONSOLIDATED GOLD MINES PTY. LTD. ABN 009 377 619 003