




Docusign Envelope ID: D3EAC8FF-146A-4610-AFF4-26203B4BB02C

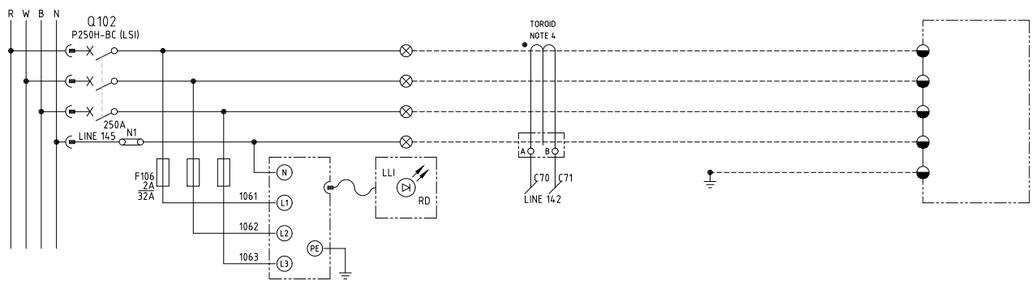

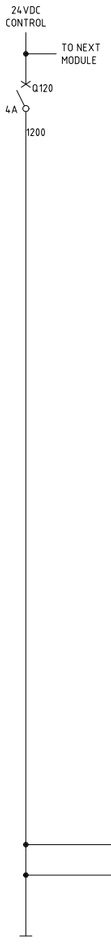

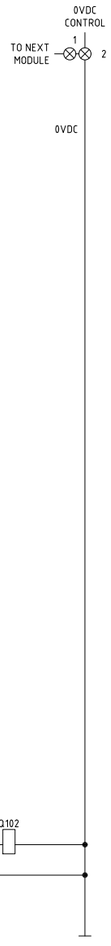

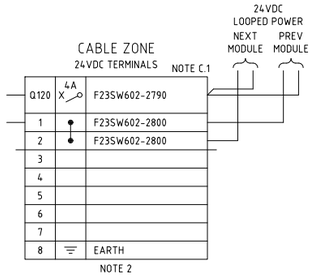

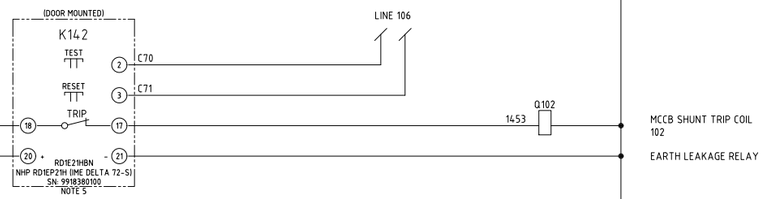

NOTES

1. TERMINALS ON TERMINAL STRIPS ABOVE 50VAC SHALL HAVE A SEPARATE PERSPEX SHROUD AND SHALL BE LABELLED "DANGER xxxVAC".
2. WIRE NUMBER FERRULES ON TERMINAL STRIP SHALL BE PREFIXED WITH EQUIPMENT NUMBER e.g. F75PW556-1200.
3. EACH WIRE SHALL BE IDENTIFIED AT BOTH ENDS WITH FERRULES.
4. NHP TDG×2 TOROID TO SUIT CABLE DIAMETER.
   TOROID DETAILS
   TDGC2
   SN: 0275450292
   IN: 170A
5. EARTH LEAKAGE RELAY USER INTERFACE TO BE MOUNTED ON MCC MODULE DOOR.
   RELAY SETTINGS SET TO:
   IΔn ="1A".
   DELAY = "100ms".
   RANGES = "x1".
   FAILSAFE MODE = "Ne".
   RESET = "MAN".


LEGEND

- 00/01/00 — DCS DIGITAL INPUT
- 00/02/00 — DCS DIGITAL OUTPUT
- MCC TERMINAL
- VSD TERMINAL
- FIELD TERMINAL
- DCS OR I/O TERMINAL
- MARSHALLING TERMINAL
- DEVICE TERMINAL
- INDICATION LAMP (cc = COLOUR)

DCS LEGEND



TERMINATION LEGEND

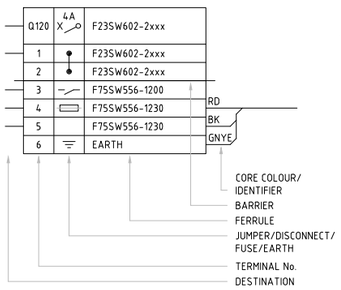

MCC CELL LOCATION 4R-21

AS BUILT

REV	DATE	REVISION	DRN	CHK	TECH APP	APP
2	20.MAR.26	AS BUILT FOR FIM III TSF	MZ	[redacted]	MC	[redacted]
1	13.JUN.25	RE-APPROVED FOR CONSTRUCTION – SWITCHBOARD NUMBER CHANGE	TG		KVN	
0	10.APR.25	APPROVED FOR CONSTRUCTION	TG		K[redacted]	

REFERENCES	DWG No
F23-SW-602 LV MOTOR CONTROL CENTRE SINGLE LINE DIAGRAM SHT 2 OF 2	2000-F23-SLD-EL-40012
GENERAL NOTES AND STANDARD DRAWINGS INDEX	2000-F00-STD-EL-10001

NORTHERN STAR RESOURCES LIMITED

DRA PACIFIC (PTY) LIMITED

[redacted]	P. MCPHERSON	24.MAR.2025
CHECKED	J.Y. [redacted]	10.APR.2025
DESIGNED	J.Y. WEE	10.APR.2025
TECH APP	[redacted]	10.APR.2025
[redacted]APP	[redacted]	10.APR.2025
CLIENT APP		

PROJECT: KCGM
FIM TSF PROJECT

TITLE: FIM III BOOSTER STATION
F75-SW-557 FIM III TSF SWITCHBOARD 2
CONTROL SCHEMATIC DIAGRAM

[redacted] SCALE NTS | DRG No. 2000-F75-SCM-EL-40006 | REV 2