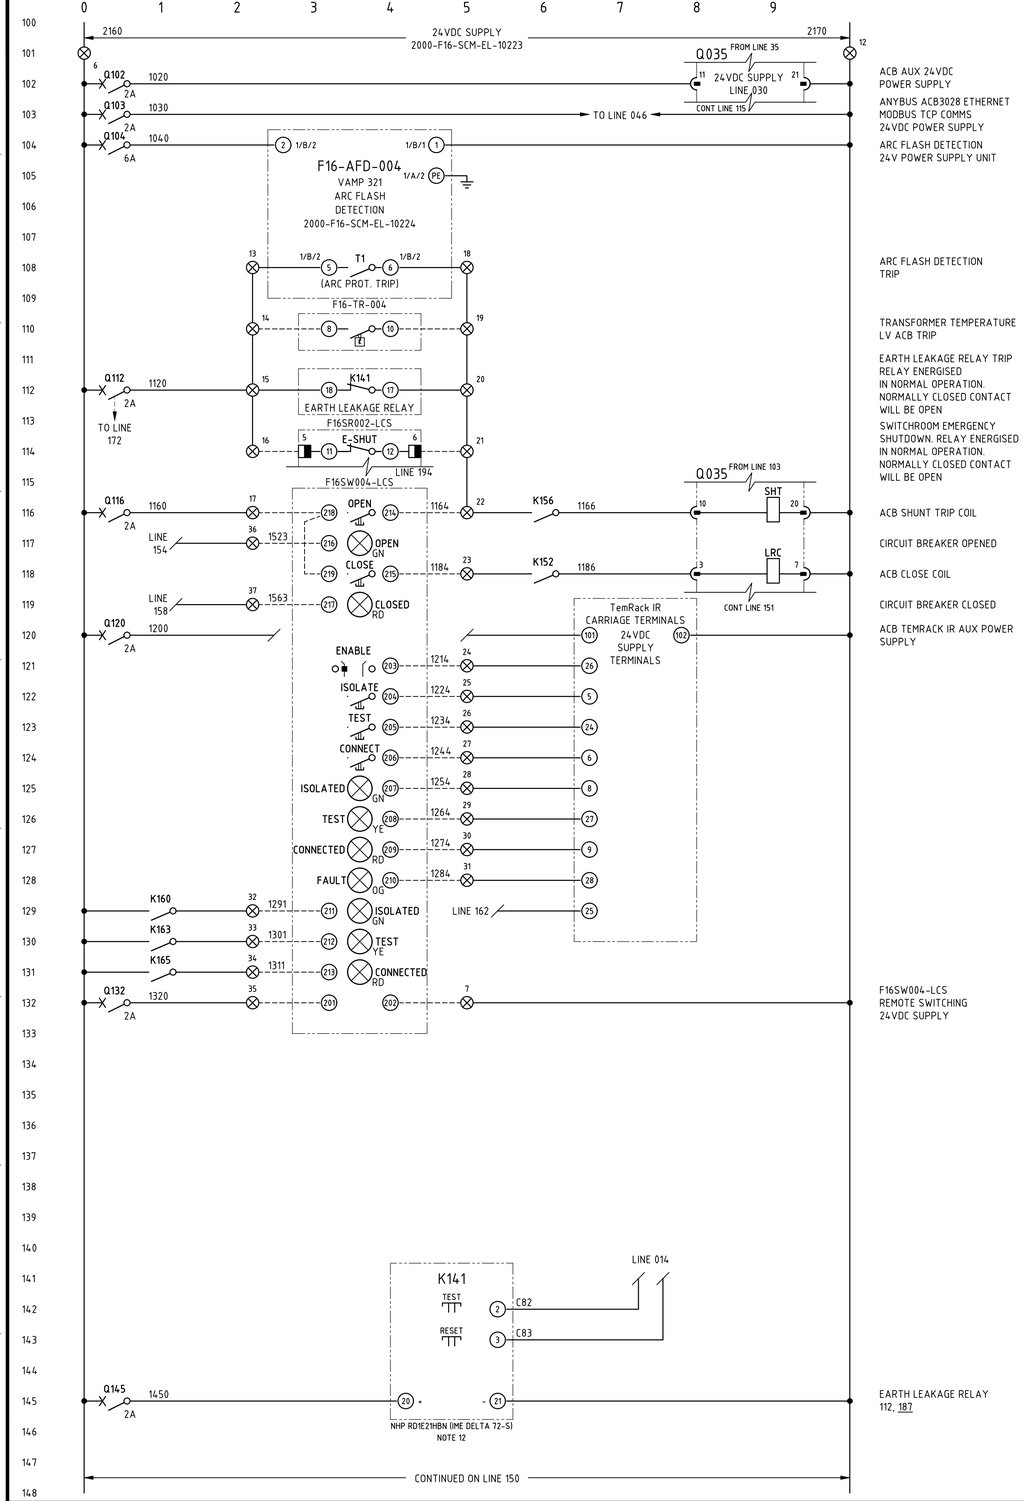


ACB AUX 24VDC POWER SUPPLY

ANYBUS ACB3028 ETHERNET MODBUS TCP COMMS 24VDC POWER SUPPLY

ARC FLASH DETECTION 24V POWER SUPPLY UNIT

ARC FLASH DETECTION TRIP

TRANSFORMER TEMPERATURE LV ACB TRIP

EARTH LEAKAGE RELAY TRIP RELAY ENERGISED IN NORMAL OPERATION. NORMALLY CLOSED CONTACT WILL BE OPEN

SWITCHROOM EMERGENCY SHUTDOWN. RELAY ENERGISED IN NORMAL OPERATION. NORMALLY CLOSED CONTACT WILL BE OPEN

ACB SHUNT TRIP COIL

CIRCUIT BREAKER OPENED


ACB CLOSE COIL

CIRCUIT BREAKER CLOSED

ACB TEMRACK IR AUX POWER SUPPLY

F16SW004-LCS REMOTE SWITCHING 24VDC SUPPLY

EARTH LEAKAGE RELAY 112, 187

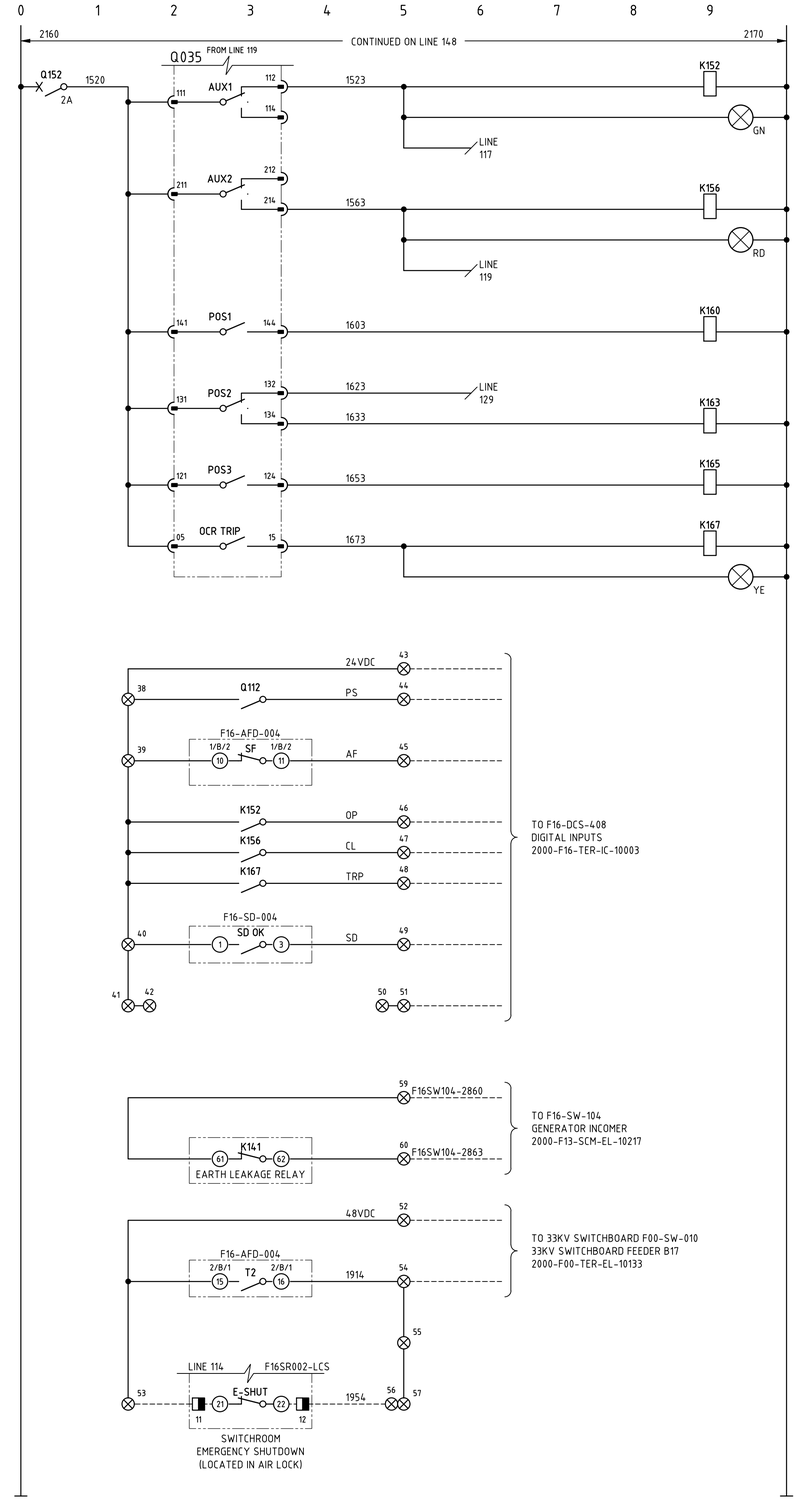

CIRCUIT BREAKER OPENED RELAY 118, 176

CIRCUIT BREAKER OPENED INDICATION

CIRCUIT BREAKER CLOSED RELAY 116, 177

CIRCUIT BREAKER CLOSED INDICATION

ACB ISOLATED POSITION 129

ACB TEST POSITION 130

ACB CONNECTED POSITION 131

ACB TRIPPED RELAY 178

CIRCUIT BREAKER TRIPPED

DCS 24VDC SUPPLY

ACB SHUNT TRIP 24VDC OK DCS INPUT

ARC FLASH DETECTION SYSTEM ALARM DCS INPUT

CIRCUIT BREAKER OPENED DCS INPUT

CIRCUIT BREAKER CLOSED DCS INPUT

CIRCUIT BREAKER TRIPPED DCS INPUT

INCOMER SURGE DIVERTER OK DCS INPUT

SPARE

GENERATOR INCOMER ELR SHUNT TRIP. RELAY ENERGISED IN NORMAL OPERATION. NORMALLY CLOSED CONTACT WILL BE OPEN

48VDC FROM HV SWITCHBOARD

ARC FLASH DETECTION HV FEEDER TRIP

SWITCHROOM EMERGENCY SHUTDOWN HV FEEDER TRIP. RELAY ENERGISED IN NORMAL OPERATION. NORMALLY CLOSED CONTACT WILL BE OPEN

NOTES

1. REFER TO INCOMER SCHEMATIC DIAGRAM SHEET 1 FOR NOTES.

LEGEND

- 00/01/00 — DCS DIGITAL INPUT
- 00/02/00 — DCS DIGITAL OUTPUT
- MCC TERMINAL
- VSD TERMINAL
- FIELD TERMINAL
- DCS OR I/O TERMINAL
- MARSHALLING TERMINAL
- DEVICE TERMINAL
- INDICATION LAMP (cc = COLOUR)

REFERENCES		REV	DATE	DESCRIPTION	DRAW	CHECK	DESIGN	TECH APP	PROJ APP
		3	07SEP26	KCGM GROWTH PROJECT - SP1 AS-BUILT					
		2	26AUG25	FAT REDLINES INCORPORATED					
2000-F16-SLD-EL-10201	F16-SW-004 415V MCC SINGLE LINE DIAGRAM SHEET 1	1	10JUN25	GENERATOR INCOMER ELR SHUNT TRIP ADDED, FAT REDLINES ADDED					
2000-F00-STD-EL-10001	GENERAL NOTES AND STANDARD DRAWINGS INDEX	0	12AUG24	APPROVED FOR CONSTRUCTION					

NORTHERN STAR RESOURCES LIMITED

PRIMERO
primero.com.au | DESIGN | CONSTRUCT | OPERATE

PRIMERO PROJECT NUMBER: 23517

INFORMATION AND REPRESENTATIONS ON THIS DRAWING ARE THE INTELLECTUAL PROPERTY OF PRIMERO UNLESS SPECIFICALLY IDENTIFIED OTHERWISE. ALL RIGHTS INCLUDING USE RESERVED

PROJECT: NORTHERN STAR RESOURCES LTD
KCGM GROWTH PROJECT

TITLE: ROUGHER & SCAVENGER FLOTATION - F16-SW-004
F16-SW-004 INCOMER
SCHEMATIC DIAGRAM SHEET 2

SHEET	SCALE	DRG No.	REVISION
A1	NONE	2000-F16-SCM-EL-10222	3

O:\CAD PROJECTS\235 NORTHERN STAR RESOURCES LTD\23517 KCGM GROWTH PROJECT\03 DELIVERABLES\ELV\F16 - ROUGHER & SCAVENGER FLOTATION\2000-F16-SCM-EL-10222.DWG 04SEP26 3:48PM GRENVILLE.DEASY