
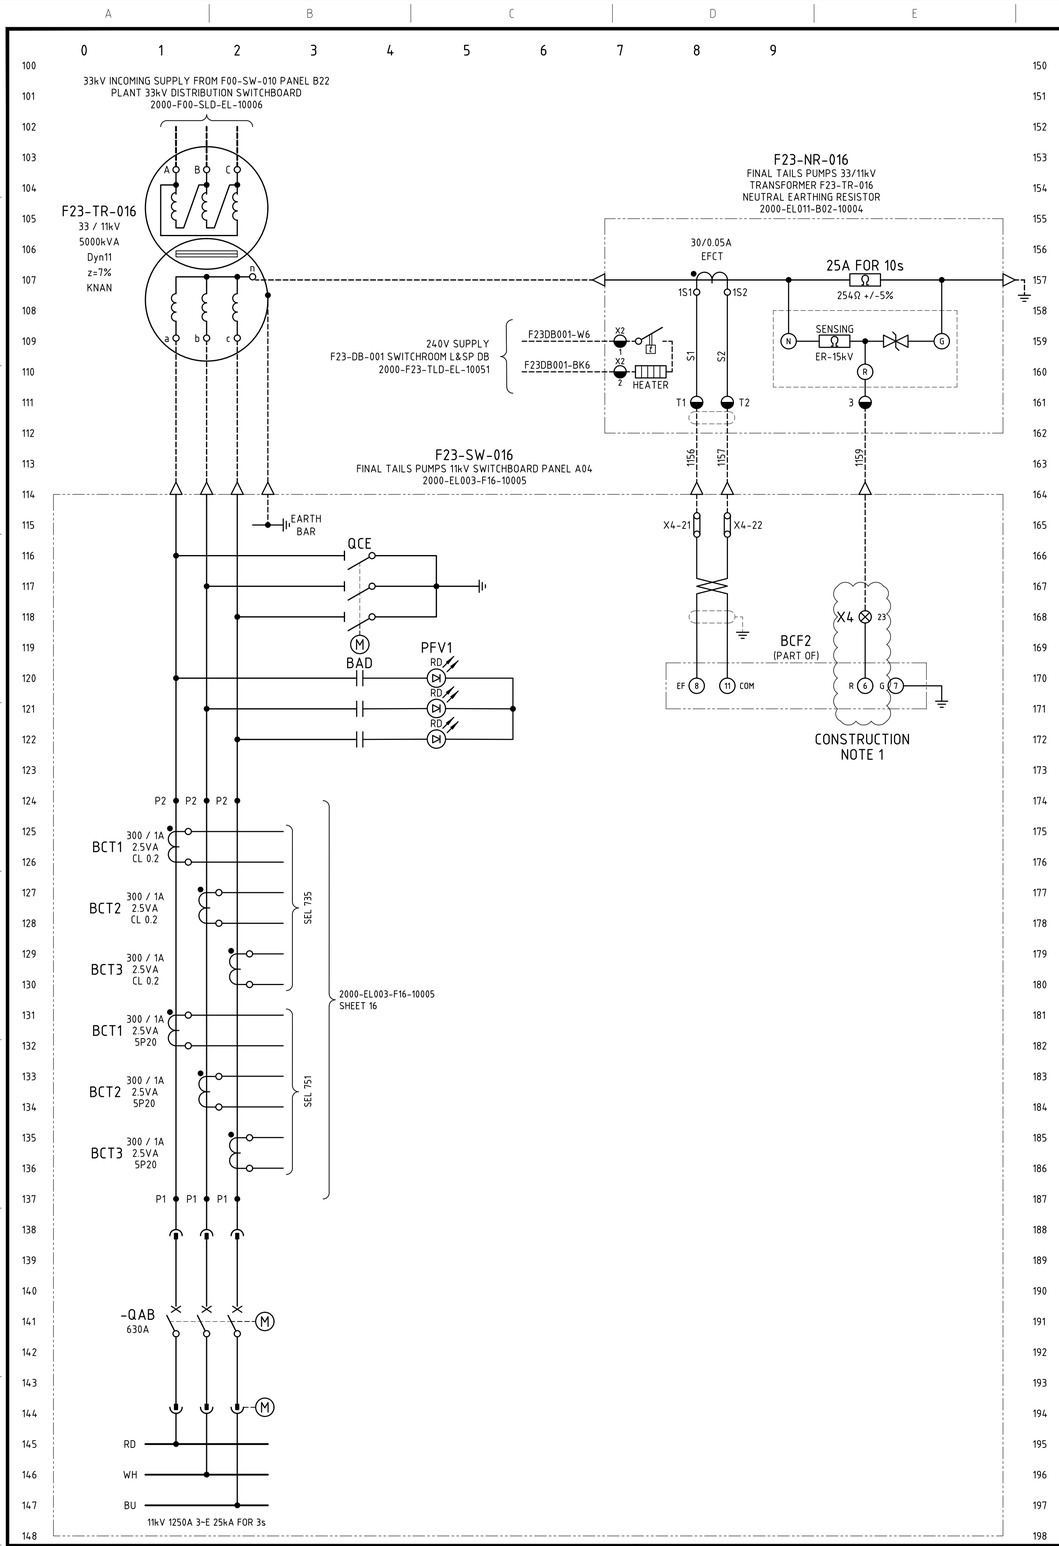


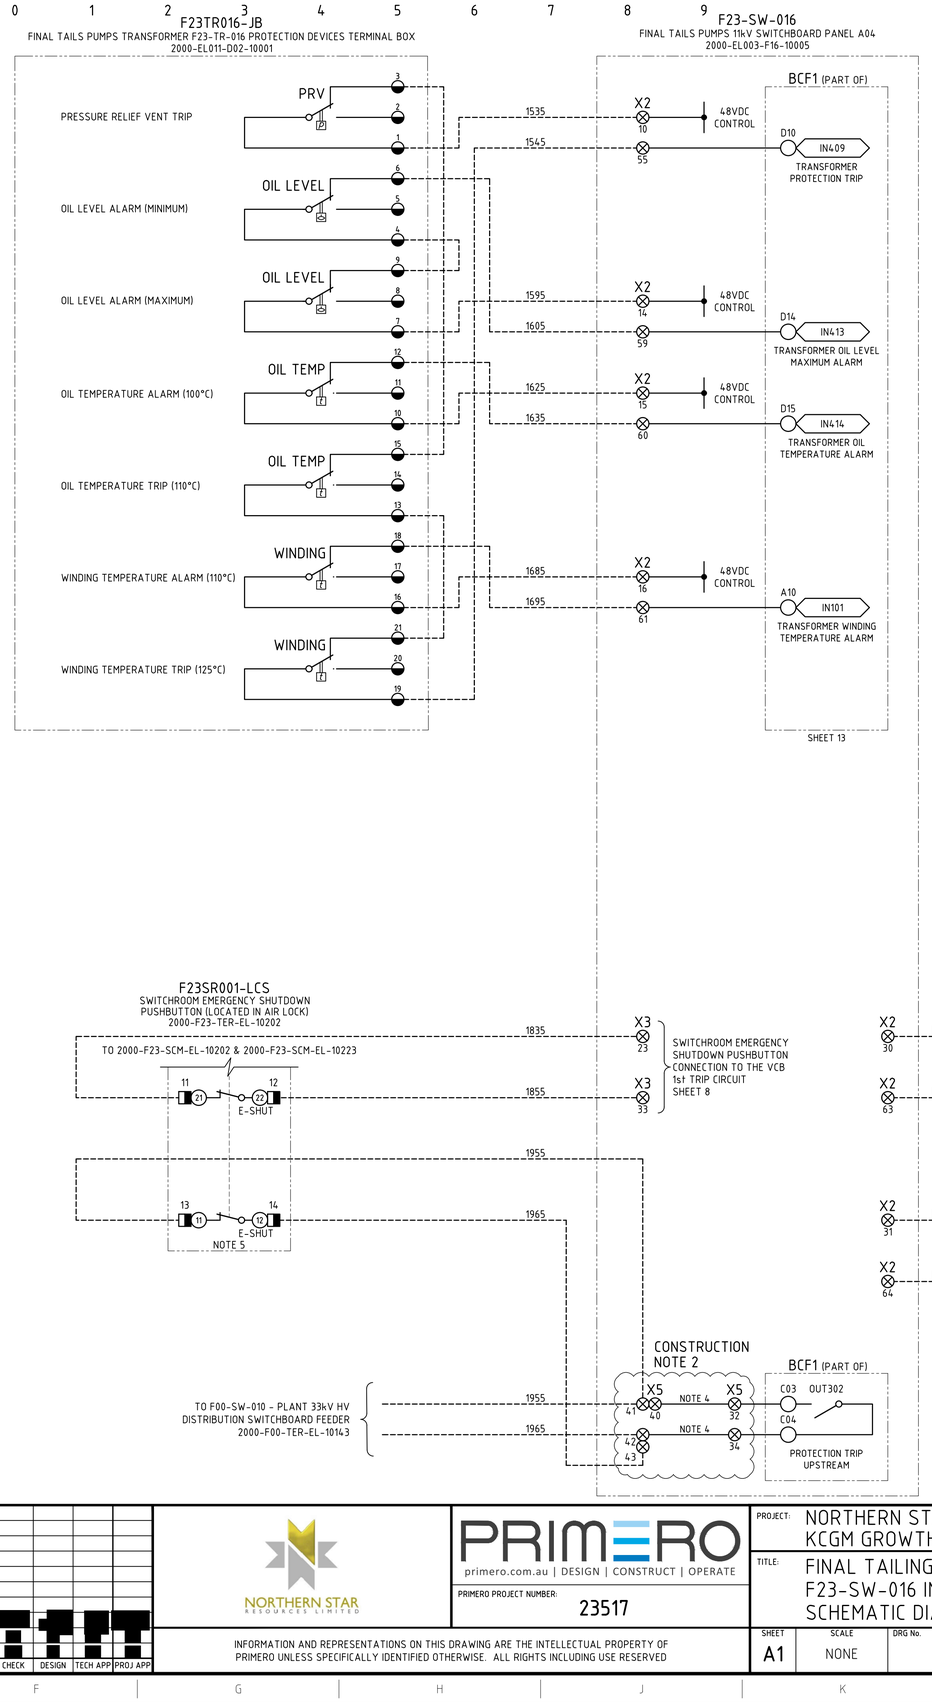

NOTES

1. WIRE NUMBER FERRULES ON TERMINAL STRIP SHALL BE PREFIXED WITH EQUIPMENT NUMBER e.g. F23SW016-1200, UNLESS OTHERWISE NOTED.
2. EACH WIRE SHALL BE IDENTIFIED AT BOTH ENDS WITH FERRULES.
3. ALL ALARMS AND TRIPS SHALL BE FAIL-SAFE EXCEPT THE BUCHHOLZ RELAY. NOTE THAT THE PROTECTION RELAY INPUTS SHALL BE INVERTED, I.E. ALARM AND TRIP WHEN CONTACT IS OPENED.
4. NOTE THAT CROSS SECTIONAL AREA OF CABLES FROM F00-SW-010 ARE INCREASED IN SIZE - REFER TO THE CABLE SCHEDULE.
5. E-SHUT CIRCUIT IS FAIL SAFE. NORMALLY CLOSED CONTACTS WILL BE OPEN WHEN THE E-SHUT BUTTON IS UN-ACTIVATED AND THE CIRCUIT HEALTHY.

CONSTRUCTION NOTES

1. CONFIRM TERMINAL X4:23 IS SPARE.
   INSTALL WIRING FROM TERMINAL X4:23 TO (SE330 AU) BCF2 TERMINAL R:6.
2. INSTALL LINKS ACROSS SPARE TERMINALS X5:40-X5:41 AND X5:42-X5:43.
   INSTALL BRIDGING WIRE FROM TERMINAL X5:32 TO TERMINAL X5:40.
   INSTALL BRIDGING WIRE FROM TERMINAL X5:34 TO TERMINAL X5:42.

LEGEND

- xx/xx/xx — DCS DIGITAL INPUT
- xx/xx/xx — DCS DIGITAL OUTPUT
- xx/xx/xx — DCS ANALOGUE INPUT
- xx/xx/xx — DCS ANALOGUE OUTPUT
- xx/xx/xx — DCS ANALOGUE RTD INPUT
- ⊗ — 11kV SWITCHBOARD TERMINAL
- ◓ — VSD TERMINAL
- ◒ — FIELD TERMINAL
- ◑ — DCS OR I/O TERMINAL
- ◧ — MARSHALLING TERMINAL
- (x) — DEVICE TERMINAL

PANEL A04

DRG No.	REFERENCES
2000-EL003-F16-10005	F23-SW-016 ABB SCHEMATIC DIAGRAM
2000-F23-TER-EL-10107	F23-SW-016 11kV SWITCHBOARD - PANEL A04 (INCOMER) TERMINATION DIAGRAM SHEET 1
2000-F23-SLD-EL-10001	F23-SW-016 11kV SWITCHBOARD SINGLE LINE DIAGRAM SHEET 1
2000-F00-STD-EL-10001	GENERAL NOTES AND STANDARD DRAWINGS INDEX

REV	DATE	DESCRIPTION	DRAW	CHECK	DESIGN	TECH APP	PROJ APP
1	23SEP25	FAT REDLINES INCORPORATED - NO CHANGE					
0	11MAR25	APPROVED FOR CONSTRUCTION					

NORTHERN STAR RESOURCES LIMITED

PRIMERO
primero.com.au | DESIGN | CONSTRUCT | OPERATE

PRIMERO PROJECT NUMBER: 23517

INFORMATION AND REPRESENTATIONS ON THIS DRAWING ARE THE INTELLECTUAL PROPERTY OF PRIMERO UNLESS SPECIFICALLY IDENTIFIED OTHERWISE. ALL RIGHTS INCLUDING USE RESERVED

PROJECT: NORTHERN STAR RESOURCES LTD
KCGM GROWTH PROJECT

TITLE: FINAL TAILINGS HANDLING & STORAGE - F23-SW-016
F23-SW-016 INCOMER
SCHEMATIC DIAGRAM

SHEET	SCALE	DRG No.	REVISION
A1	NONE	2000-F23-SCM-EL-10107	1

O:\CAD PROJECTS\235 NORTHERN STAR RESOURCES LTD\23517 KCGM GROWTH PROJECT\03 DELIVERABLES\ELVF23 - FINAL TAILINGS HANDLING & STORAGE\2000-F23-SCM-EL-10107.DWG 02OCT25 9:03AM HOTSEA104