
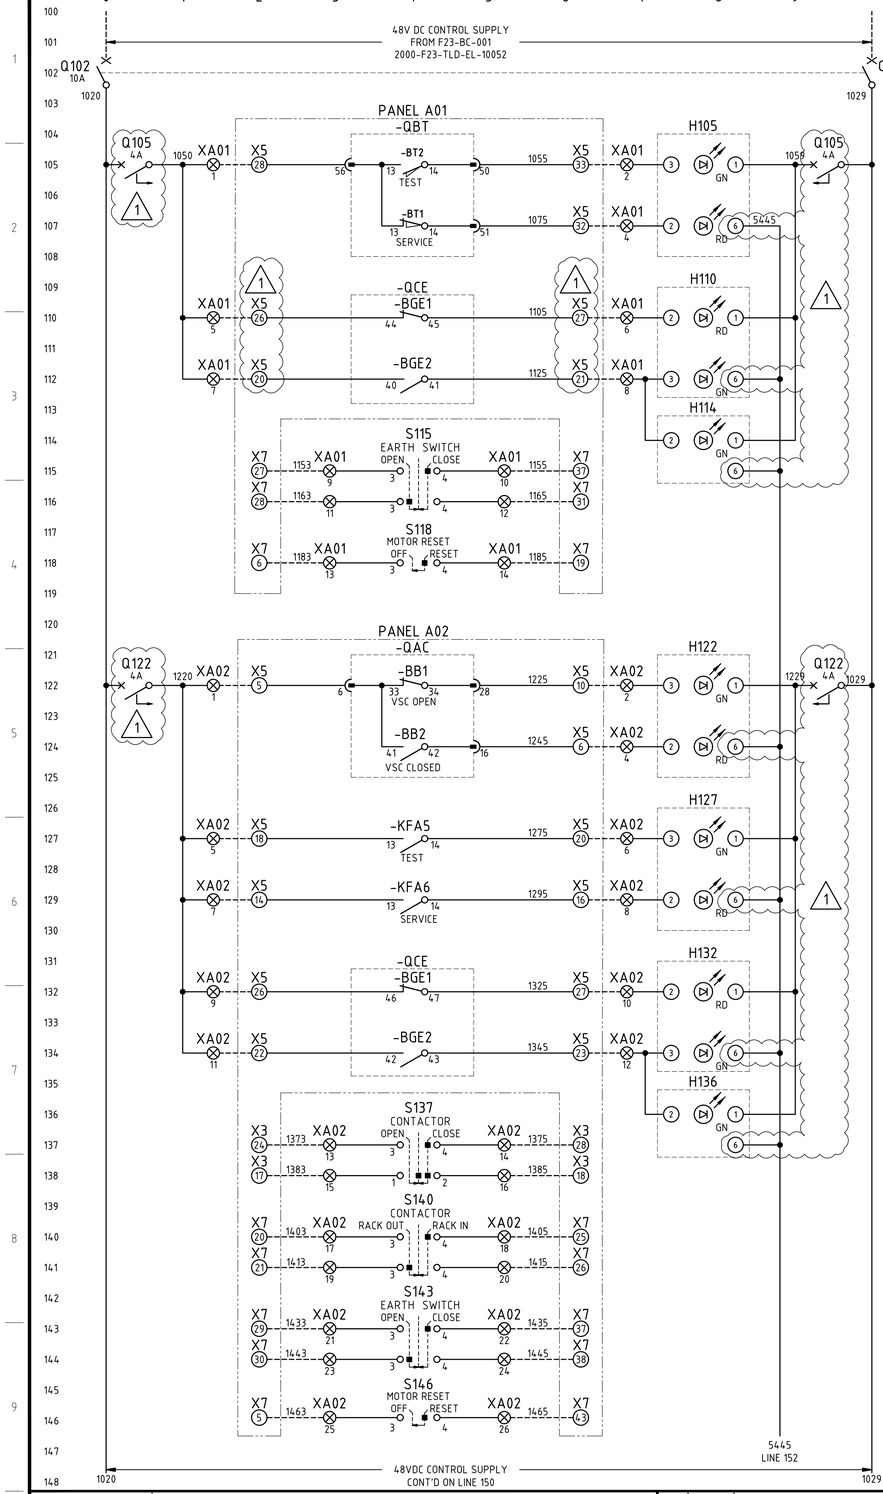


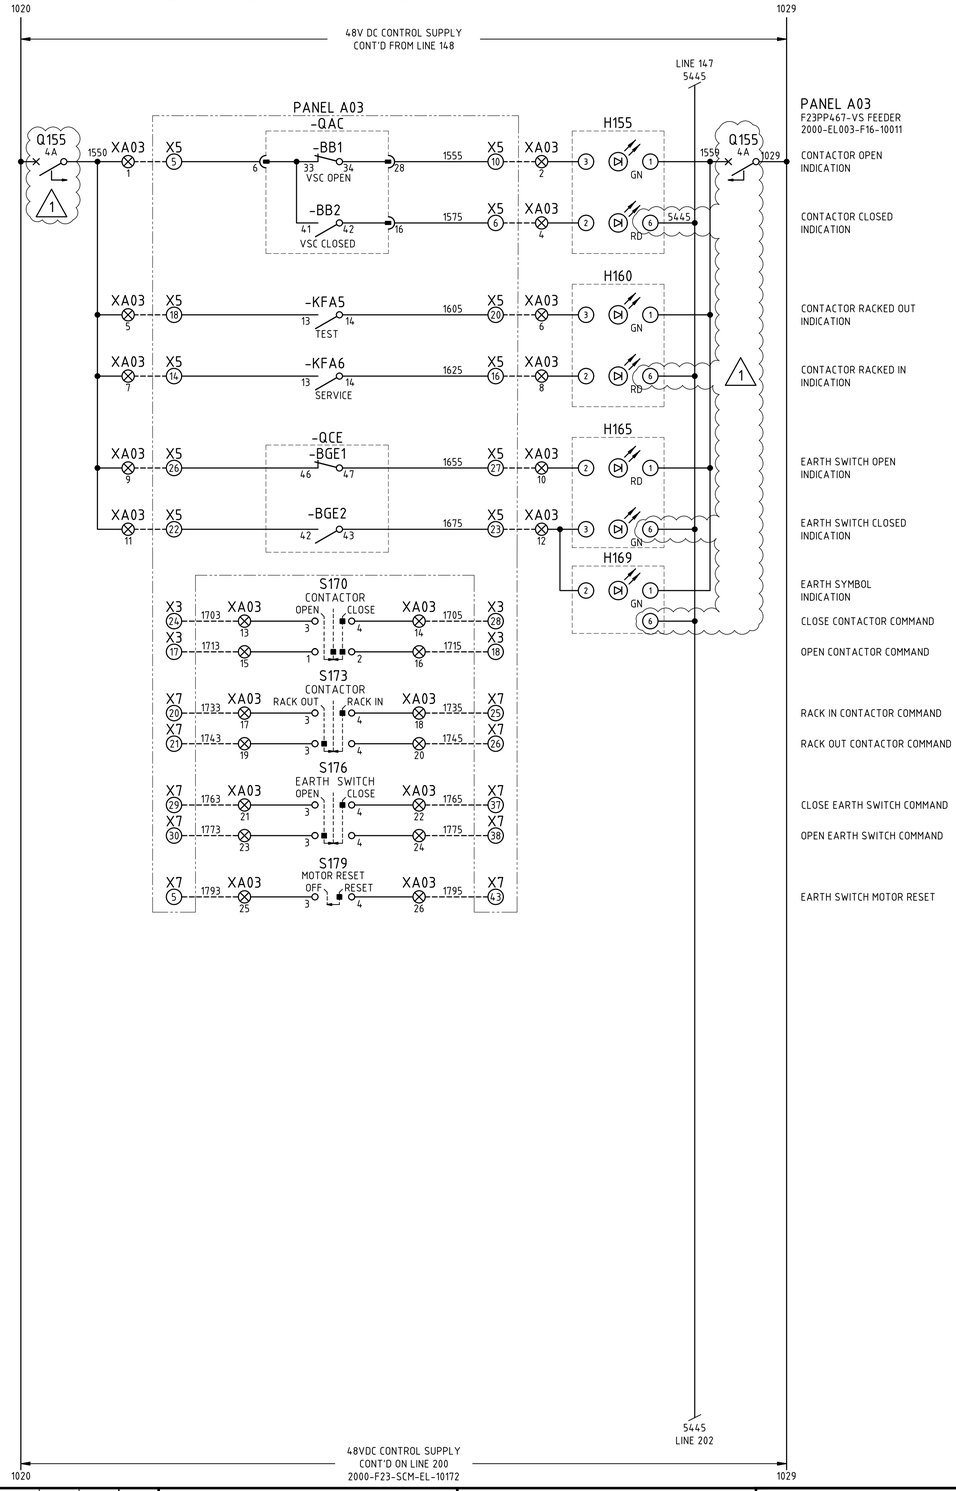

PANEL A01
BUS VT & EARTH SWITCH
2000-EL003-F16-10001

VT RACKED OUT INDICATION

VT RACKED IN INDICATION

EARTH SWITCH OPEN INDICATION

EARTH SWITCH CLOSED INDICATION

EARTH SYMBOL INDICATION

CLOSE EARTH SWITCH COMMAND

OPEN EARTH SWITCH COMMAND

MOTOR RESET

PANEL A02
F23PP466-VS FEEDER
2000-EL003-F16-10011

CONTACTOR OPEN INDICATION

CONTACTOR CLOSED INDICATION

CONTACTOR RACKED OUT INDICATION

CONTACTOR RACKED IN INDICATION

EARTH SWITCH OPEN INDICATION

EARTH SWITCH CLOSED INDICATION

EARTH SYMBOL INDICATION

CLOSE CONTACTOR COMMAND

OPEN CONTACTOR COMMAND

RACK IN CONTACTOR COMMAND

RACK OUT CONTACTOR COMMAND

CLOSE EARTH SWITCH COMMAND

OPEN EARTH SWITCH COMMAND

MOTOR RESET

PANEL A03
F23PP467-VS FEEDER
2000-EL003-F16-10011

CONTACTOR OPEN INDICATION

CONTACTOR CLOSED INDICATION

CONTACTOR RACKED OUT INDICATION

CONTACTOR RACKED IN INDICATION

EARTH SWITCH OPEN INDICATION

EARTH SWITCH CLOSED INDICATION

EARTH SYMBOL INDICATION

CLOSE CONTACTOR COMMAND

OPEN CONTACTOR COMMAND

RACK IN CONTACTOR COMMAND

RACK OUT CONTACTOR COMMAND

CLOSE EARTH SWITCH COMMAND

OPEN EARTH SWITCH COMMAND

EARTH SWITCH MOTOR RESET

NOTES

1. WIRE NUMBER FERRULES ON TERMINAL STRIP SHALL BE PREFIXED WITH EQUIPMENT NUMBER e.g. FxxPPxxx-1200, UNLESS OTHERWISE NOTED.
2. EACH WIRE SHALL BE IDENTIFIED AT BOTH ENDS WITH FERRULES.

LEGEND

- RSP TERMINAL
- HV SWITCHBOARD TERMINAL
- DEVICE TERMINAL

DRG No.	REFERENCES
2000-EL001-D04-10080	F23SW016-LCS FINAL TAILINGS & STORAGE 11kV SWBD REMOTE SWITCHING PANEL GENERAL ARRANGEMENT
2000-F23-TER-EL-10171	F23SW016-LCS FINAL TAILINGS & STORAGE 11kV SWBD REMOTE SWITCHING PANEL TERMINATION DIAG. SH 1-2
2000-F23-SCM-EL-10171	F23SW016-LCS FINAL TAILINGS & STORAGE 11kV SWBD REMOTE SWITCHING PANEL SCHEMATIC DIAG. SH 1-5
2000-F23-SLD-EL-10001	F23-SW-016 FINAL TAILINGS & STORAGE 11kV SWBD SINGLE LINE DIAGRAM SHEET 1-2
2000-F00-STD-EL-10001	GENERAL NOTES AND STANDARD DRAWINGS INDEX

REV	DATE	DESCRIPTION	DRAW	CHECK	DESIGN	TECH APP	PROJ APP
1	17SEP25	FAT REDLINES INCORPORATED					
0	03DEC24	APPROVED FOR CONSTRUCTION					

NORTHERN STAR RESOURCES LIMITED

PRIMERO
primero.com.au | DESIGN | CONSTRUCT | OPERATE

PRIMERO PROJECT NUMBER: 23517

INFORMATION AND REPRESENTATIONS ON THIS DRAWING ARE THE INTELLECTUAL PROPERTY OF PRIMERO UNLESS SPECIFICALLY IDENTIFIED OTHERWISE. ALL RIGHTS INCLUDING USE RESERVED

PROJECT: NORTHERN STAR RESOURCES LTD
KCGM GROWTH PROJECT

TITLE: FINAL TAILINGS HANDLING & STORAGE - F23SW016-LCS
11kV SWITCHBOARD REMOTE SWITCHING PANEL
SCHEMATIC DIAGRAM SHEET 1

SHEET	SCALE	DRG No.	REVISION
A1	NONE	2000-F23-SCM-EL-10171	1

O:\CAD PROJECTS\235 NORTHERN STAR RESOURCES LTD\23517 KCGM GROWTH PROJECT\03 DELIVERABLES\EL\F23 - FINAL TAILINGS HANDLING & STORAGE\2000-F23-SCM-EL-10171.DWG 020CT25 9:03AM HOTSEAT04