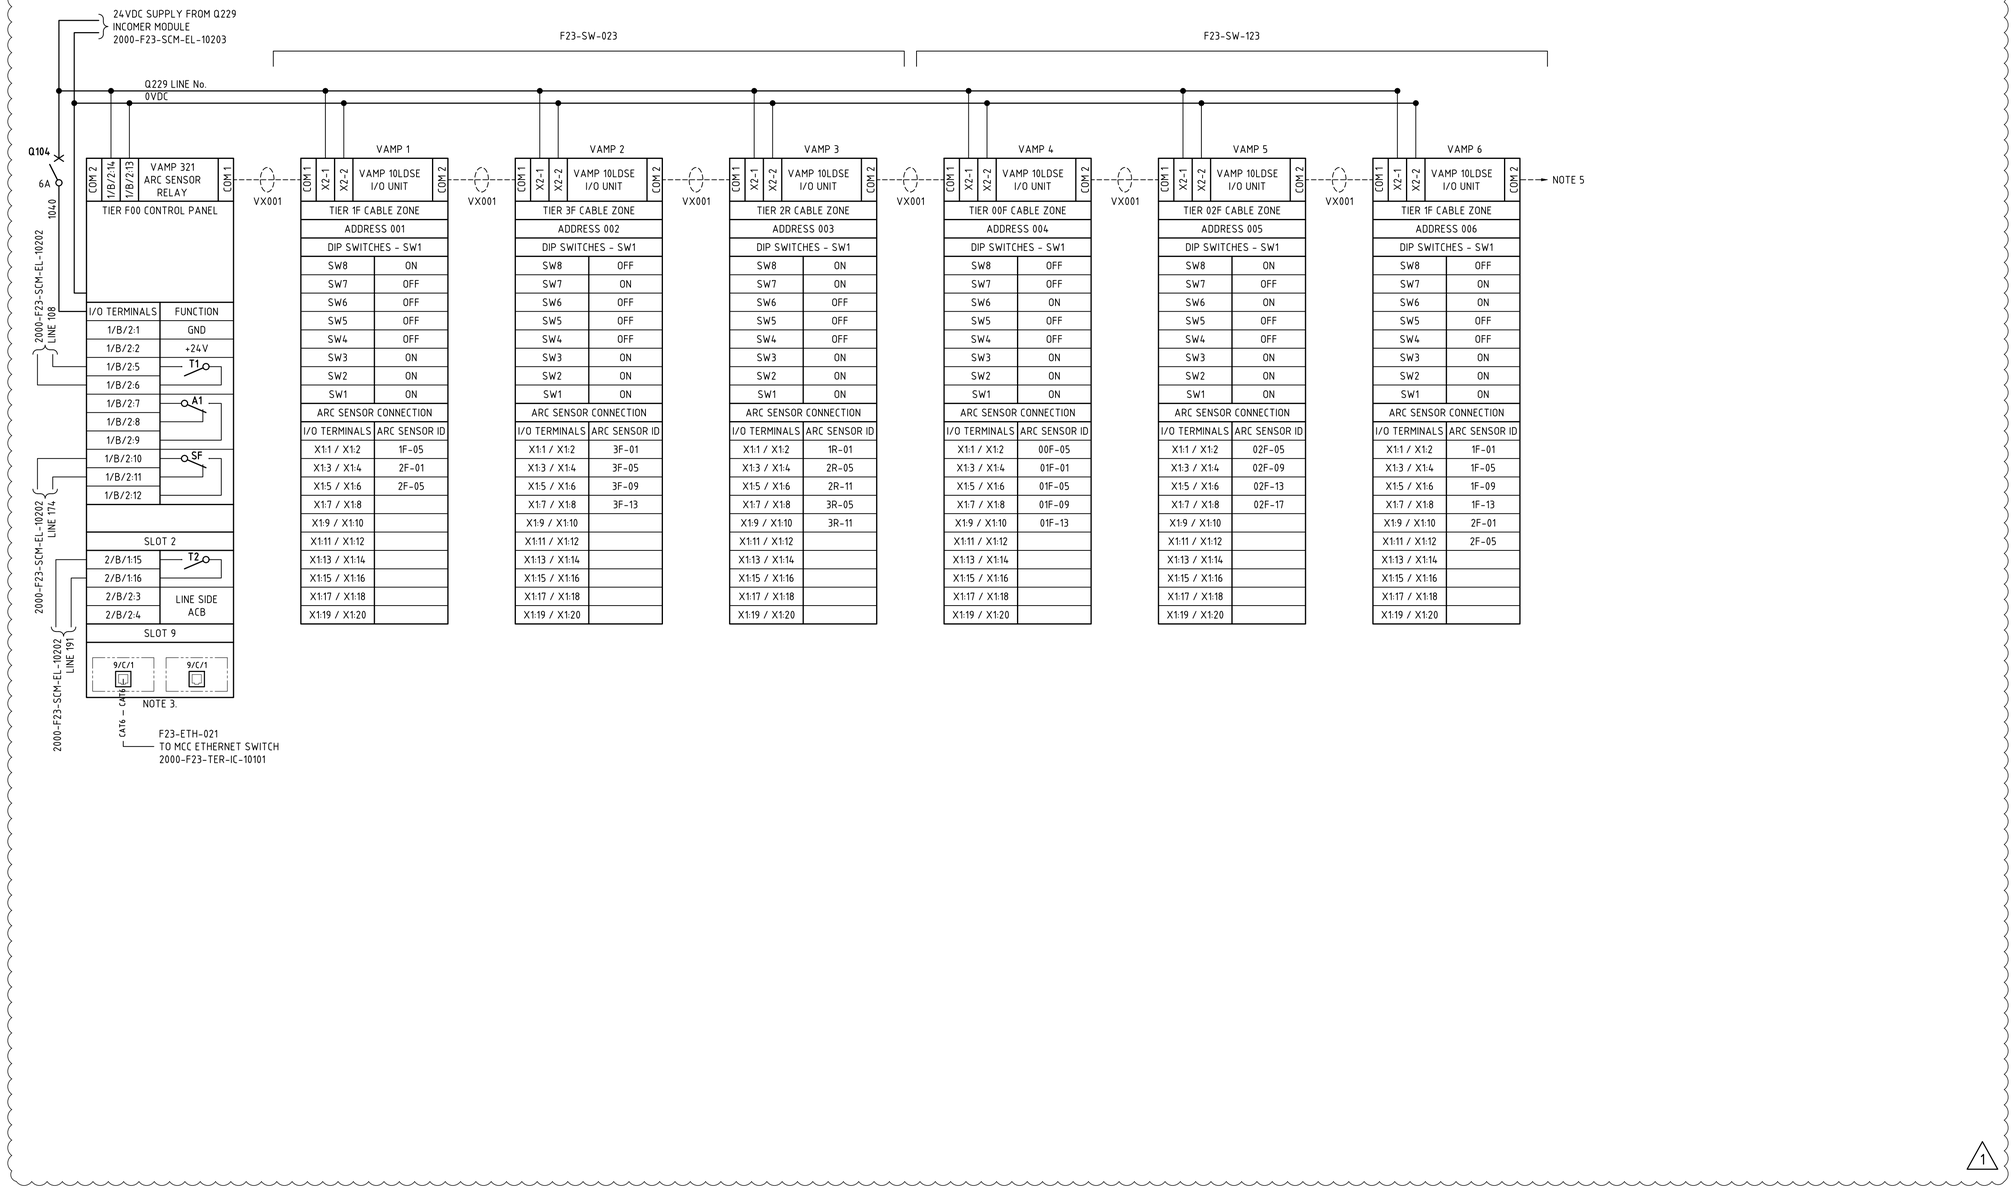



## NOTES

1. CABLE NUMBER FOR ARC FLASH SENSOR VA1DA SHALL BE THE EQUIPMENT NUMBER FOLLOWED BY COM FOR COMMUNICATION AND A SEQUENTIAL NUMBER e.g. F23SW023-COMx.
2. EACH CABLE SHALL BE IDENTIFIED AT BOTH ENDS WITH CABLE NUMBER.
3. VAMP 321 ARC FAULT PROTECTION RELAY SHALL BE MOUNTED TO THE DOOR OF THE PANEL INCOMER CONTROL CUBICLE.
4. VAM 10LDSE INTERFACE SHALL BE MOUNTED ON THE CABLE ZONE DOOR.
5. MAXIMUM 16 VAM10LDSE I/O UNITS IN SERIES.
6. MAXIMUM LENGTH OF VX001 CABLE BETWEEN 2 UNITS (I/O UNITS OR VAMP321 UNIT) IS 30m & TOTAL LENGTH OF THE BUS CABLE FROM THE START TO THE END OF 100m SHALL NOT BE EXCEEDED.

## LEGEND

- CABLE MARKER LABEL
- 24VDC SUPPLY CABLE
- COMMUNICATION CABLE

| DIP SWITCHES KEY VAMP 10LDSE | | |
|---|---|---|
| | ON | OFF |
| SW8 | 1 | 0 |
| SW7 | 2 | 0 |
| SW6 | 4 | 0 |
| SW5 | 8 | 0 |
| SW4 | 16 | 0 |
| SW3 | L> | L> + I> |
| SW2 | LATCH | NON LATCHING |
| SW1 | L> INT | L> EXT |

L = LIGHT / I = CURRENT

| DRG No. | REFERENCES |
|---|---|
| 2000-F23-SLD-EL-10201 | F23-SW-023 415V MCC SINGLE LINE DIAGRAM SHEET 1 |
| 2000-F00-STD-EL-10001 | GENERAL NOTES AND STANDARD DRAWINGS INDEX |

| REV | DATE | DESCRIPTION | DRAW | CHECK | DESIGN | TECH APP | PROJ APP |
|---|---|---|---|---|---|---|---|
| 1 | 18SEP25 | FAT REDLINES INCOPORATED | | | | | |
| 0 | 25SEP24 | APPROVED FOR CONSTRUCTION | | | | | |

NORTHERN STAR RESOURCES LIMITED

PRIMERO
primero.com.au | DESIGN | CONSTRUCT | OPERATE

PRIMERO PROJECT NUMBER: 23517

INFORMATION AND REPRESENTATIONS ON THIS DRAWING ARE THE INTELLECTUAL PROPERTY OF PRIMERO UNLESS SPECIFICALLY IDENTIFIED OTHERWISE. ALL RIGHTS INCLUDING USE RESERVED

PROJECT: NORTHERN STAR RESOURCES LTD
KCGM GROWTH PROJECT

TITLE: FINAL TAILINGS HANDLING & STORAGE - F23-SW-023
F23-SW-023 ARC FLASH SYSTEM
SCHEMATIC DIAGRAM

| SHEET | SCALE | DRG No. | REVISION |
|---|---|---|---|
| A1 | NONE | 2000-F23-SCM-EL-10204 | 1 |

O:\CAD PROJECTS\235 NORTHERN STAR RESOURCES LTD\23517 KCGM GROWTH PROJECT\03 DELIVERABLES\EL\F23 - FINAL TAILINGS HANDLING & STORAGE\2000-F23-SCM-EL-10204.DWG 02OCT25 9:03AM HOTSEAT04