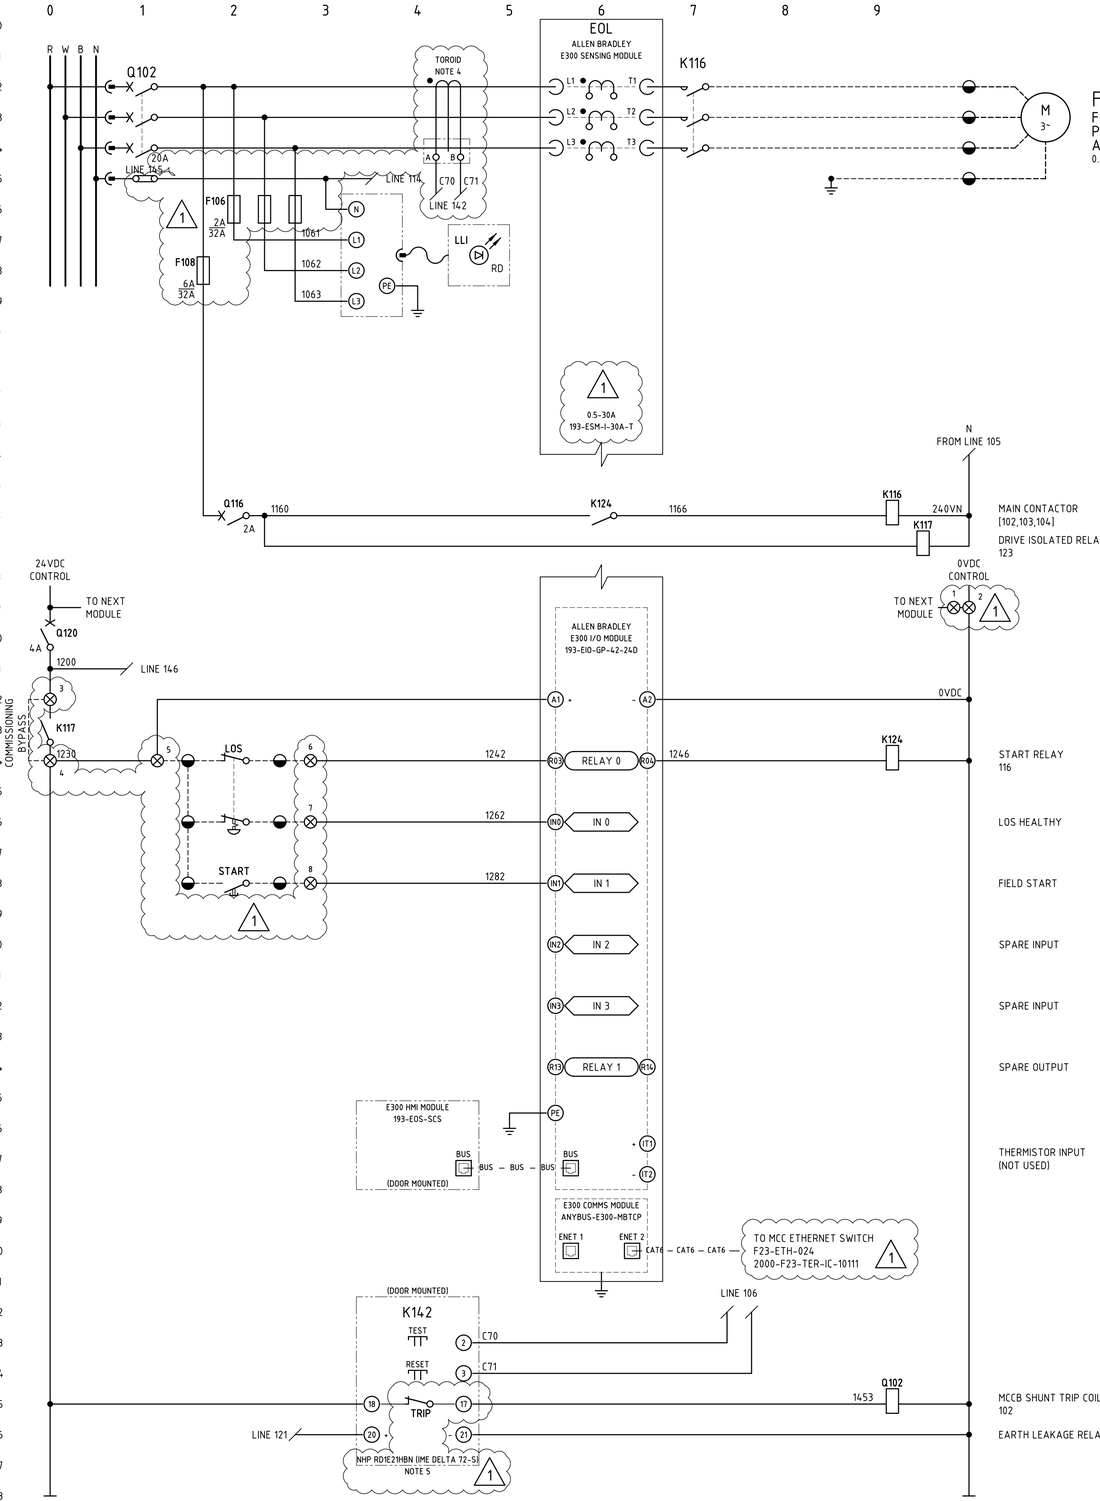



## NOTES


1. TERMINALS ON TERMINAL STRIPS ABOVE 50VAC SHALL HAVE A SEPARATE PERSPEX SHROUD AND SHALL BE LABELLED "DANGER xxxVAC".
2. WIRE NUMBER FERRULES ON TERMINAL STRIP SHALL BE PREFIXED WITH EQUIPMENT NUMBER e.g. F23FN469-1200, UNLESS OTHERWISE NOTED. (1)
3. EACH WIRE SHALL BE IDENTIFIED AT BOTH ENDS WITH FERRULES.
4. NHP TDGB2
   IN:70A IΔN MIN:0.03A TOROID TO SUIT CABLE DIAMETER.
5. EARTH LEAKAGE RELAY (ELV) USER INTERFACE TO BE MOUNTED ON MCC MODULE DOOR. RELAY ENERGISED (NORMALLY CLOSED CONTACT OPEN) IN NORMAL OPERATION. (1)

## LEGEND

- 00/01/00 — DCS DIGITAL INPUT
- 00/02/00 — DCS DIGITAL OUTPUT
- ⊗ — MCC TERMINAL
- ◕ — VSD TERMINAL
- ◒ — FIELD TERMINAL
- ◑ — DCS OR I/O TERMINAL
- ◧ — MARSHALLING TERMINAL
- (x) — DEVICE TERMINAL
- ⊗cc — INDICATION LAMP, cc = COLOUR

(1)

## TERMINATION LEGEND

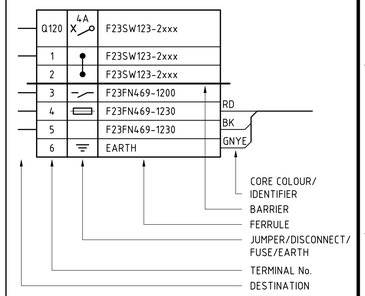


| DRG No. | REFERENCES | REV | DATE | DESCRIPTION | DRAW | CHECK | DESIGN | TECH APP | PROJ APP |
|---|---|---|---|---|---|---|---|---|---|
| 2000-F23-SLD-EL-10211 | F23-SW-123 415V EMERGENCY MCC SINGLE LINE DIAGRAM SHEET 1 | 1 | 18SEP25 | FAT REDLINES INCORPORATED | | | | | |
| 2000-F00-STD-EL-10001 | GENERAL NOTES AND STANDARD DRAWINGS INDEX | 0 | 25SEP24 | APPROVED FOR CONSTRUCTION | | | | | |

NORTHERN STAR RESOURCES LIMITED

PRIMERO
primero.com.au | DESIGN | CONSTRUCT | OPERATE

PRIMERO PROJECT NUMBER: 23517

INFORMATION AND REPRESENTATIONS ON THIS DRAWING ARE THE INTELLECTUAL PROPERTY OF PRIMERO UNLESS SPECIFICALLY IDENTIFIED OTHERWISE. ALL RIGHTS INCLUDING USE RESERVED

PROJECT: NORTHERN STAR RESOURCES LTD
KCGM GROWTH PROJECT

TITLE: FINAL TAILINGS HANDLING & STORAGE - F23-SW-123
F23-FN-469 FINAL TAILS PUMP 4 GB OIL AIR COOLING FAN
SCHEMATIC AND TERMINATION DIAGRAM

| SHEET | SCALE | DRG No. | REVISION |
|---|---|---|---|
| A1 | NONE | 2000-F23-SCM-EL-10213 | 1 |

O:\CAD PROJECTS\235 NORTHERN STAR RESOURCES LTD\23517 KCGM GROWTH PROJECT\03 DELIVERABLES\ELY\F23 - FINAL TAILINGS HANDLING & STORAGE\2000-F23-SCM-EL-10213.DWG 02OCT25 9:03AM HOTSEAT04