


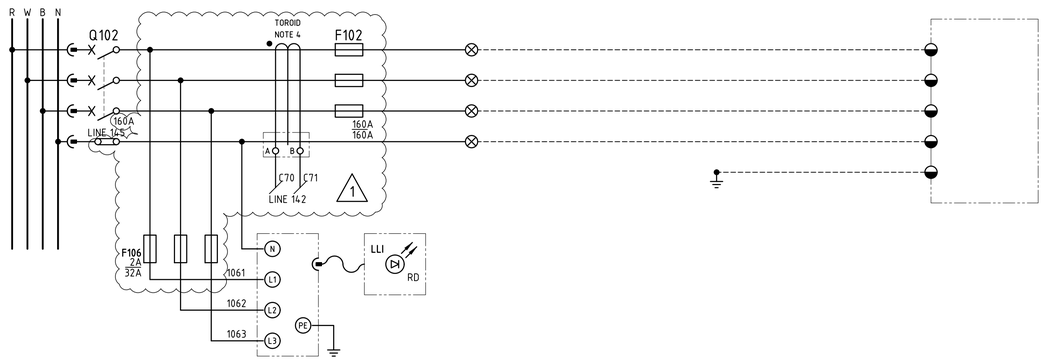



F23-DB-101
FINAL TAILS PUMPS
11kV SWITCHROOM
HV VSD AUXILIARY SUPPLIES DB
160 A

2000-F23-TLD-EL-10054

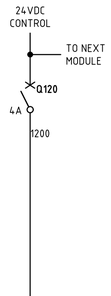

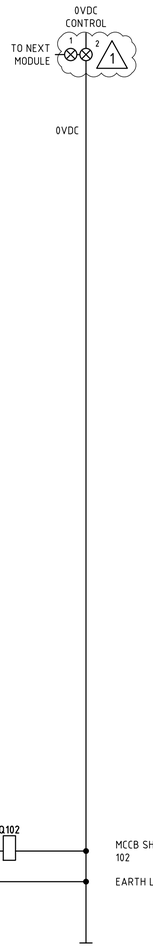

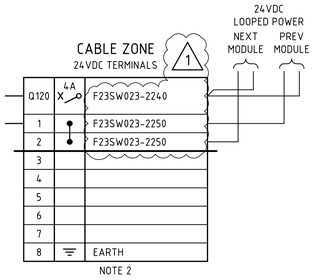

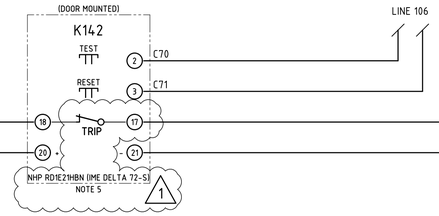

NOTES


1. TERMINALS ON TERMINAL STRIPS ABOVE 50VAC SHALL HAVE A SEPARATE PERSPEX SHROUD AND SHALL BE LABELLED "DANGER xxxVAC".
2. WIRE NUMBER FERRULES ON TERMINAL STRIP SHALL BE PREFIXED WITH EQUIPMENT NUMBER e.g. F23DB101-1200, UNLESS OTHERWISE NOTED. (1)
3. EACH WIRE SHALL BE IDENTIFIED AT BOTH ENDS WITH FERRULES.
4. NHP TDGB2
   IN:70A IΔN MIN:0.03A TOROID TO SUIT CABLE DIAMETER.
5. EARTH LEAKAGE RELAY (ELV) USER INTERFACE TO BE MOUNTED ON MCC MODULE DOOR. RELAY ENERGISED (NORMALLY CLOSED CONTACT OPEN) IN NORMAL OPERATION. (1)

LEGEND

00/01/00	DCS DIGITAL INPUT
00/02/00	DCS DIGITAL OUTPUT
⊗	MCC TERMINAL
◕	VSD TERMINAL
◒	FIELD TERMINAL
◑	DCS OR I/O TERMINAL
◧	MARSHALLING TERMINAL
⊗ x	DEVICE TERMINAL
⊗ cc	INDICATION LAMP cc = COLOUR

(1)

TERMINATION LEGEND

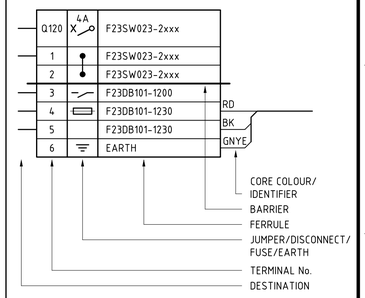

DRG No.	REFERENCES	REV	DATE	DESCRIPTION	DRAW	CHECK	DESIGN	TECH APP	PROJ APP
2000-F23-SLD-EL-10201	F23-SW-023 415V MCC SINGLE LINE DIAGRAM SHEET 1	1	18SEP25	FAT REDLINES INCORPORATED					
2000-F00-STD-EL-10001	GENERAL NOTES AND STANDARD DRAWINGS INDEX	0	25SEP24	APPROVED FOR CONSTRUCTION					

NORTHERN STAR RESOURCES LIMITED

PRIMERO
primero.com.au | DESIGN | CONSTRUCT | OPERATE

PRIMERO PROJECT NUMBER: 23517

INFORMATION AND REPRESENTATIONS ON THIS DRAWING ARE THE INTELLECTUAL PROPERTY OF PRIMERO UNLESS SPECIFICALLY IDENTIFIED OTHERWISE. ALL RIGHTS INCLUDING USE RESERVED

PROJECT: NORTHERN STAR RESOURCES LTD
KCGM GROWTH PROJECT

TITLE: FINAL TAILINGS HANDLING & STORAGE - F23-SW-023
F23-DB-101 HV VSD AUXILIARY SUPPLIES 415V DB
SCHEMATIC AND TERMINATION DIAGRAM

SHEET	SCALE	DRG No.	REVISION
A1	NONE	2000-F23-SCM-EL-10224	1

O:\CAD PROJECTS\235 NORTHERN STAR RESOURCES LTD\23517 KCGM GROWTH PROJECT\03 DELIVERABLES\EL\F23 - FINAL TAILINGS HANDLING & STORAGE\2000-F23-SCM-EL-10224.DWG 020CT25 9:04AM HOTSEAT04