

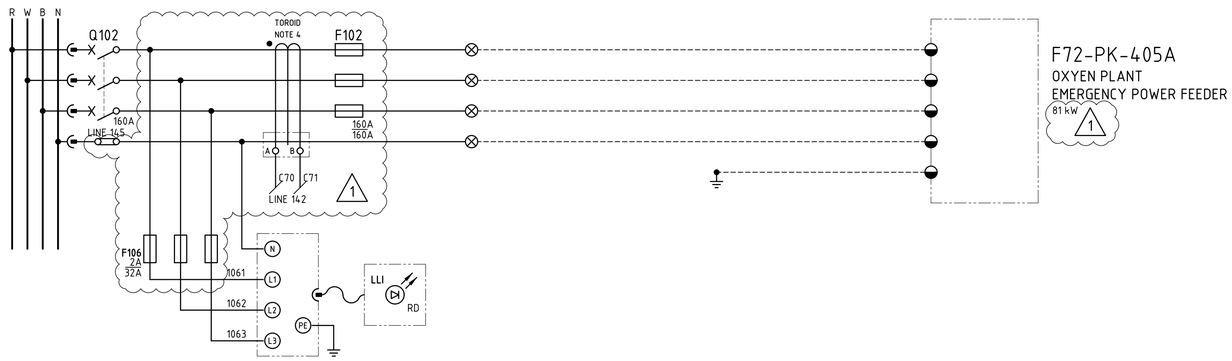


F72-PK-405A
OXYEN PLANT
EMERGENCY POWER FEEDER
81 kW
1

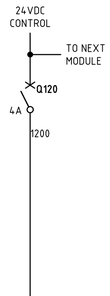

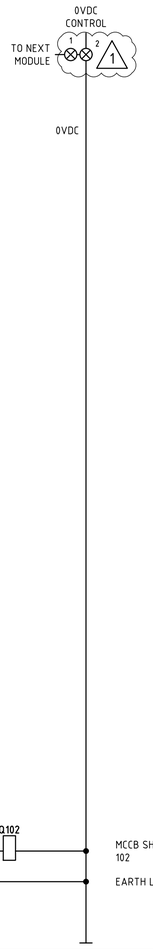


CABLE ZONE
24VDC TERMINALS
1

24VDC
LOOPED POWER
NEXT MODULE
PREV MODULE

Q120	4A	F23SW123-2610
1		F23SW123-2620
2		F23SW123-2620
3		
4		
5		
6		
7		
8	⏚	EARTH

NOTE 2

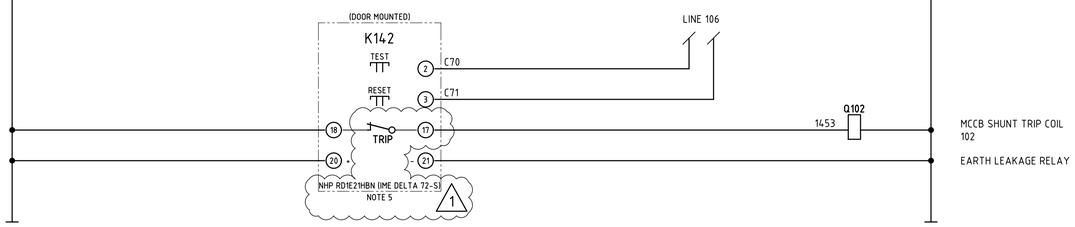

NOTES

1. TERMINALS ON TERMINAL STRIPS ABOVE 50VAC SHALL HAVE A SEPARATE PERSPEX SHROUD AND SHALL BE LABELLED "DANGER xxxVAC".
2. WIRE NUMBER FERRULES ON TERMINAL STRIP SHALL BE PREFIXED WITH EQUIPMENT NUMBER e.g. F72PK405A-1200, UNLESS OTHERWISE NOTED. (1)
3. EACH WIRE SHALL BE IDENTIFIED AT BOTH ENDS WITH FERRULES.
4. NHP TDGH2
   IN:90A IΔN MIN:0.03A TOROID TO SUIT CABLE DIAMETER.
5. EARTH LEAKAGE RELAY (ELV) USER INTERFACE TO BE MOUNTED ON MCC MODULE DOOR. RELAY ENERGISED (NORMALLY CLOSED CONTACT OPEN) IN NORMAL OPERATION. (1)

LEGEND

- 00/01/00 — DCS DIGITAL INPUT
- 00/02/00 — DCS DIGITAL OUTPUT
- ⊗ — MCC TERMINAL
- ◕ — VSD TERMINAL
- ◒ — FIELD TERMINAL
- ◑ — DCS OR I/O TERMINAL
- ◧ — MARSHALLING TERMINAL
- ⊗ x — DEVICE TERMINAL
- ⊗ cc — INDICATION LAMP, cc = COLOUR

1

TERMINATION LEGEND

Q120	4A	F23SW123-2xxx
1		F23SW123-2xxx
2		F23SW123-2xxx
3		F72PK405A-1096
4		F72PK405A-1106
5		F72PK405A-1116
6	⏚	EARTH

RD
BK
GNYE

- CORE COLOUR/ IDENTIFIER
- BARRIER
- FERRULE
- JUMPER/DISCONNECT/ FUSE/EARTH
- TERMINAL No.
- DESTINATION

DRG No.	REFERENCES
2000-F23-SLD-EL-10211	F23-SW-123 415V EMERGENCY MCC SINGLE LINE DIAGRAM SHEET 1
2000-F00-STD-EL-10001	GENERAL NOTES AND STANDARD DRAWINGS INDEX

REV	DATE	DESCRIPTION	DRAW	CHECK	DESIGN	TECH APP	PROJ APP
1	18SEP25	FAT REDLINES INCORPORATED					
0	04APR25	APPROVED FOR CONSTRUCTION					

NORTHERN STAR RESOURCES LIMITED

PRIMERO
primero.com.au | DESIGN | CONSTRUCT | OPERATE

PRIMERO PROJECT NUMBER: 23517

INFORMATION AND REPRESENTATIONS ON THIS DRAWING ARE THE INTELLECTUAL PROPERTY OF PRIMERO UNLESS SPECIFICALLY IDENTIFIED OTHERWISE. ALL RIGHTS INCLUDING USE RESERVED

PROJECT: NORTHERN STAR RESOURCES LTD
KCGM GROWTH PROJECT

TITLE: FINAL TAILINGS HANDLING & STORAGE - F23-SW-123
F72-PK-405A OXYGEN PLANT EMERGENCY POWER FEEDER
SCHEMATIC AND TERMINATION DIAGRAM

SHEET	SCALE	DRG No.	REVISION
A1	NONE	2000-F23-SCM-EL-10225	1

O:\CAD PROJECTS\235 NORTHERN STAR RESOURCES LTD\23517 KCGM GROWTH PROJECT\03 DELIVERABLES\EL\F23 - FINAL TAILINGS HANDLING & STORAGE\2000-F23-SCM-EL-10225.DWG 020CT25 9:03AM HOTSEAT04