
Docusign Envelope ID: D3EAC8FF-146A-4610-AFF4-26203B4BB02C

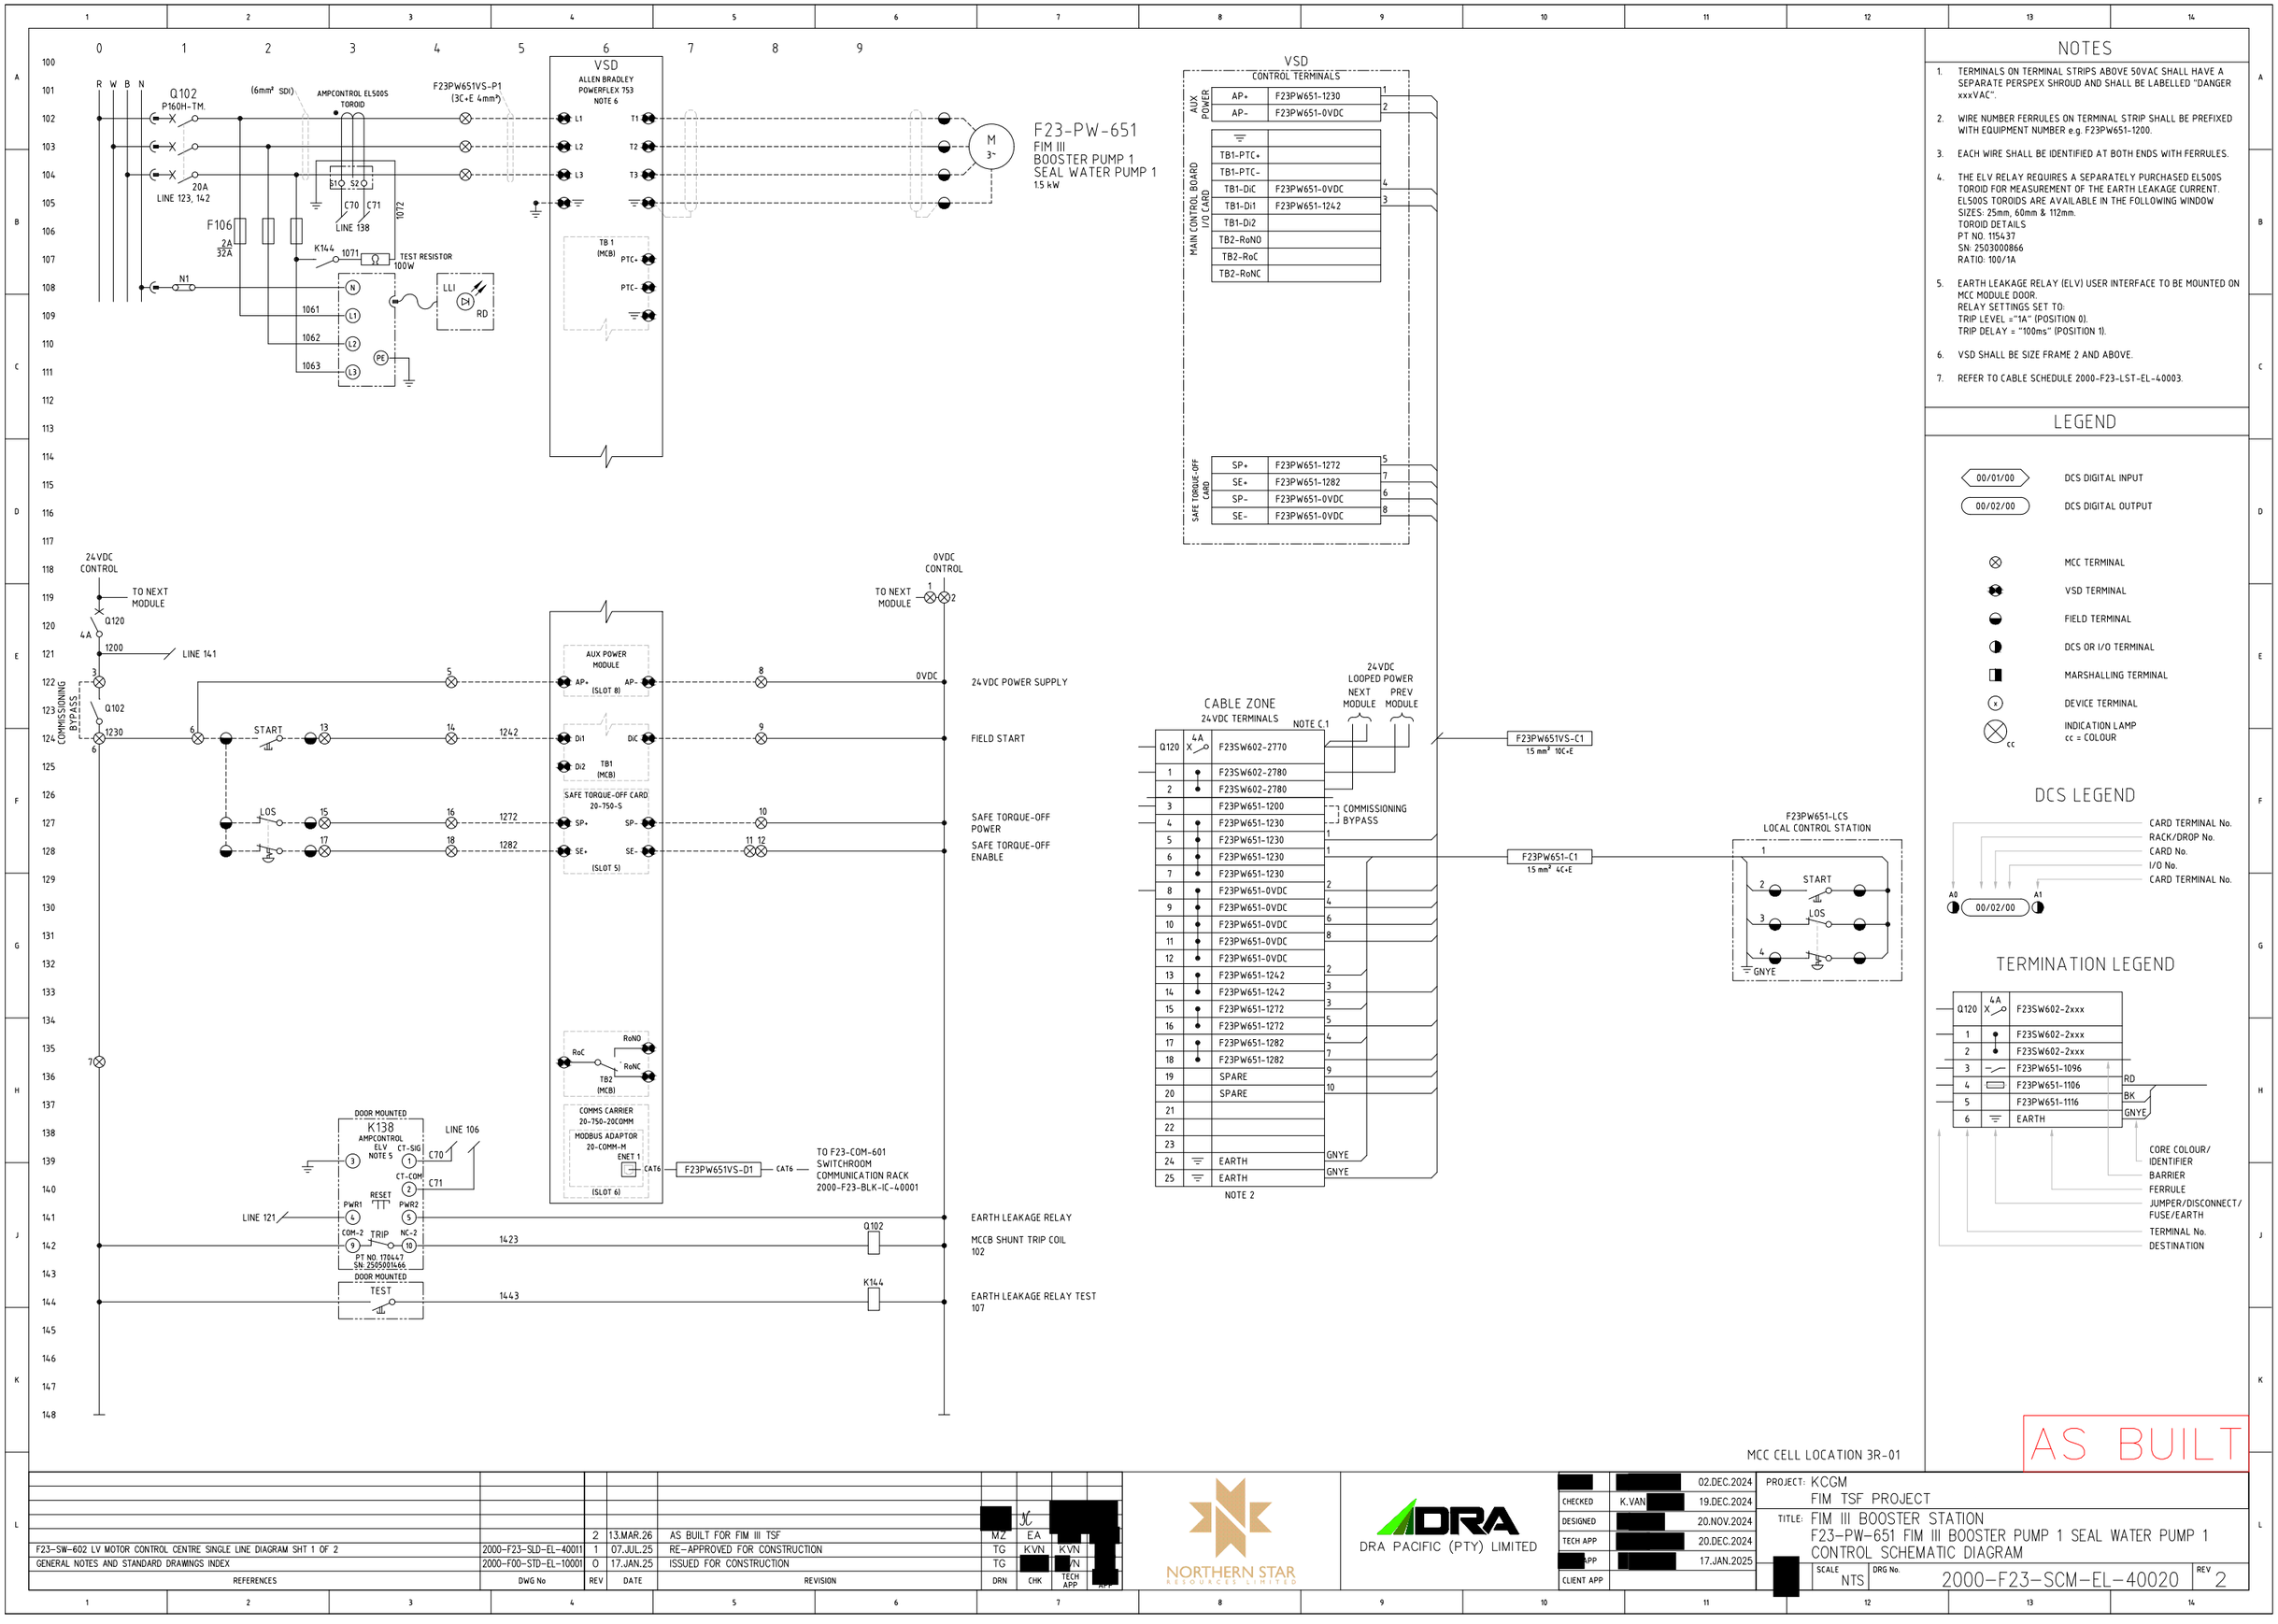

NOTES

1. TERMINALS ON TERMINAL STRIPS ABOVE 50VAC SHALL HAVE A SEPARATE PERSPEX SHROUD AND SHALL BE LABELLED "DANGER xxxVAC".
2. WIRE NUMBER FERRULES ON TERMINAL STRIP SHALL BE PREFIXED WITH EQUIPMENT NUMBER e.g. F23PW651-1200.
3. EACH WIRE SHALL BE IDENTIFIED AT BOTH ENDS WITH FERRULES.
4. THE ELV RELAY REQUIRES A SEPARATELY PURCHASED EL500S TOROID FOR MEASUREMENT OF THE EARTH LEAKAGE CURRENT. EL500S TOROIDS ARE AVAILABLE IN THE FOLLOWING WINDOW SIZES: 25mm, 60mm & 112mm.
   TOROID DETAILS
   PT NO. 115437
   SN: 2503000866
   RATIO: 100/1A
5. EARTH LEAKAGE RELAY (ELV) USER INTERFACE TO BE MOUNTED ON MCC MODULE DOOR.
   RELAY SETTINGS SET TO:
   TRIP LEVEL = "1A" (POSITION 0).
   TRIP DELAY = "100ms" (POSITION 1).
6. VSD SHALL BE SIZE FRAME 2 AND ABOVE.
7. REFER TO CABLE SCHEDULE 2000-F23-LST-EL-40003.

LEGEND

- 00/01/00 — DCS DIGITAL INPUT
- 00/02/00 — DCS DIGITAL OUTPUT
- ⊗ — MCC TERMINAL
- ◓ — VSD TERMINAL
- ◒ — FIELD TERMINAL
- ◑ — DCS OR I/O TERMINAL
- ◧ — MARSHALLING TERMINAL
- (x) — DEVICE TERMINAL
- ⊗ cc — INDICATION LAMP, cc = COLOUR

DCS LEGEND

TERMINATION LEGEND

MCC CELL LOCATION 3R-01

AS BUILT

REFERENCES	DWG No	REV	DATE	REVISION	DRN	CHK	TECH APP	APP
					[redacted]	JC		[redacted]
		2	13.MAR.26	AS BUILT FOR FIM III TSF	MZ	EA	[redacted]	
F23-SW-602 LV MOTOR CONTROL CENTRE SINGLE LINE DIAGRAM SHT 1 OF 2	2000-F23-SLD-EL-40011	1	07.JUL.25	RE-APPROVED FOR CONSTRUCTION	TG	KVN	KVN	
GENERAL NOTES AND STANDARD DRAWINGS INDEX	2000-F00-STD-EL-10001	0	17.JAN.25	ISSUED FOR CONSTRUCTION	TG	[redacted]	VN	

NORTHERN STAR RESOURCES LIMITED

DRA PACIFIC (PTY) LIMITED

[redacted]	[redacted]	02.DEC.2024
CHECKED	K.VAN [redacted]	19.DEC.2024
DESIGNED	[redacted]	20.NOV.2024
TECH APP	[redacted]	20.DEC.2024
[redacted] APP	[redacted]	17.JAN.2025
CLIENT APP		

PROJECT: KCGM
FIM TSF PROJECT

TITLE: FIM III BOOSTER STATION
F23-PW-651 FIM III BOOSTER PUMP 1 SEAL WATER PUMP 1
CONTROL SCHEMATIC DIAGRAM

SCALE NTS | DRG No. 2000-F23-SCM-EL-40020 | REV 2