
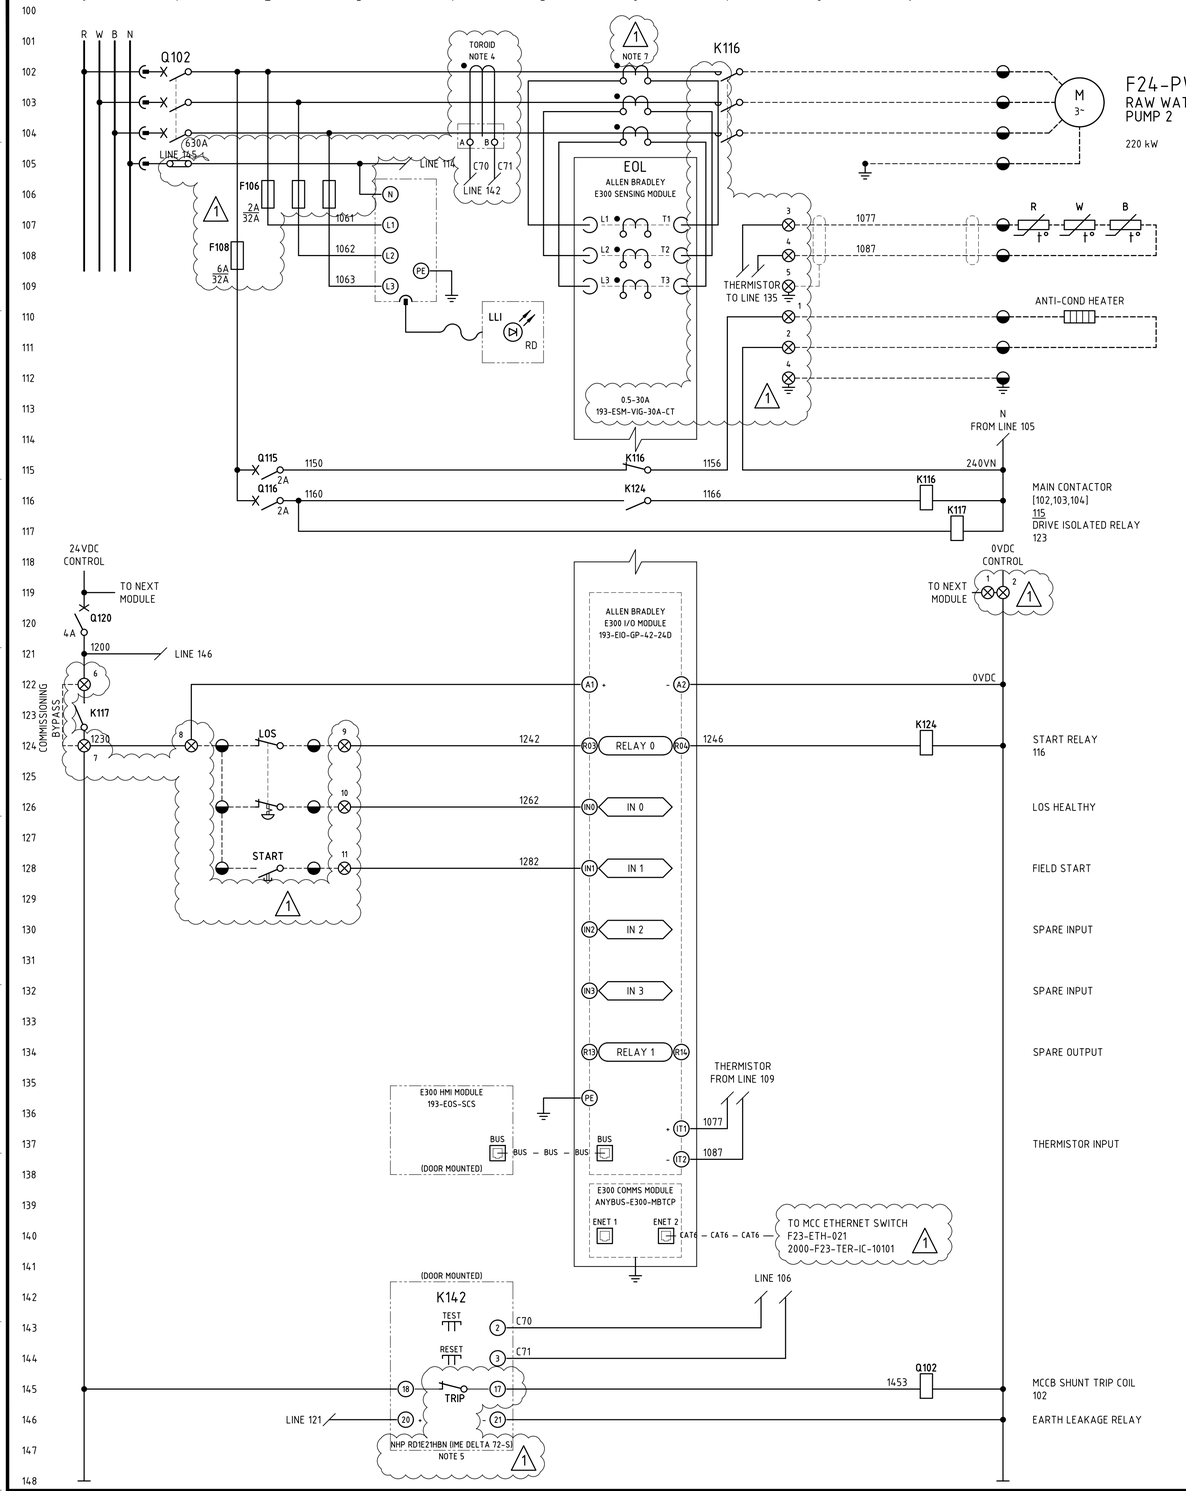


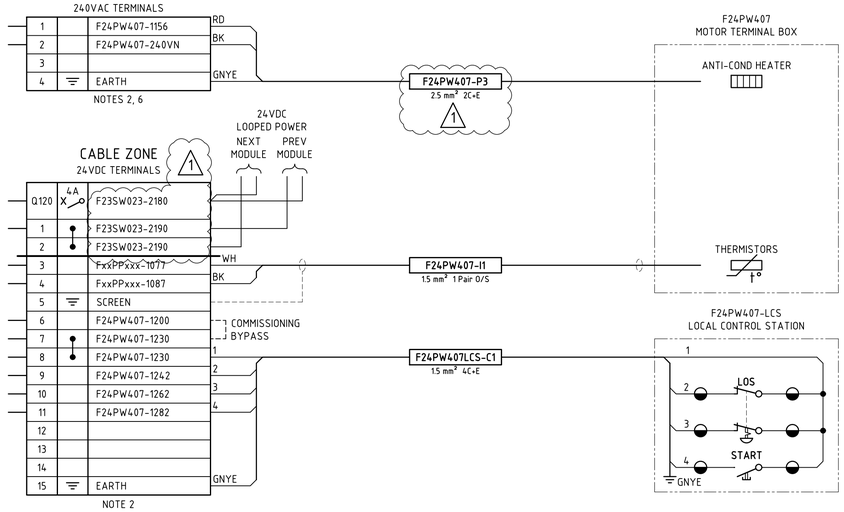

NOTES


1. TERMINALS ON TERMINAL STRIPS ABOVE 50VAC SHALL HAVE A SEPARATE PERSPEX SHROUD AND SHALL BE LABELLED "DANGER xxxVAC".
2. WIRE NUMBER FERRULES ON TERMINAL STRIP SHALL BE PREFIXED WITH EQUIPMENT NUMBER e.g. F24PW407-1200, UNLESS OTHERWISE NOTED. (1)
3. EACH WIRE SHALL BE IDENTIFIED AT BOTH ENDS WITH FERRULES.
4. NHP TDGF2
   IN:400A IΔN MIN:0.3A TOROID TO SUIT CABLE DIAMETER. (1)
5. EARTH LEAKAGE RELAY (ELV) USER INTERFACE TO BE MOUNTED ON MCC MODULE DOOR. RELAY ENERGISED (NORMALLY CLOSED CONTACT OPEN) IN NORMAL OPERATION.
6. 240VAC TERMINALS FOR THE HEATER CIRCUITS SHALL BE LOCATED IN THE MCC DRIVE MODULE.
7. EXTERNAL CURRENT TRANSFORMER RATIO
   RED PHASE: 600/5A
   WHITE PHASE: 600/5A
   BLUE PHASE: 600/5A (1)

LEGEND

- 00/01/00 — DCS DIGITAL INPUT
- 00/02/00 — DCS DIGITAL OUTPUT
- MCC TERMINAL
- VSD TERMINAL
- FIELD TERMINAL
- DCS OR I/O TERMINAL
- MARSHALLING TERMINAL
- DEVICE TERMINAL
- INDICATION LAMP (cc = COLOUR)

(1)

TERMINATION LEGEND

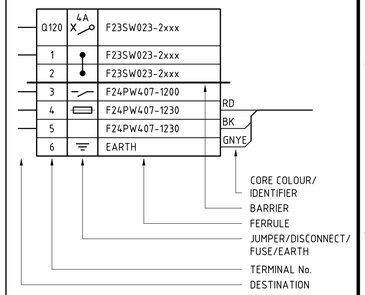

DRG No.	REFERENCES	REV	DATE	DESCRIPTION
2000-F23-SLD-EL-10201	F23-SW-023 415V MCC SINGLE LINE DIAGRAM SHEET 1	1	23SEP25	FAT REDLINES INCORPORATED
2000-F00-STD-EL-10001	GENERAL NOTES AND STANDARD DRAWINGS INDEX	0	25SEP24	APPROVED FOR CONSTRUCTION

DRAW | CHECK | DESIGN | TECH APP | PROJ APP

NORTHERN STAR RESOURCES LIMITED

PRIMERO
primero.com.au | DESIGN | CONSTRUCT | OPERATE

PRIMERO PROJECT NUMBER: 23517

INFORMATION AND REPRESENTATIONS ON THIS DRAWING ARE THE INTELLECTUAL PROPERTY OF PRIMERO UNLESS SPECIFICALLY IDENTIFIED OTHERWISE. ALL RIGHTS INCLUDING USE RESERVED

PROJECT: NORTHERN STAR RESOURCES LTD
KCGM GROWTH PROJECT

TITLE: AIR & WATER SERVICES - F23-SW-023
F24-PW-407 RAW WATER PUMP 2
SCHEMATIC AND TERMINATION DIAGRAM

SHEET	SCALE	DRG No.	REVISION
A1	NONE	2000-F24-SCM-EL-10402	1

O:\CAD PROJECTS\235 NORTHERN STAR RESOURCES LTD\23517 KCGM GROWTH PROJECT\03 DELIVERABLES\ELV\F24 - AIR & WATER SERVICES\2000-F24-SCM-EL-10402.DWG 02OCT25 9:05AM HOTSEAT04