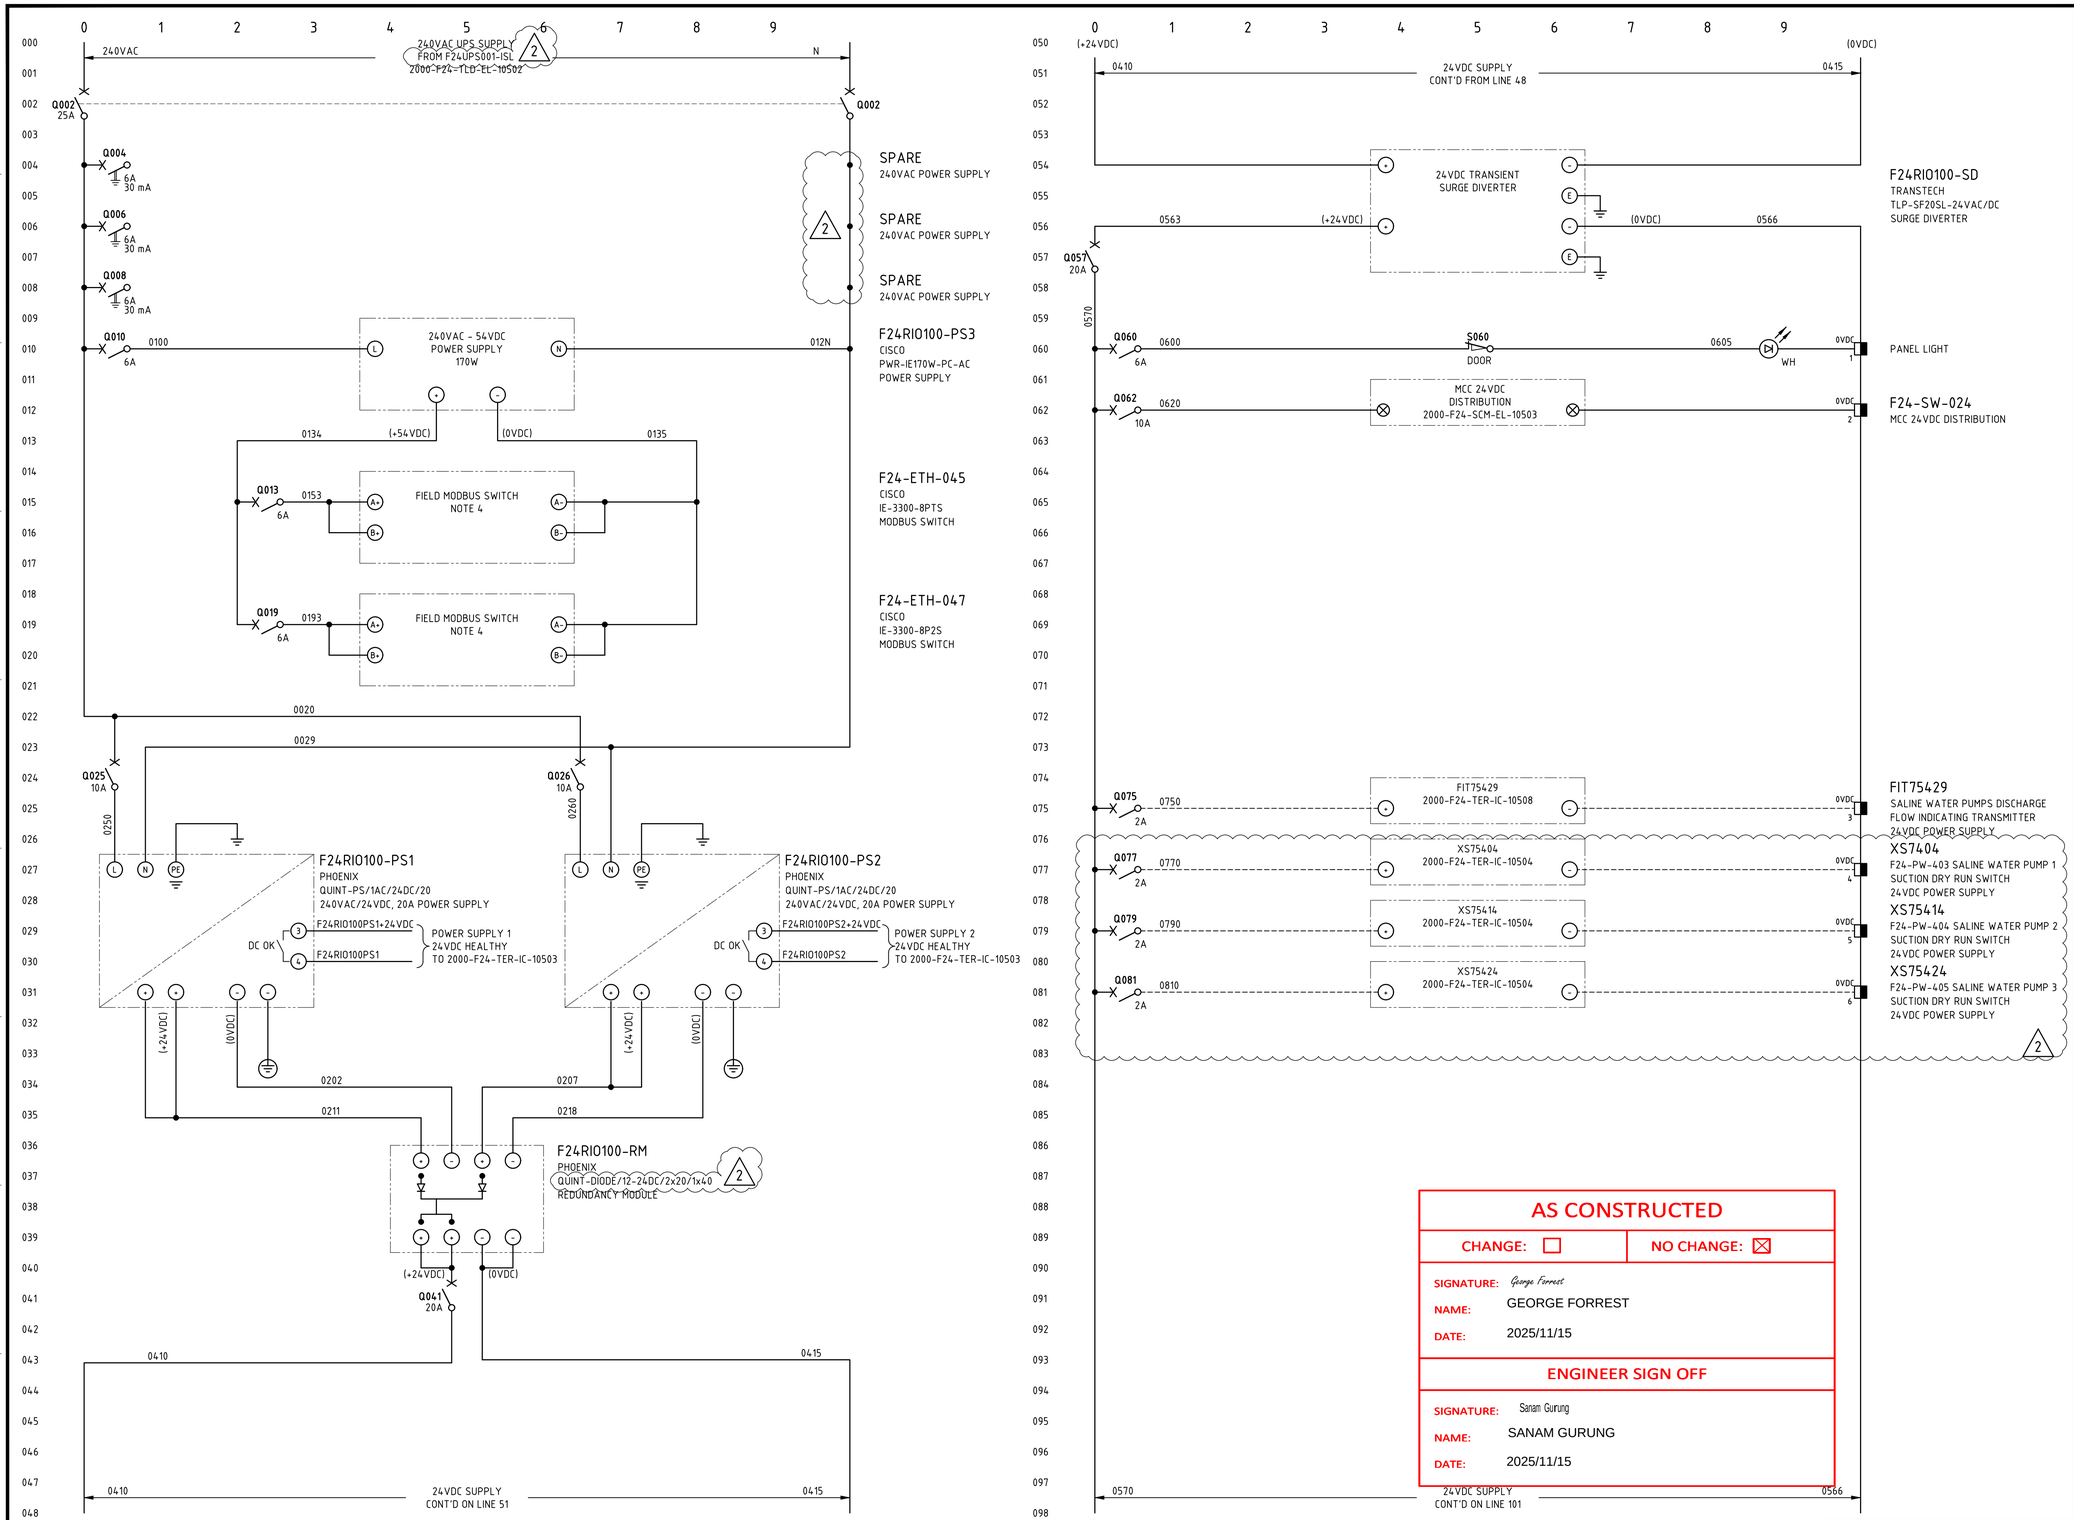


NOTES

1. TERMINALS ON TERMINAL STRIPS ABOVE 50VAC SHALL HAVE A SEPARATE PERSPEX SHROUD AND SHALL BE LABELLED "DANGER xxxVAC".
2. WIRE NUMBER FERRULES ON TERMINAL STRIP SHALL BE PREFIXED WITH EQUIPMENT NUMBER e.g. F24RIO100-xxxx.
3. EACH WIRE SHALL BE IDENTIFIED AT BOTH ENDS WITH FERRULES.
4. FOR NETWORK CONNECTION & BUS CABLING DETAILS REFER TO: MCC COMMUNICATIONS TERMINATION DIAGRAMS.
5. INSTRUMENT EARTH BAR TO BE BONDED TO MAIN EARTH BAR WITH SOLID COPPER LINK.

LEGEND

- FIELD TERMINAL
- DCS OR I/O TERMINAL
- 0VDC TERMINAL FOR 24VDC
- 0VDC TERMINAL FOR 54VDC
- DEVICE TERMINAL
- INDICATION LAMP (cc = COLOUR)
- EARTH BAR
- INSTRUMENT EARTH BAR

AS CONSTRUCTED

CHANGE: ☐ NO CHANGE: ☒

SIGNATURE: George Forrest
NAME: GEORGE FORREST
DATE: 2025/11/15

ENGINEER SIGN OFF

SIGNATURE: Sanam Gurung
NAME: SANAM GURUNG
DATE: 2025/11/15

DRG No.	REFERENCES	REV	DATE	DESCRIPTION	DRAW	CHECK	DESIGN	TECH APP	PROJ APP
2000-F24-DRG-IC-10501	F24-SW-024 MCC N-IO AND COMMS PANEL GENERAL ARRANGEMENT								
2000-F24-SCM-IC-10502	F24-SW-024 MCC N-IO AND COMMS PANEL SCHEMATIC DIAGRAM SHEET 2	2RL1	15NOV25	AS CONSTRUCTED FOR SUBSYSTEM F24.50.09 FOR SP1				MK	
2000-F24-TER-IC-10501	F24-SW-024 MCC N-IO AND COMMS PANEL COMMUNICATIONS TERMINATION DIAGRAM SHEET 1	2	09SEP25	FAT REDLINES INCORPORATED					
2000-F24-TER-IC-10503	F24-SW-024 MCC N-IO AND COMMS PANEL TERMINATION DIAGRAM (TO SHEET 6 - 10508)	1	03FEB25	MCC 24VDC DISTRIBUTION MOVED.					
2000-F00-STD-EL-10001	GENERAL NOTES AND STANDARD DRAWINGS INDEX	0	12NOV24	APPROVED FOR CONSTRUCTION					

NORTHERN STAR RESOURCES LIMITED

PRIMERO
primero.com.au | DESIGN | CONSTRUCT | OPERATE

PRIMERO PROJECT NUMBER: 23517

INFORMATION AND REPRESENTATIONS ON THIS DRAWING ARE THE INTELLECTUAL PROPERTY OF PRIMERO UNLESS SPECIFICALLY IDENTIFIED OTHERWISE. ALL RIGHTS INCLUDING USE RESERVED

PROJECT: NORTHERN STAR RESOURCES LTD KCGM GROWTH PROJECT

TITLE: AIR & WATER SERVICES - SALINE WATER F24-SW-024 MCC N-IO AND COMMS PANEL SCHEMATIC DIAGRAM SHEET 1

SHEET	SCALE	DRG No.	REVISION
A1	NONE	2000-F24-SCM-IC-10501	2RL1

O:\CAD PROJECTS\235 NORTHERN STAR RESOURCES LTD\23517 KCGM GROWTH PROJECT\03 DELIVERABLES\IC\F24 - AIR & WATER SERVICES\2000-F24-SCM-IC-10501.DWG 16SEP25 4:04PM HOTSEAT04