


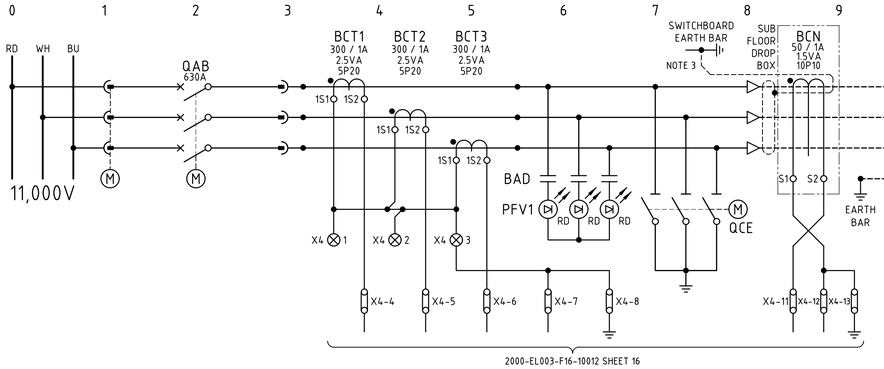


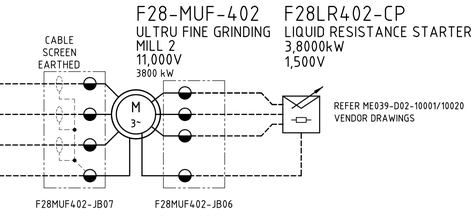

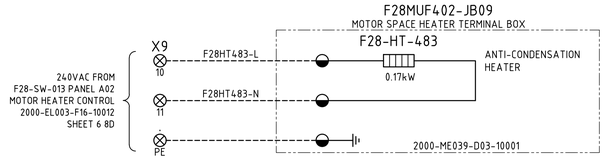

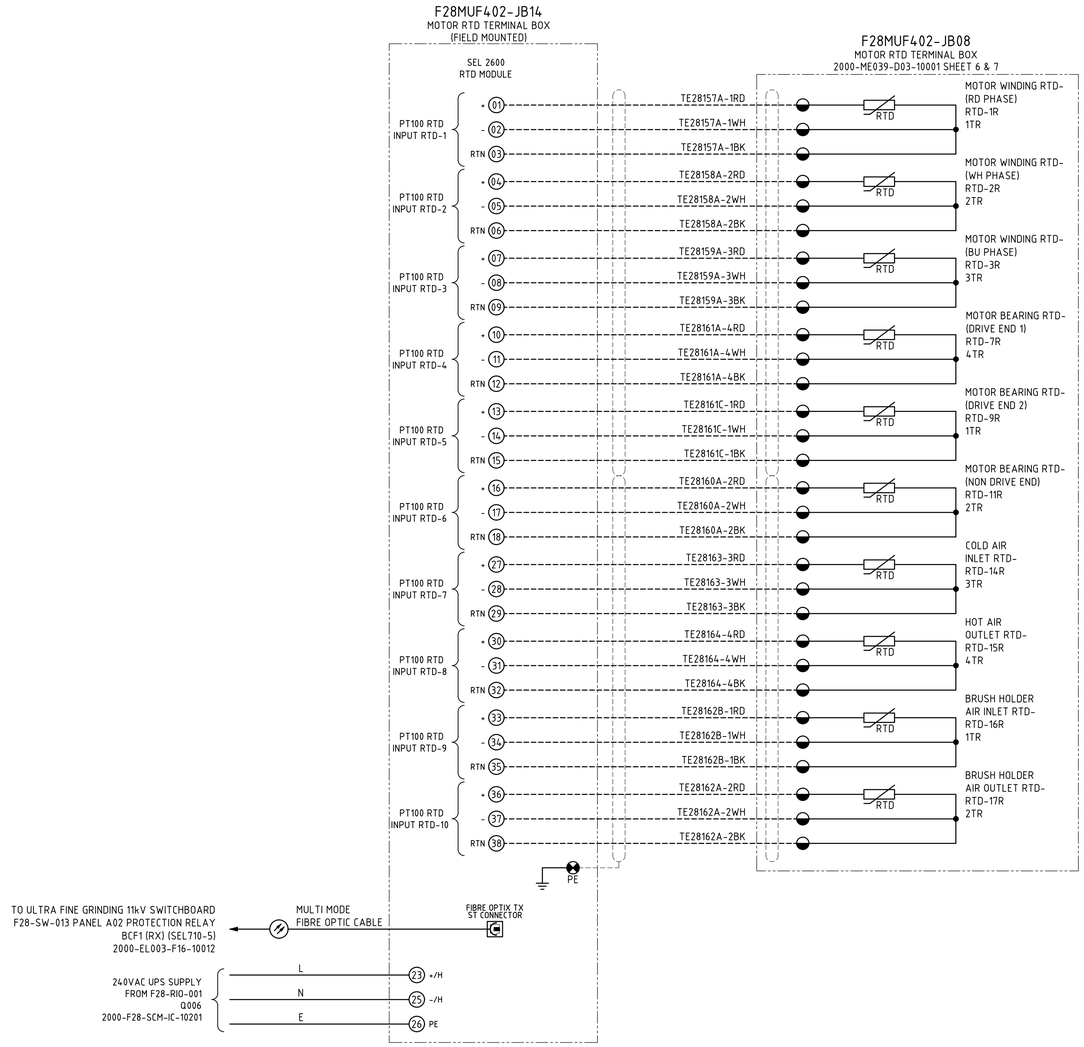

NOTES

1. WIRE NUMBER FERRULES ON TERMINAL STRIP SHALL BE PREFIXED WITH EQUIPMENT NUMBER e.g. F28MUF402-1200, UNLESS OTHERWISE NOTED.
2. EACH WIRE SHALL BE IDENTIFIED AT BOTH ENDS WITH FERRULES.
3. IF THE CABLE SCREENS PASS THROUGH CORE BALANCE CT BEFORE BREAKING OUT THEN THE SCREEN EARTHS MUST BE BOUGHT BACK THROUGH THE CORE BALANCE CT AND TERMINATED TO EARTH.

LEGEND

- ⊗ 11kV SWITCHBOARD TERMINAL
- VSD TERMINAL
- FIELD TERMINAL
- DCS OR I/O TERMINAL
- MARSHALLING TERMINAL
- (x) DEVICE TERMINAL

PANEL A02

DRG No.	REFERENCES	REV	DATE	DESCRIPTION	DRAW	CHECK	DESIGN	TECH APP	PROJ APP
2000-EL003-F16-10012	F28-SW-013 ABB SCHEMATIC DIAGRAM								
2000-F28-TER-EL-10103	F28-SW-013 11kV SWITCHBOARD - PANEL A02 (F28-MUF-402) TERMINATION DIAGRAM SHEET 1	2	02OCT26	KCGM GROWTH PROJECT - SP1 AS-BUILT					
2000-F28-SLD-EL-10001	F28-SW-013 11kV SWITCHBOARD SINGLE LINE DIAGRAM SHEET 1	1	05SEP25	FAT REDLINES INCORPORATED - NO CHANGE					
2000-F00-STD-EL-10001	GENERAL NOTES AND STANDARD DRAWINGS INDEX	0	20MAR25	APPROVED FOR CONSTRUCTION					

NORTHERN STAR RESOURCES LIMITED

INFORMATION AND REPRESENTATIONS ON THIS DRAWING ARE THE INTELLECTUAL PROPERTY OF PRIMERO UNLESS SPECIFICALLY IDENTIFIED OTHERWISE. ALL RIGHTS INCLUDING USE RESERVED

PRIMERO
primero.com.au | DESIGN | CONSTRUCT | OPERATE

PRIMERO PROJECT NUMBER: 23517

PROJECT: NORTHERN STAR RESOURCES LTD
KCGM GROWTH PROJECT

TITLE: ULTRA FINE GRINDING 2/3 F28-SW-013
F28-MUF-402 ULTRA FINE GRINDING MILL 2
SCHEMATIC DIAGRAM SHEET 1

SHEET	SCALE	DRG No.	REVISION
A1	NONE	2000-F28-SCM-EL-10103	2

O:\CAD PROJECTS\235 NORTHERN STAR RESOURCES LTD\23517 KCGM GROWTH PROJECT\03 DELIVERABLES\E\LF28 - ULTRAFINE GRINDING 2 & 3\2000-F28-SCM-EL-10103.DWG 25SEP26 1:03PM ROBINLAW